

WILLIAM J CLINTON
PRESIDENTIAL
CENTER

LITTLE ROCK, ARKANSAS

Architect
POLSHEK PARTNERSHIP LLP
320 West 13th Street
New York, New York 10014
212 607 7171

Coordinating Architects
POLK STANLEY YEARY ARCHITECTS LTD
700 South Schiller Street
Little Rock, Arkansas 72201
501 378 0878

WITSELL EVANS RASCO
901 West Third Street
Little Rock, Arkansas 72201
501 374.5300

WOODS CARADINE ARCHITECTS
2200 South Main Street
Little Rock, Arkansas 72206
501 374 4060

Landscape Architects
HARGREAVES ASSOCIATES
118 Magazine Street
Cambridge, Massachusetts 02139
617 861 0070


LANDSCAPE ARCHITECTURE, Inc.
2300 Cottondale Lane Suite 202
Little Rock, Arkansas 72202
501 374 5810

Structural Engineer
LESLIE E ROBERTSON ASSOC. RLLP
30 Broad Street, 47th Floor
New York, New York 10004
212 750 9000


MEP Engineers
FLACK + KURTZ Inc.
475 Fifth Avenue
New York, New York 10017
212 532 9600

CROMWELL ARCHITECTS ENGINEERS
101 South Spring Street
Little Rock, Arkansas 72201
501 372 2900

Curtainwall Consultant
R A HEINTGES ARCHITECTS
126 Fifth Avenue 9th Floor
New York, New York 10011
212 652-2968

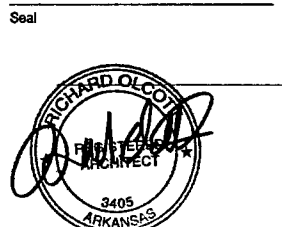

100% Construction Documents	09/27/02
90% Progress Printing	08/30/02
100% Struct./CD Progress	07/01/02
100% Design Development	03/01/02
Issue	Date
*Originally issued as A330	

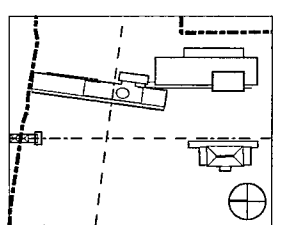

Job No. 9908
Scale AS NOTED
Date September 27, 2002
Title


WALL SYSTEM C
SECTION AND
DEVELOPED RCP

Sheet No.

A331


DETAILS/DTL-CW/C6

FOR OFFICIAL USE ONLY

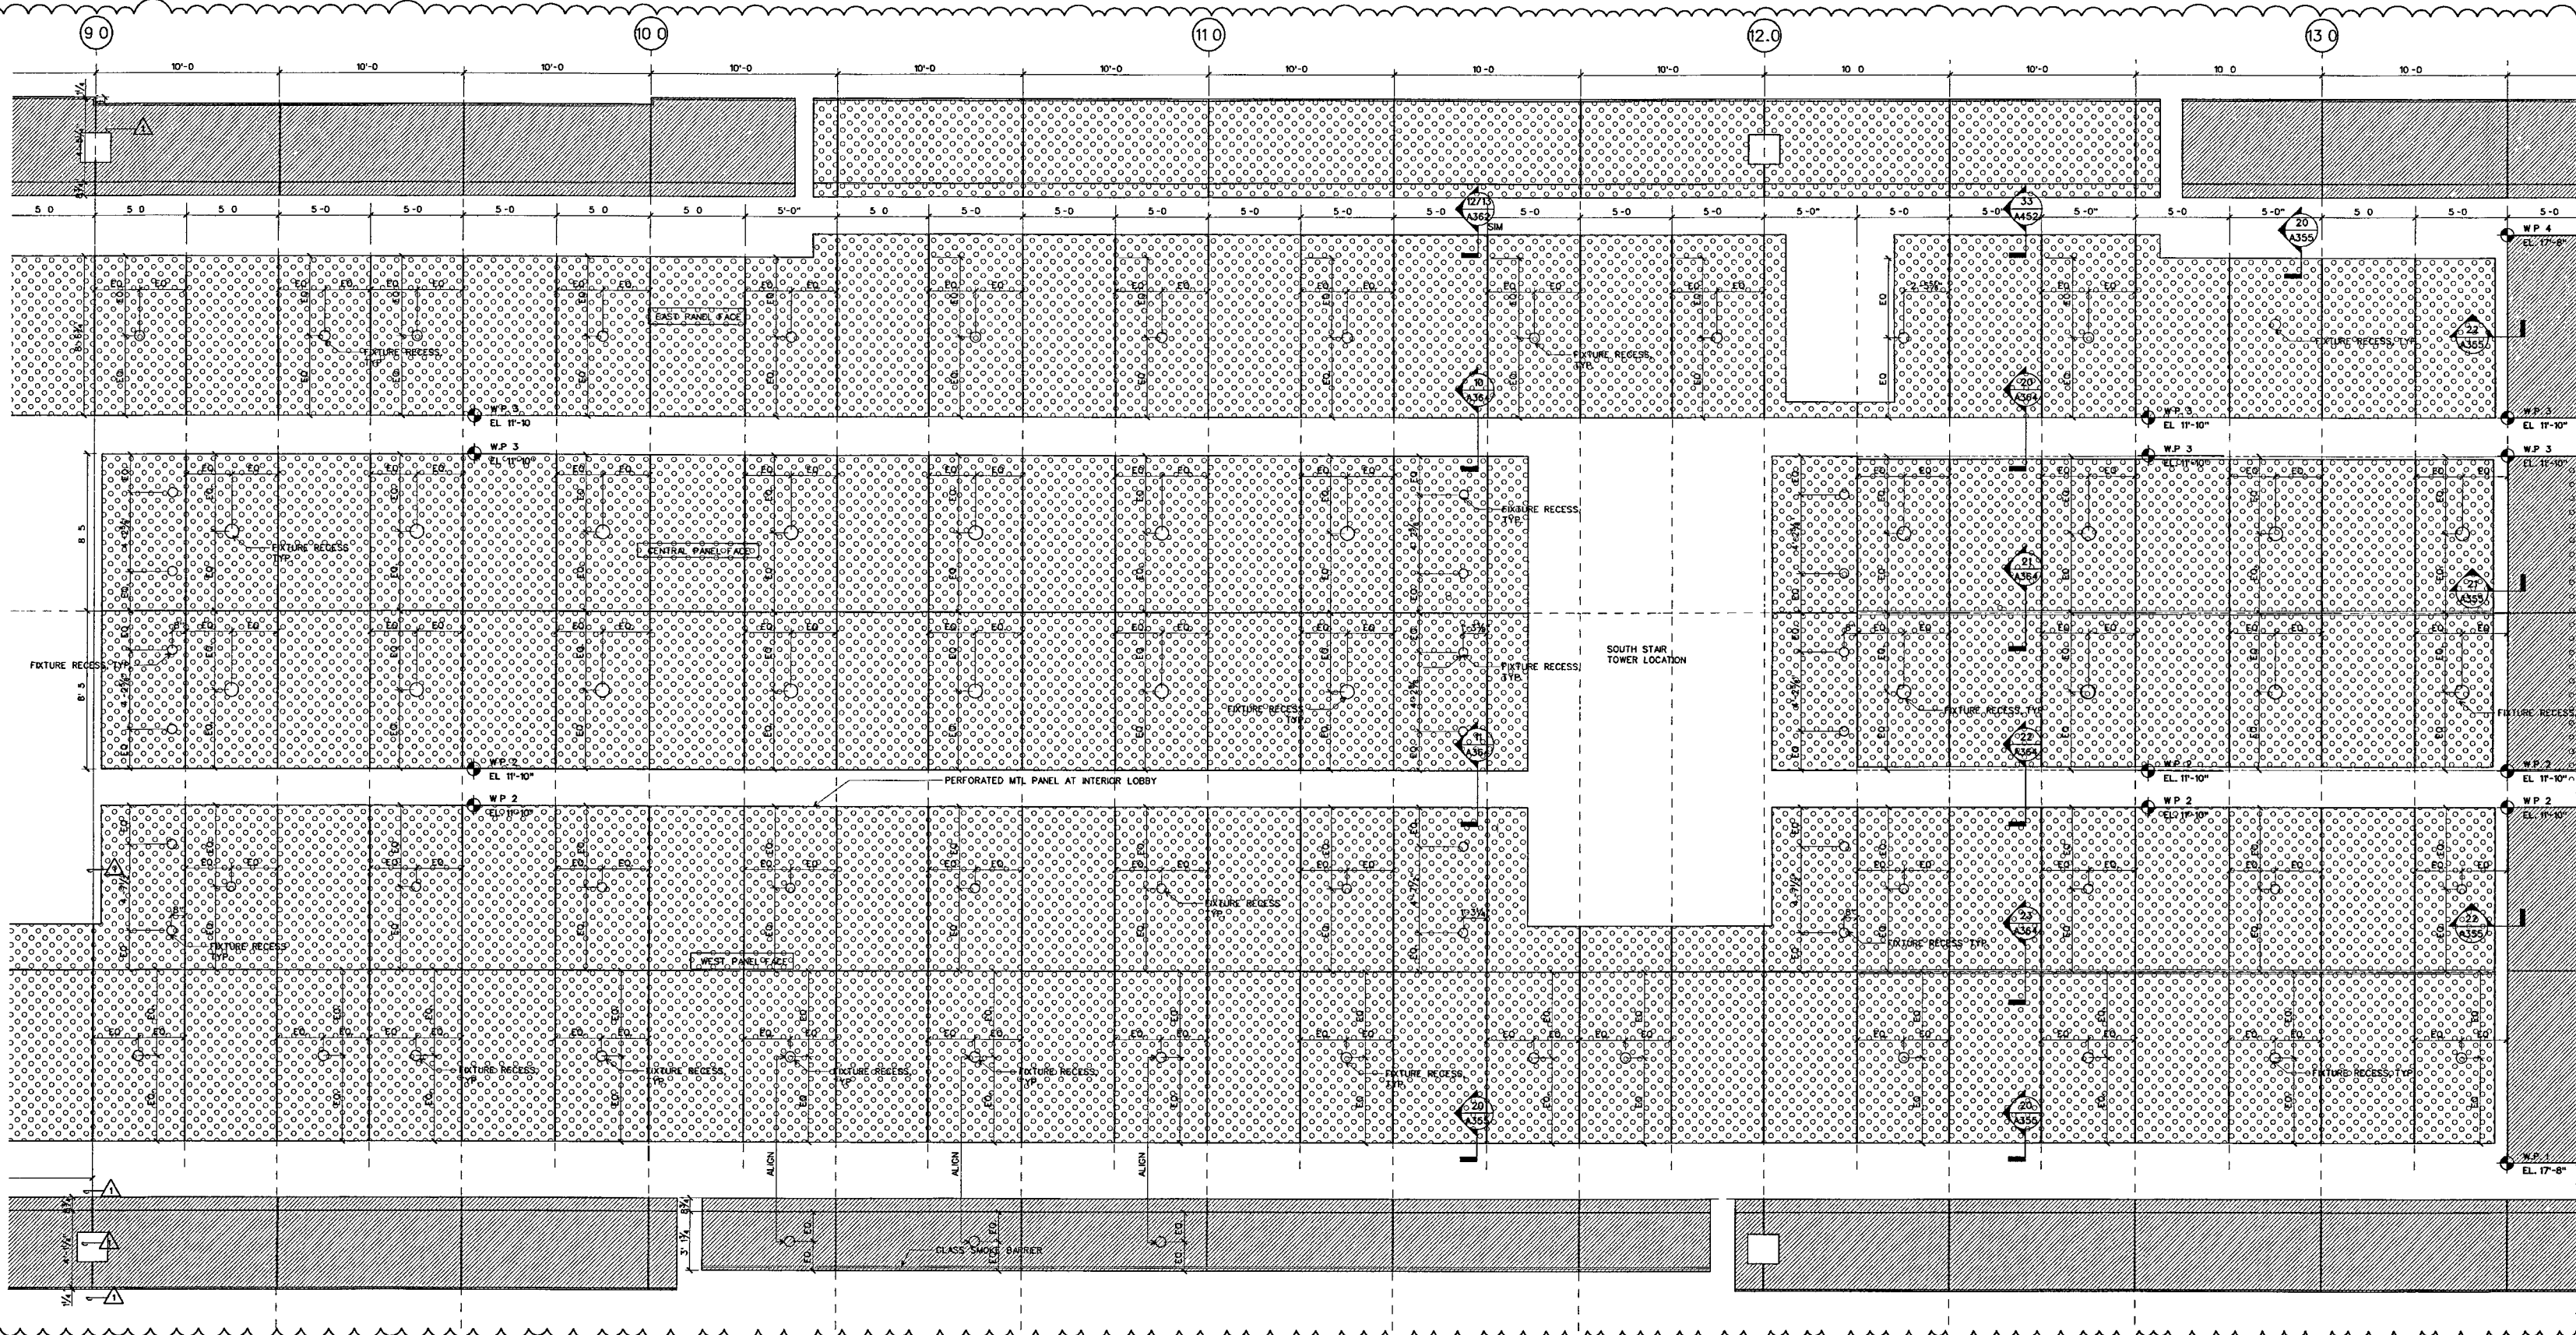

WALL SYSTEM C: DEVELOPED UNDERSIDE PLAN AT LOBBY

SCALE 1/4" = 1'-0"

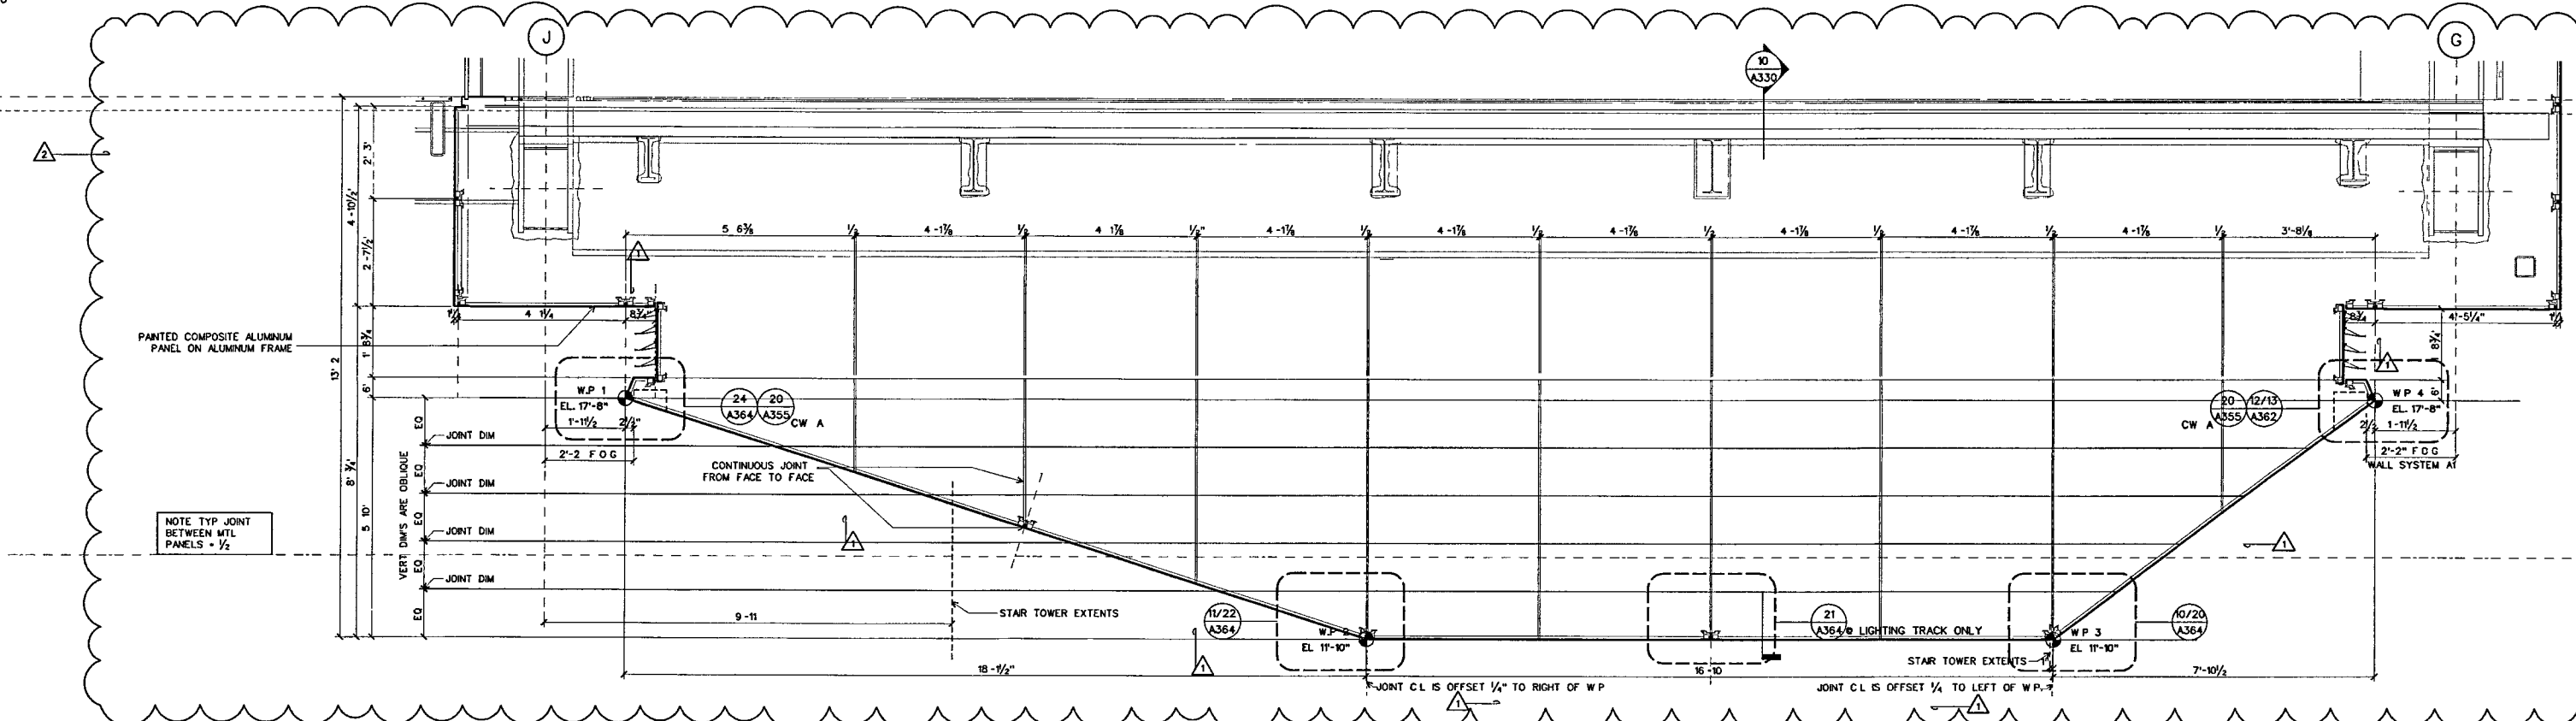

WALL SYSTEM C TRANSVERSE SECTION/ELEVATION SHOWING JOINT DIVISIONS AND GEOMETRY

SCALE 1/2" = 1'-0"

DETAILS/DTL-CW/C6

FOR OFFICIAL USE ONLY