

**WILLIAM J. CLINTON  
PRESIDENTIAL  
CENTER**

LITTLE ROCK, ARKANSAS

Architect  
POLSHEK PARTNERSHIP LLP  
520 West 18th Street  
New York, New York 10014  
212.807.7171

Coordinating Architects  
POLK STANLEY YEARY ARCHITECTS LTD  
700 South Schiller Street  
Little Rock, Arkansas 72201  
501.378.0878

WITSELL EVANS & RASCO  
901 West Third Street  
Little Rock, Arkansas 72201  
501.374.5300

WOODS CARADINE ARCHITECTS  
2200 South Main Street  
Little Rock, Arkansas 72206  
501.374.4090

Landscape Architects  
HARGREAVES ASSOCIATES  
118 Magazine Street  
Cambridge, Massachusetts 02139  
617.861.0070

LANDSCAPE ARCHITECTURE, Inc.  
2000 Cordelia Lane Suite 202  
Little Rock, Arkansas 72202  
501.374.5610

Structural Engineer  
LESLIE E. ROBERTSON ASSOC., RLLP  
30 Broad Street, 4th Floor  
New York, New York 10017  
212.750.9000

MEP Engineers  
FLACK + KURTZ Inc.  
475 Fifth Avenue  
New York, New York 10017  
212.532.9600


CHAMWELL ARCHITECTS ENGINEERS  
101 South Byring Street  
Little Rock, Arkansas 72201  
501.372.2900

Curtainwall Consultant  
R.A. HEINTGES ARCHITECTS  
128 Fifth Avenue, 9th Floor  
New York, New York 10011  
212.652.2968

Seal



△ Addendum #4	11/22/02
△ Addendum #1	11/15/02
△ Addendum #2	10/23/02
100% Construction Documents	09/27/02
90% Progress Printing	08/30/02
100% Struct/CD Progress	07/01/02
100% Steel & Concrete CD	05/15/02
100% Design Development	03/01/02
Issue	Date

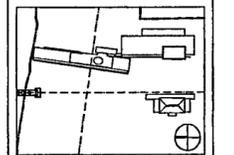

Job No. PPA 0908  
P67-485D

Scale 1/2" = 1'-0"


Date September 27, 2002

Title **WALL SYSTEM F:  
PLANS, ELEVATION  
AND SECTIONS**

Sheet No

**A338**


FOR OFFICIAL USE ONLY

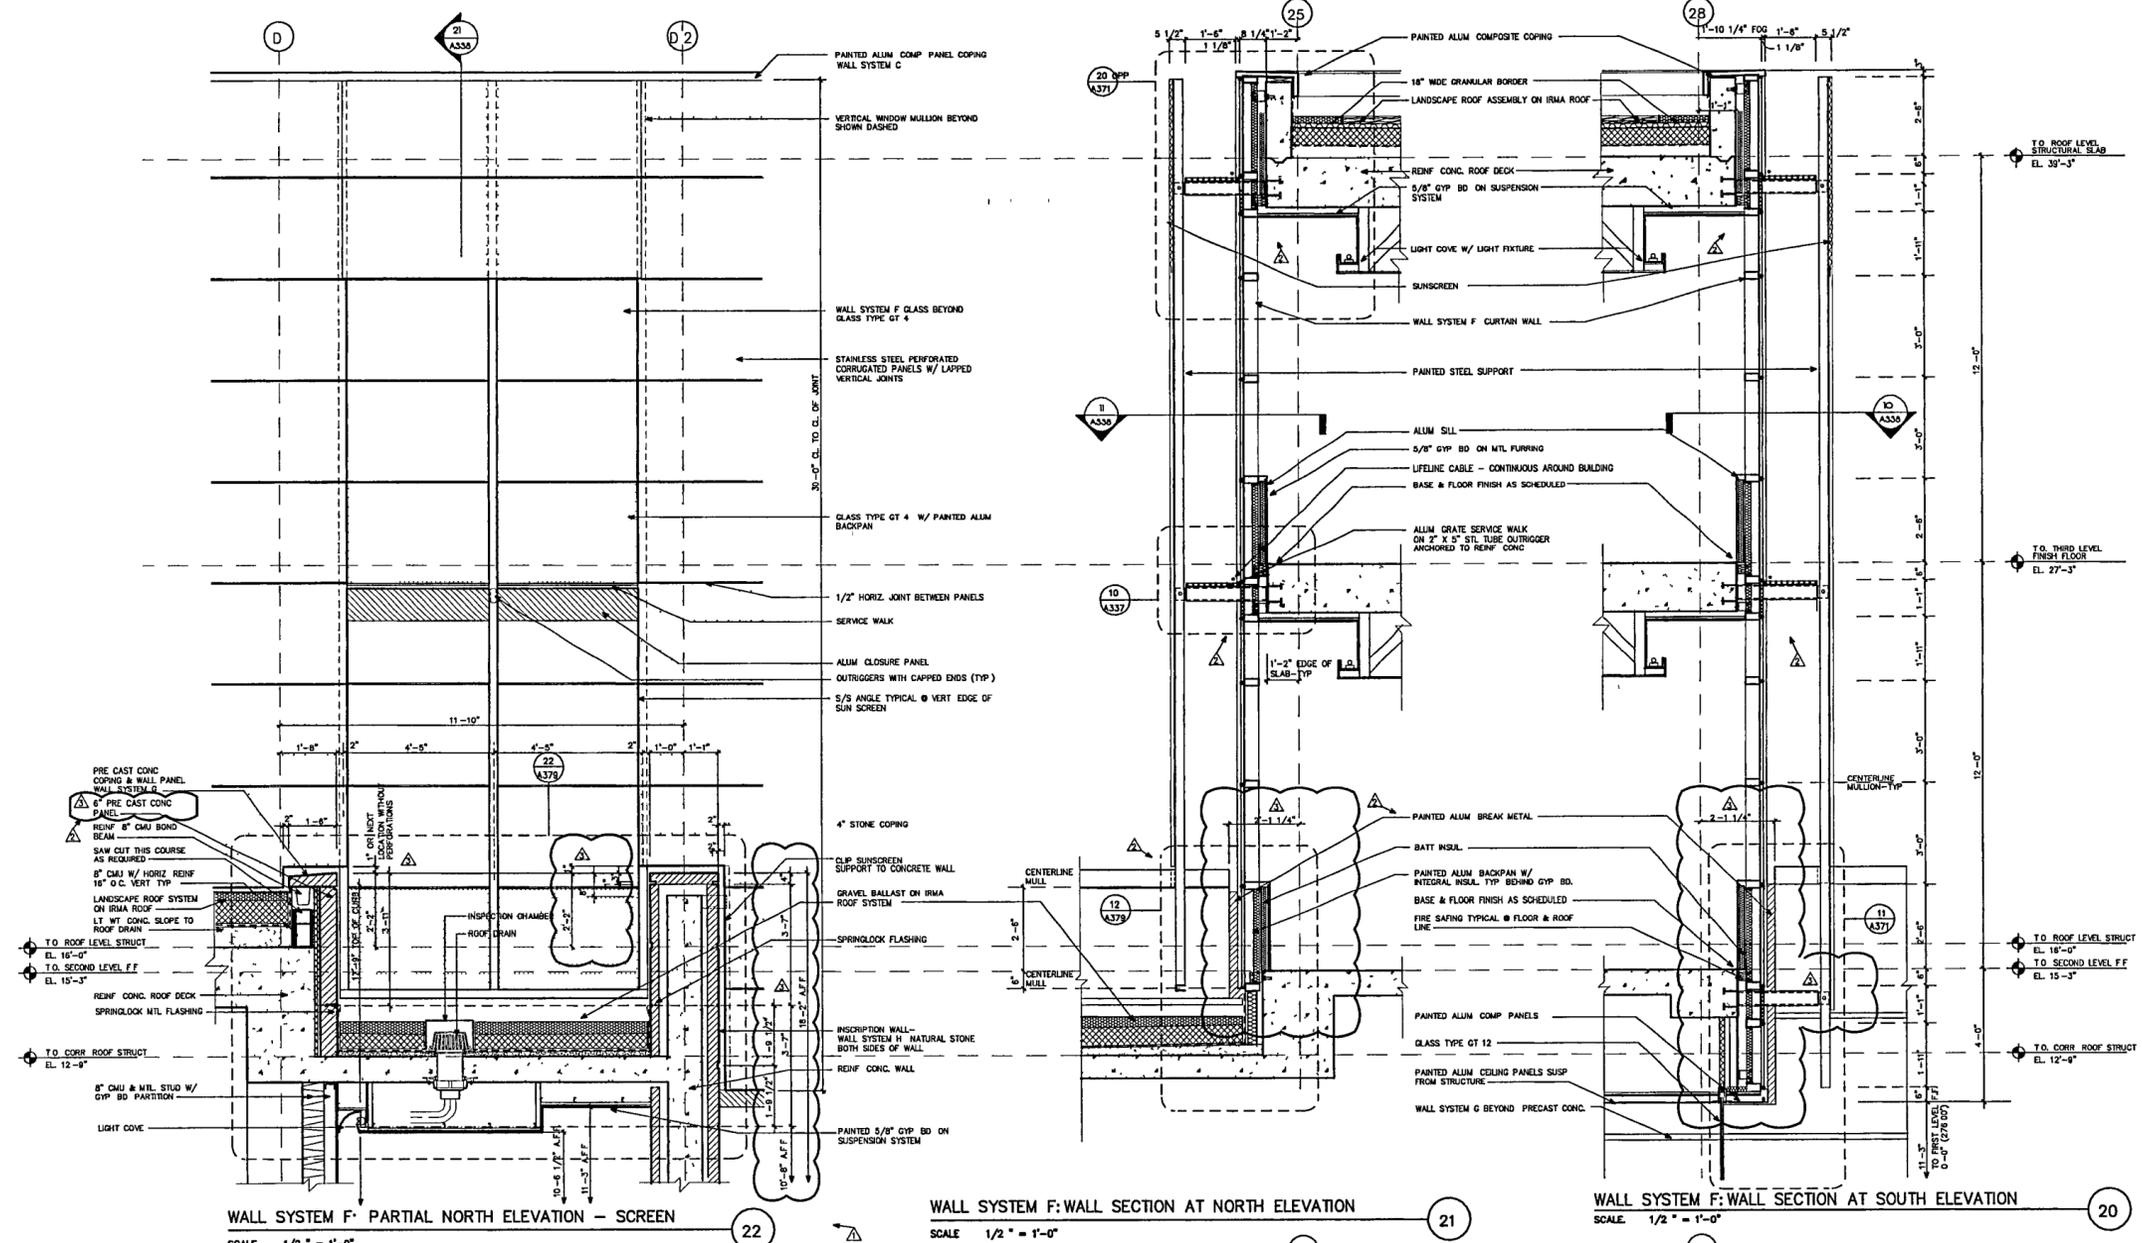


WALL SYSTEM F: PARTIAL NORTH ELEVATION - SCREEN  
SCALE: 1/2" = 1'-0"

WALL SYSTEM F: WALL SECTION AT NORTH ELEVATION  
SCALE: 1/2" = 1'-0"


WALL SYSTEM F: WALL SECTION AT SOUTH ELEVATION  
SCALE: 1/2" = 1'-0"

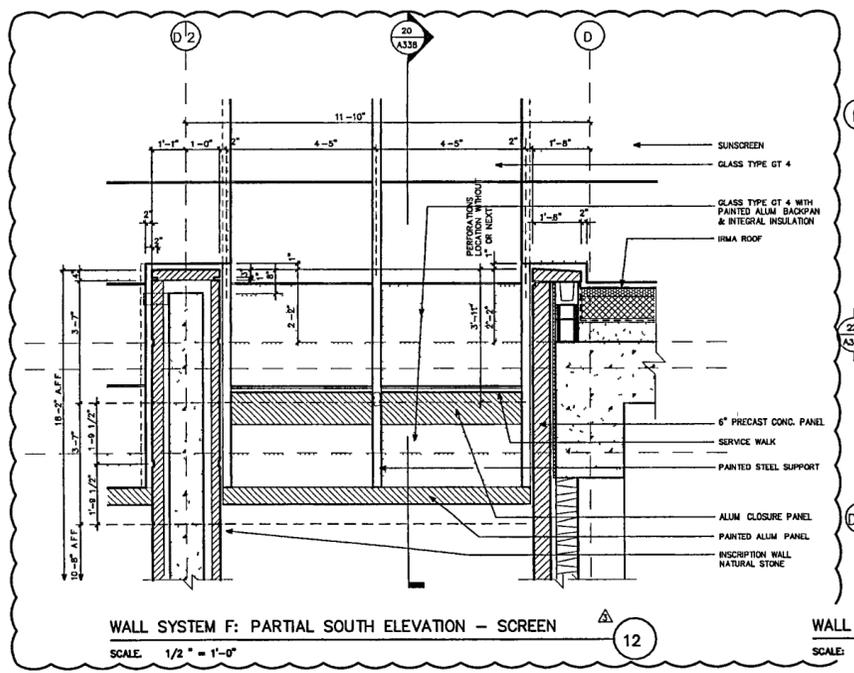

WALL SYSTEM F: PARTIAL SOUTH ELEVATION - SCREEN  
SCALE: 1/2" = 1'-0"

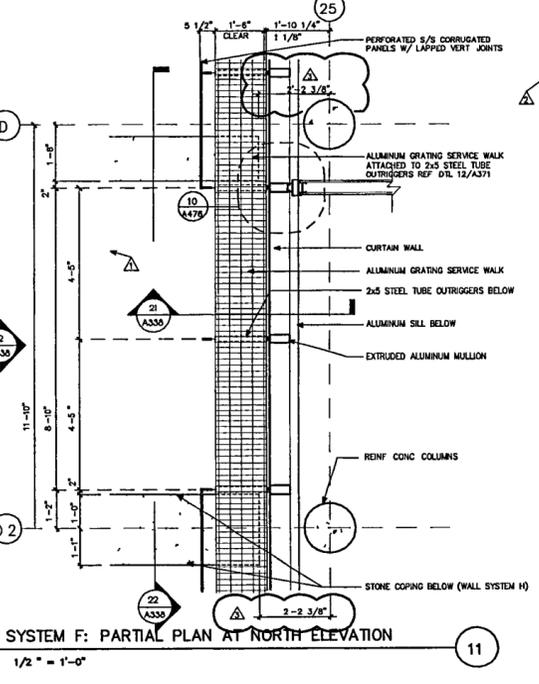

WALL SYSTEM F: PARTIAL PLAN AT NORTH ELEVATION  
SCALE: 1/2" = 1'-0"

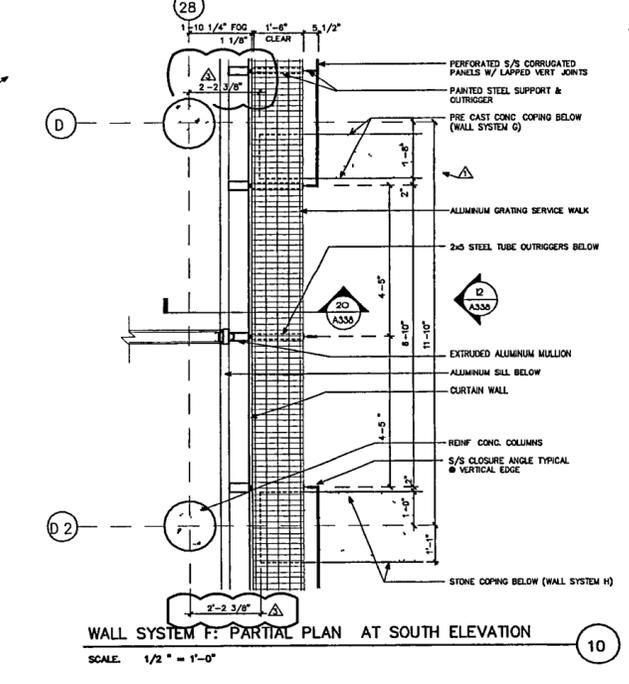

WALL SYSTEM F: PARTIAL PLAN AT SOUTH ELEVATION  
SCALE: 1/2" = 1'-0"