

**WILLIAM J CLINTON
PRESIDENTIAL
CENTER**

LITTLE ROCK, ARKANSAS

Architect
POLSHEK PARTNERSHIP LLP
320 West 13th Street
New York, New York 10014
212.607.7171

Coordinating Architects
POLK STANLEY YEARY ARCHITECTS Ltd
700 South Schiller Street
Little Rock, Arkansas 72201
501.378.0878

WITSELL EVANS RASCO
801 West Third Street
Little Rock, Arkansas 72201
501.374.5300

WOODS CARADINE ARCHITECTS
2200 South Main Street
Little Rock, Arkansas 72208
501.374.4060

Landscape Architects
HARGREAVES ASSOCIATES
118 Magazine Street
Cambridge, Massachusetts 02139
617.661.0070

LANDSCAPE ARCHITECTURE, Inc.
2300 Cottondale Lane Suite 202
Little Rock, Arkansas 72202
501.374.5510

Structural Engineer
LESLIE E. ROBERTSON ASSOC., RLLP
30 Broad Street, 47th Floor
New York, New York 10004
212.750.9000


MEP Engineers
FLACK + KURTZ Inc
475 Fifth Avenue
New York, New York 10017
212.532.9600

CROMMELL ARCHITECTS ENGINEERS
101 South Spring Street
Little Rock, Arkansas 72201
501.372.2900

Curtainwall Consultant
R. A. HEINTGES ARCHITECTS
128 Fifth Avenue, 9th Floor
New York, New York 10011
212.652-2968




100% Construction Documents	09/27/02
100% Struct./CD Progress	07/01/02
Bridge Bldg Substructure	06/14/02
Issue	Date

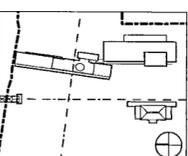

Job No: 9908
Scale: 1/2" = 1'-0"
Date: September 27, 2002
Title:


**WALL SYSTEM G
PLAN, ELEVATION AND
SECTIONS**

Sheet No
A339a

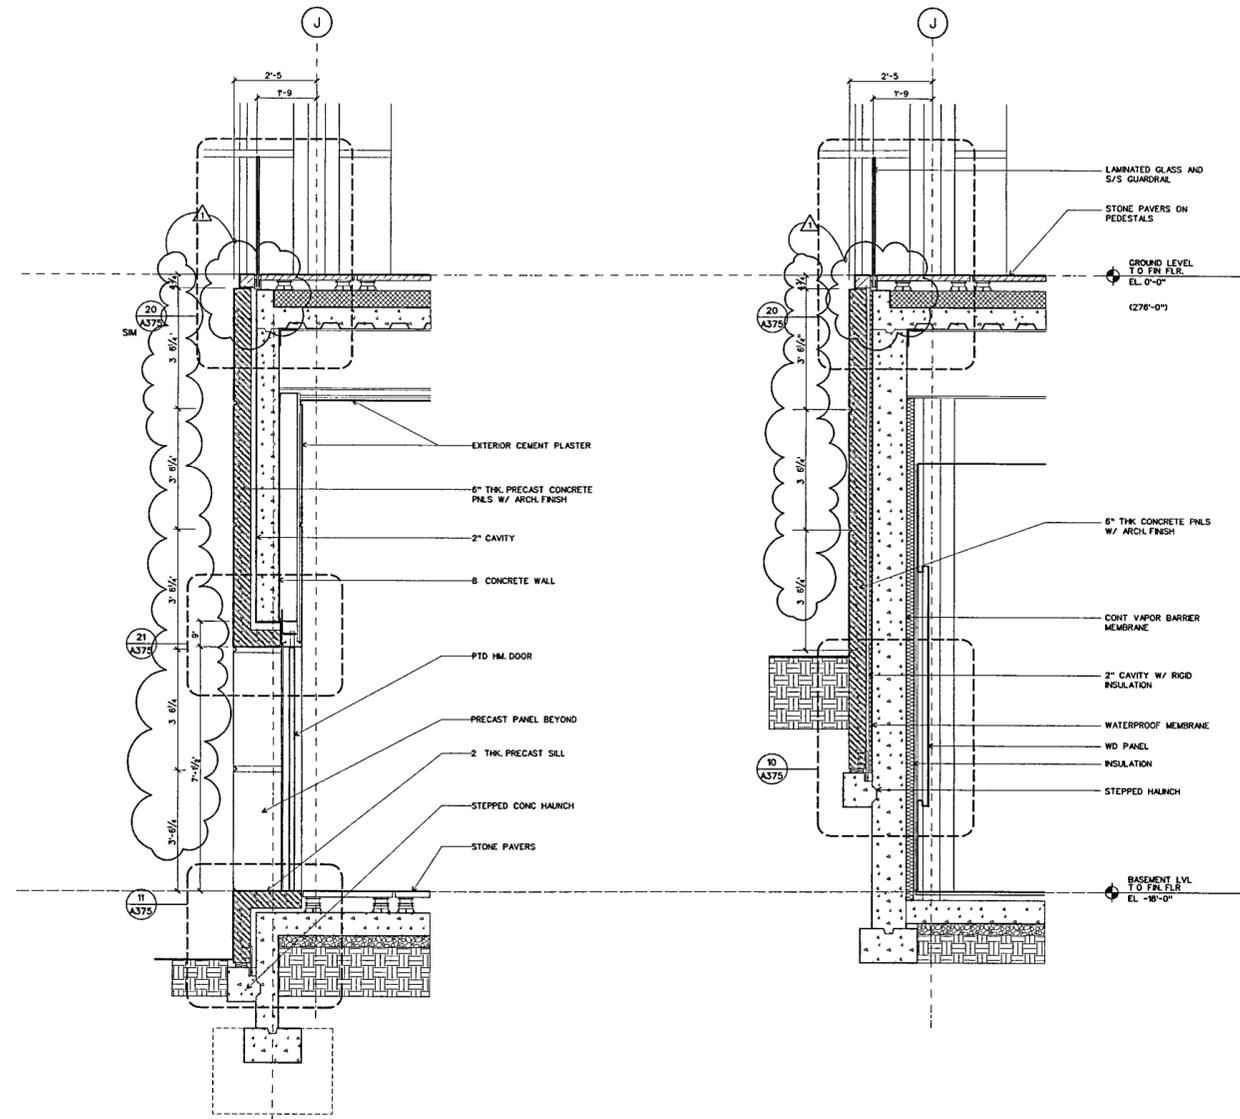

WALL SYSTEM G: SECTION AT CAFE
SCALE 1/2" = 1'-0" DTL-CWG1 21

WALL SYSTEM G: SECTION AT CAFE
SCALE 1/2" = 1'-0" DTL-CWG1 20

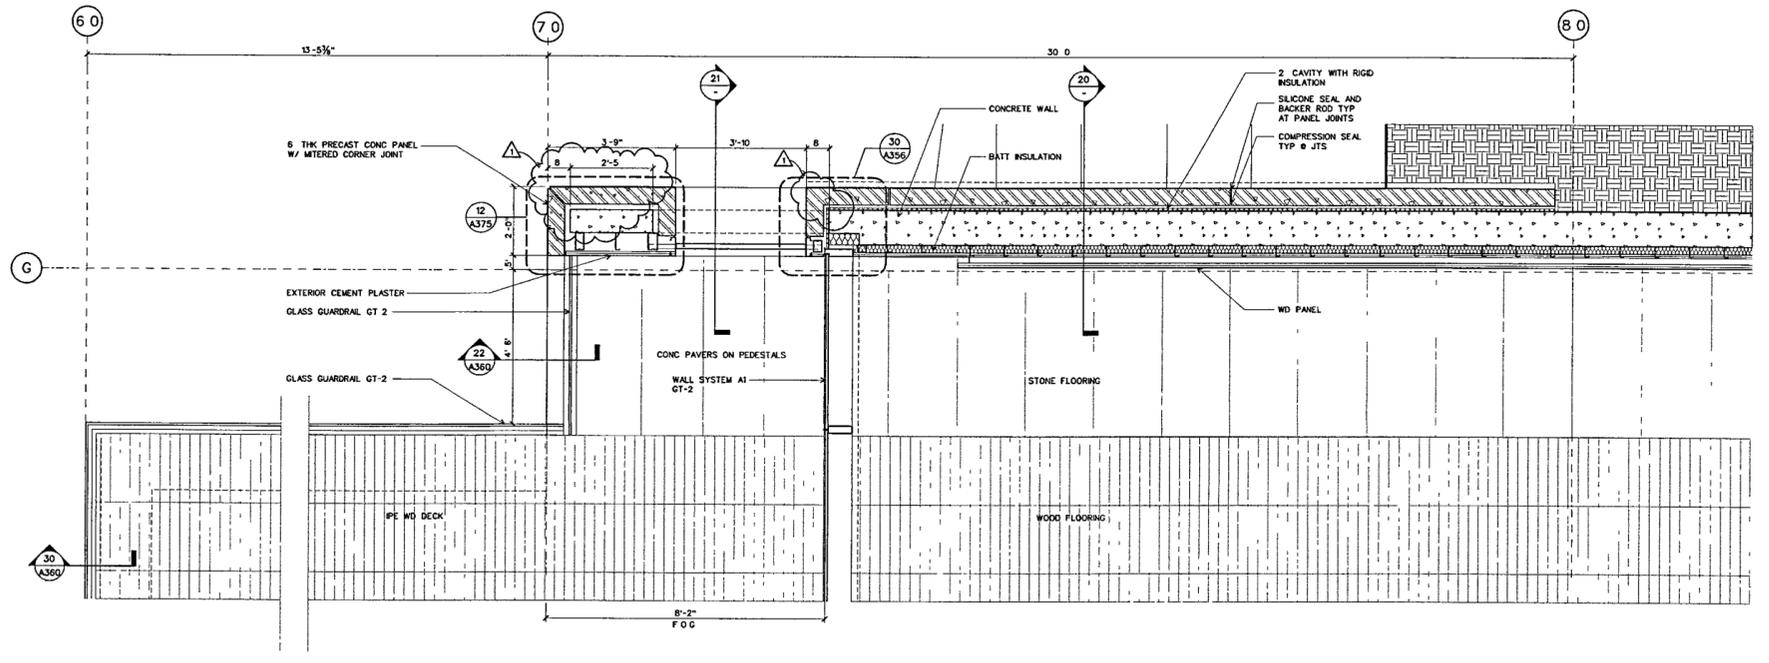

WALL SYSTEM G: PLAN AT CAFE WEST WALL
SCALE 1/2" = 1'-0"

DETAILS/DTL-CWG1 10

FOR OFFICIAL USE ONLY