




WALL SYSTEM A2: DETAIL SECTION AT SOUTH PARAPET  
SCALE 1-1/2" = 1'-0"  
D-CWA03 33

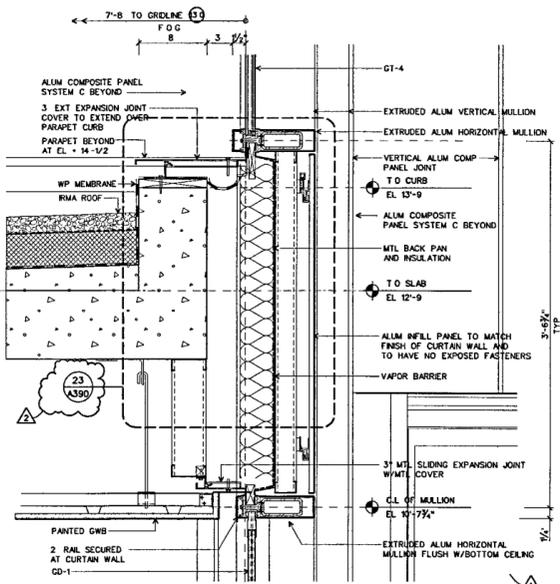


WALL SYSTEM A2: DETAIL SECTION AT SOUTH NECK  
SCALE 1-1/2" = 1'-0"  
D-CWA03 22

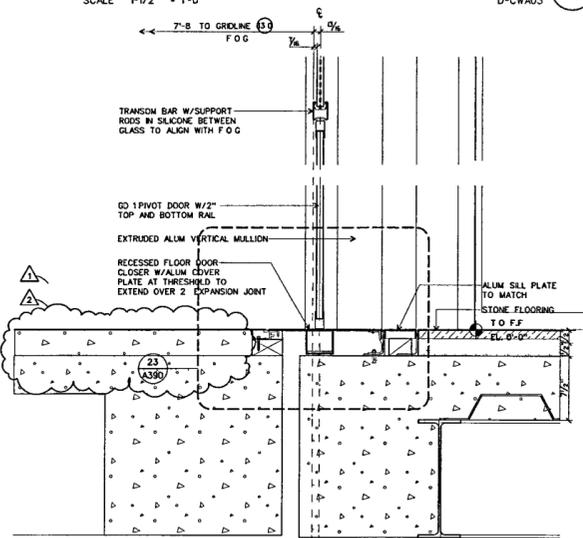


WALL SYSTEM A2: DETAIL SECTION AT SOUTH DOORS AND EXPANSION JOINT  
SCALE 1-1/2" = 1'-0"  
D-CWA03 12

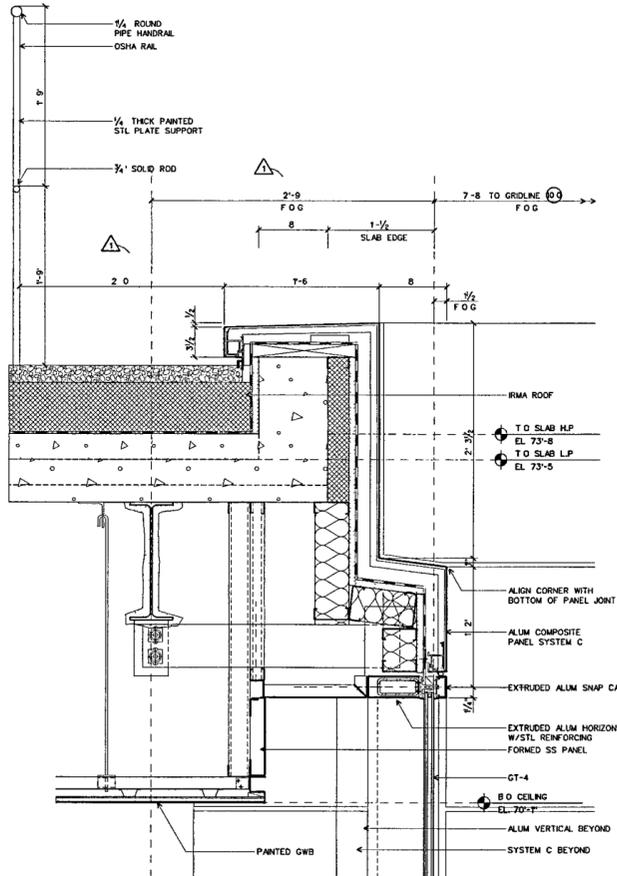


WALL SYSTEM A2: DETAIL SECTION OF PARAPET, TYP  
SCALE 1-1/2" = 1'-0"  
D-CWA03 21

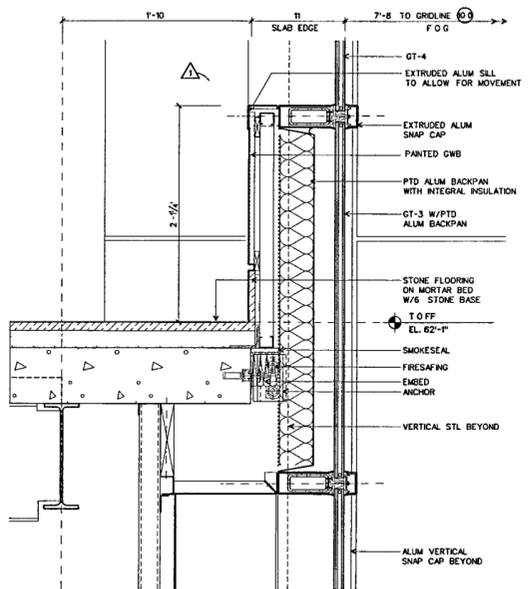


WALL SYSTEM A2: DETAIL SECTION AT EXEC LEVEL  
SCALE 1-1/2" = 1'-0"  
D-CWA03 11

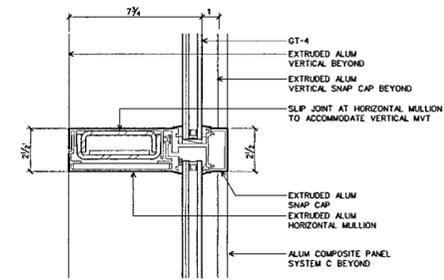


WALL SYSTEM A2: DETAIL OF HORIZONTAL STACK JOINT  
SCALE 3" = 1'-0"  
D-CWA03 40

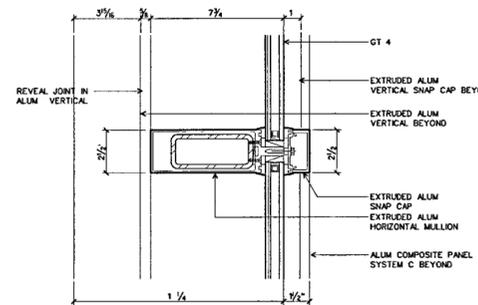

WALL SYSTEM A2: DETAIL OF HORIZONTAL  
SCALE 3" = 1'-0"  
D-CWA03 30

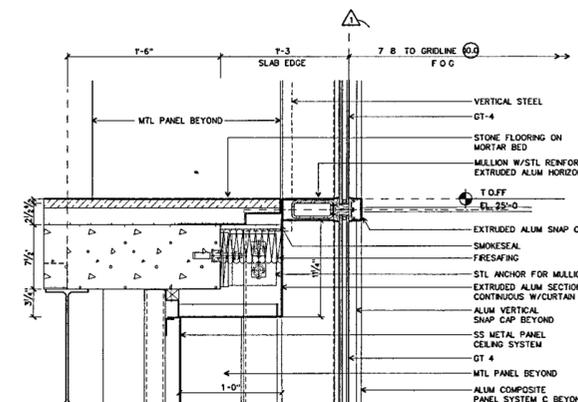

WALL SYSTEM A2: DETAIL SECTION AT SLAB EDGE  
SCALE 1-1/2" = 1'-0"  
D-CWA03 20

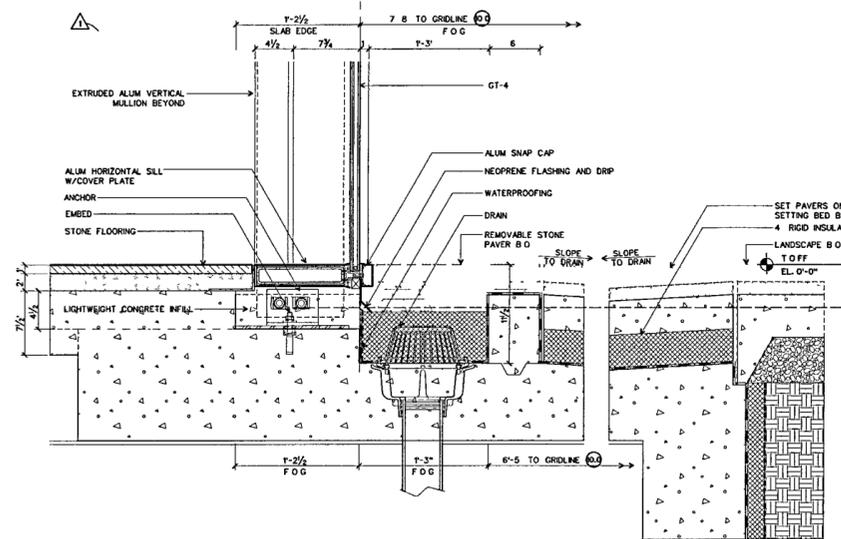

WALL SYSTEM A2: DETAIL SECTION AT GROUND FLOOR  
SCALE 1-1/2" = 1'-0"  
D-CWA03 10

WILLIAM J CLINTON  
PRESIDENTIAL  
CENTER

LITTLE ROCK, ARKANSAS

Architect  
POLSHEK PARTNERSHIP LLP  
320 West 13th Street  
New York, New York 10014  
212 807 7171

Coordinating Architects  
POLK STANLEY YEARY ARCHITECTS Ltd  
700 South Schiller Street  
Little Rock, Arkansas 72201  
501 578 0878

WITSELL EVANS RASCO  
901 West Third Street  
Little Rock, Arkansas 72201  
501 574 5300

WOODS CARADINE ARCHITECTS  
2200 South Main Street  
Little Rock, Arkansas 72206  
501 574 4050

Landscape Architects  
HARGREAVES ASSOCIATES  
118 Magazine Street  
Cambridge, Massachusetts 02139  
617 661 0070


LANDSCAPE ARCHITECTURE, Inc.  
2300 Cottondale Lane Suite 202  
Little Rock, Arkansas 72202  
501 374 9810

Structural Engineer  
LESLIE E. ROBERTSON ASSOC. RLLP  
30 Broad Street, 47th Floor  
New York, New York 10004  
212 750 9000


MEP Engineers  
FLACK + KURTZ Inc.  
475 Fifth Avenue  
New York, New York 10017  
212 532 9800

CROMWELL ARCHITECTS ENGINEERS  
101 South Spring Street  
Little Rock, Arkansas 72201  
501 372 2900

Curtainwall Consultant  
R. A. HEINTGES ARCHITECTS  
126 Fifth Avenue, 6th Floor  
New York, New York 10011  
212 652 2966

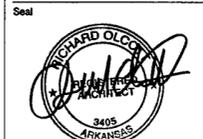

100% Construction Documents	09/27/02
90% Progress Printing	08/30/02
100% Struct./CD Progress	07/01/02
Bridge Bldg Substructure	06/14/02
100% Design Development	03/01/02
Issue	Date

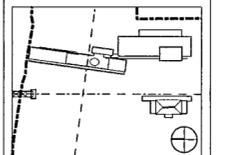

Job No. 9908  
Scale AS NOTED  
Date September 27, 2002  
Title

WALL SYSTEMS A2  
SECTION DETAILS

Sheet No. A357

FOR OFFICIAL USE ONLY