

**WILLIAM J CLINTON
PRESIDENTIAL
CENTER**

LITTLE ROCK, ARKANSAS

Architect
POLSHEK PARTNERSHIP LLP
320 West 13th Street
New York, New York 10014
212 607 7171

Coordinating Architects
POLK STANLEY YEARY ARCHITECTS LM
700 South Schuler Street
Little Rock, Arkansas 72201
501 378 0978

WITSELL EVANS RASCO
901 West Third Street
Little Rock, Arkansas 72201
501 374 5300

WOODS CARADINE ARCHITECTS
2200 South Main Street
Little Rock, Arkansas 72206
501 374 4060

Landscape Architects
HARGREAVES ASSOCIATES
118 Magazine Street
Cambridge Massachusetts 02139
617 681 0070


LANDSCAPE ARCHITECTURE, Inc.
2300 Cottondale Lane Suite 202
Little Rock, Arkansas 72202
501 374 5810

Structural Engineer
LESLIE E. ROBERTSON ASSOC. RLLP
30 Broad Street, 47th Floor
New York, New York 10004
212 750 9000

MEP Engineers
FLACK + KURTZ Inc.
475 Fifth Avenue
New York, New York 10017
212 532 9600

CROMWELL ARCHITECTS ENGINEERS
101 South Spring Street
Little Rock, Arkansas 72201
501 372 2900

Curtainwall Consultant
R. A. HEINTGES ARCHITECTS
128 Fifth Avenue, 9th Floor
New York, New York 10011
212 652 2968

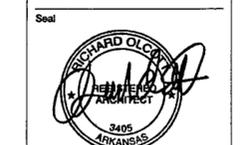


100% Construction Documents	08/27/02
90% Progress Printing	08/30/02
100% Struct./ CD Progress	07/01/02
100% Design Development	03/01/02
Issue	Date


Job No 9908
Scale AS NOTED
Date September 27, 2002
Title

**WALL SYSTEM A3
SECTION AND
PLAN DETAILS**


Sheet No **A358**

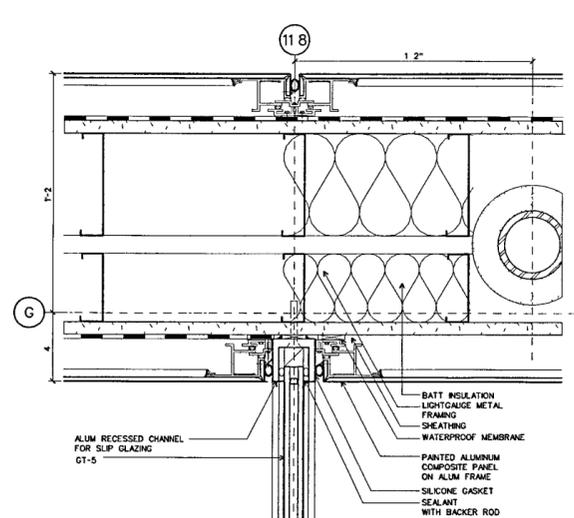


WALL SYSTEM A3 PLAN DETAIL AT END GLASS WALL
SCALE 3" = 1'-0"
D-CWA05 33

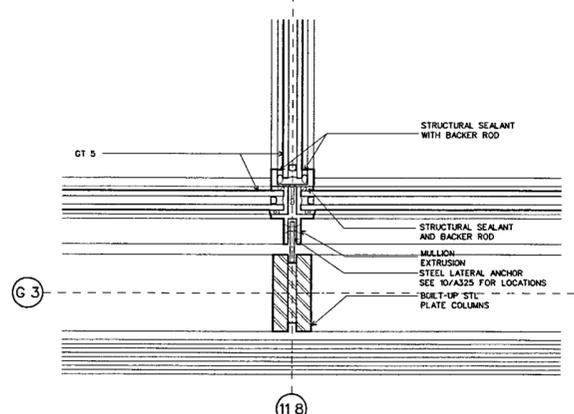


WALL SYSTEM A3 PLAN DETAIL AT END GLASS WALL
SCALE 3" = 1'-0"
D-CWA05 23

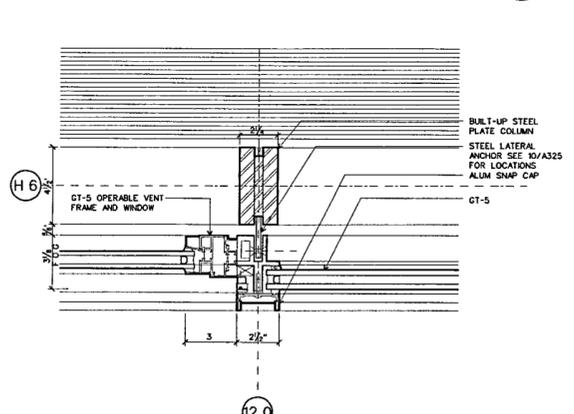


WALL SYSTEM A3 PLAN DETAIL TYP
SCALE 3" = 1'-0"
D-CWA05 13

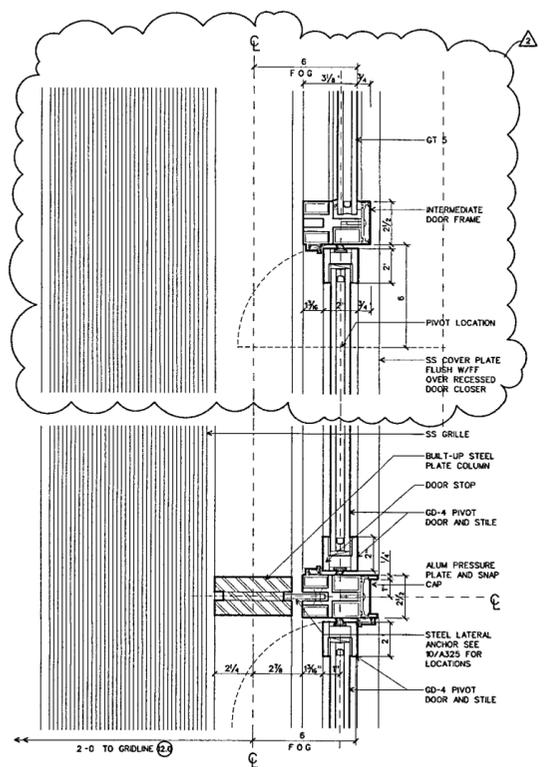


WALL SYSTEM A3 PLAN DETAIL AT PIVOT DR AND SIDELITE
SCALE 3" = 1'-0"
D-CWA05 32

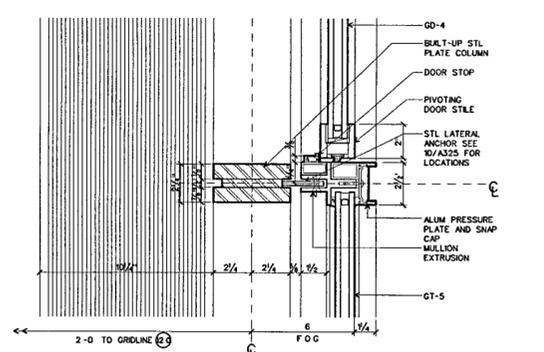


WALL SYSTEM A3 PLAN AT PIVOT DOOR
SCALE 3" = 1'-0"
D-CWA05 22

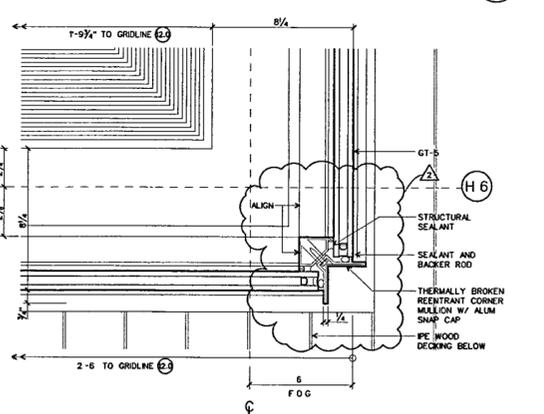


WALL SYSTEM A3 PLAN DETAIL AT TYP MULLION
SCALE 3" = 1'-0"
D-CWA05 12

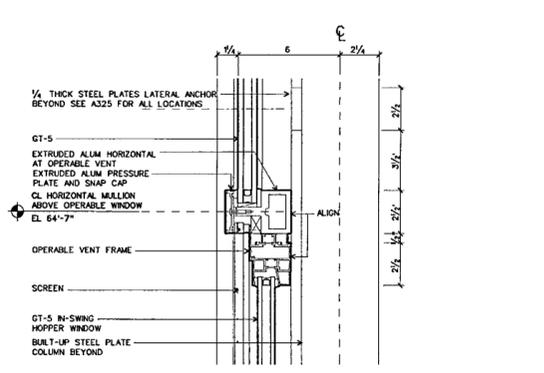


WALL SYSTEM A3 SECTION AT OPERABLE WINDOW
SCALE 3" = 1'-0"
D-CWA05 41

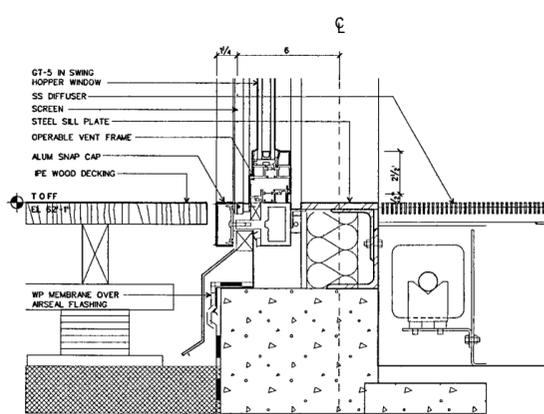


WALL SYSTEM A3 SECTION AT OPERABLE WINDOW
SCALE 3" = 1'-0"
D-CWA05 31

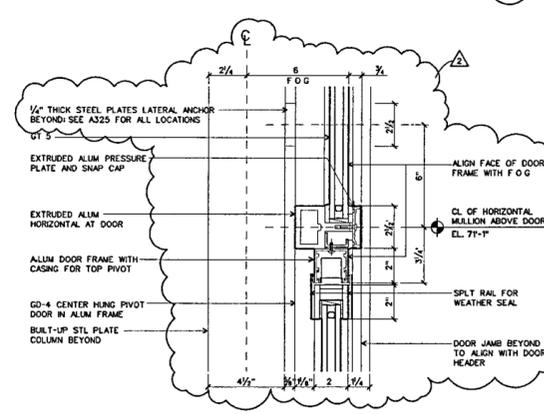


WALL SYSTEM A3 DETAIL AT PIVOT DOOR HEAD
SCALE 3" = 1'-0"
D-CWA04 21

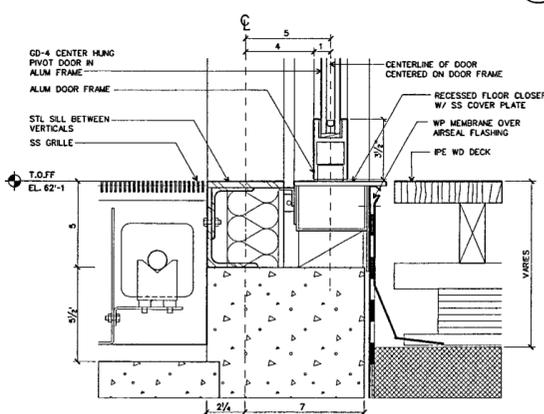


WALL SYSTEM A3 DETAIL AT PIVOT DOOR SILL
SCALE 3" = 1'-0"
D-CWA04 11

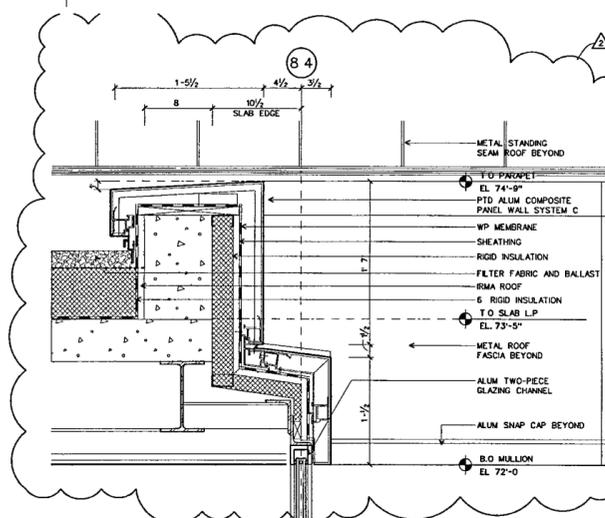


WALL SYSTEM A3 SECTION DETAIL AT BASE AND HEAD
SCALE 1-1/2" = 1'-0"
D-CWA04 30

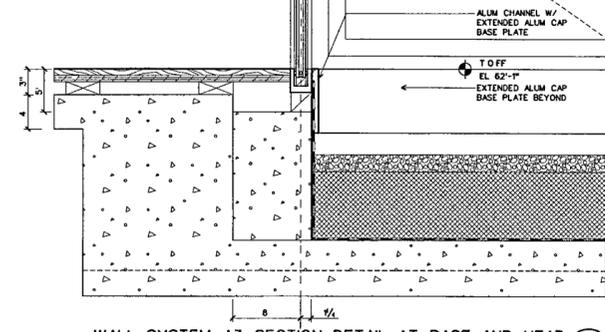

WALL SYSTEM A3 SECTION DETAIL AT HEAD TYP
SCALE 1-1/2" = 1'-0"
D-CWA04 20

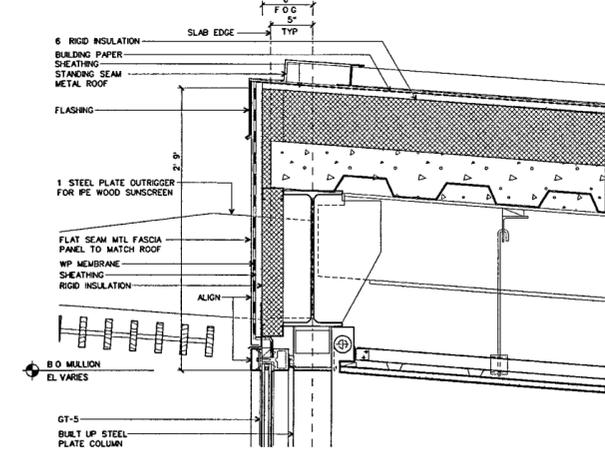

WALL SYSTEM A3 SECTION DETAIL AT TYP BASE
SCALE 1-1/2" = 1'-0"
D-CWA04 10

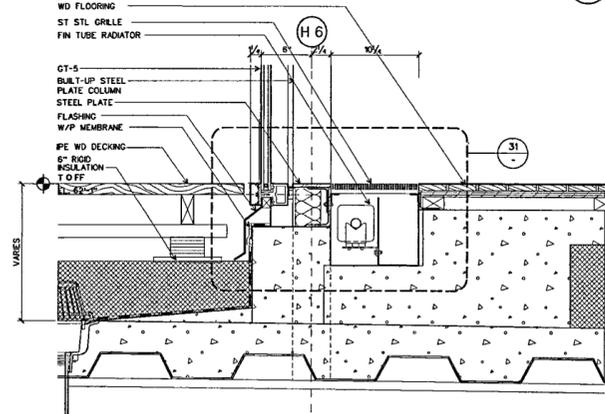

WALL SYSTEM A3 SECTION DETAIL AT TYP BASE
SCALE 1-1/2" = 1'-0"
D-CWA04 10