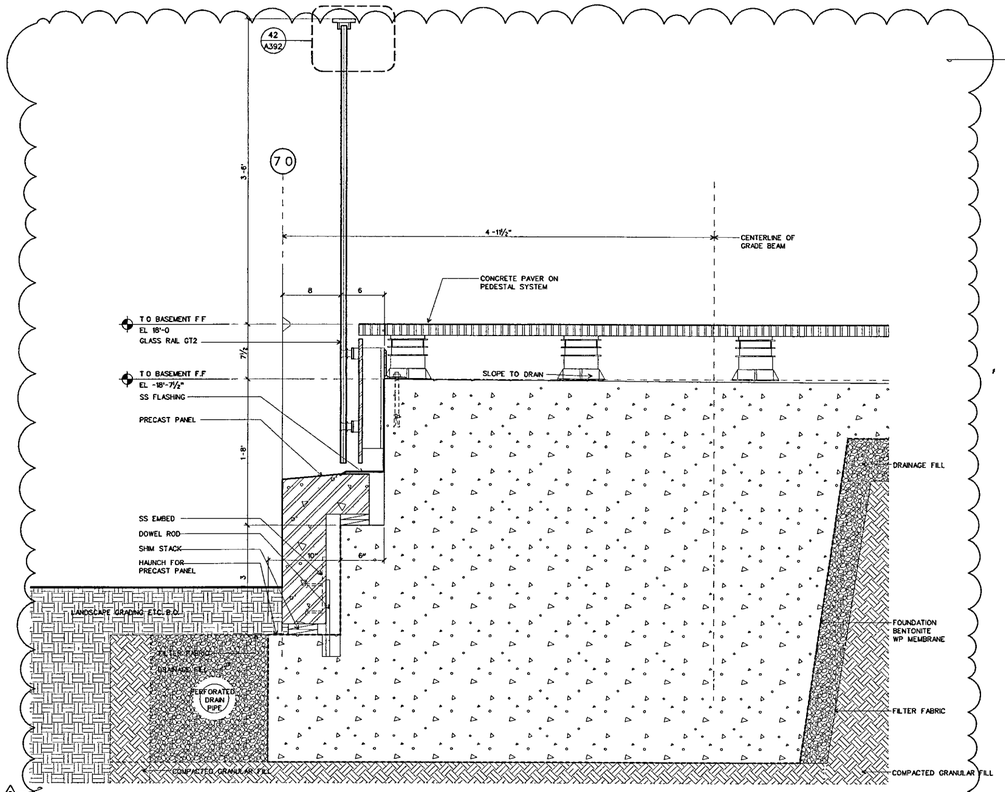

SECTION DETAIL AT CAFE TERRACE RAIL/PRECAST

SCALE 1-1/2 " = 1'-0" D-CWC01 22

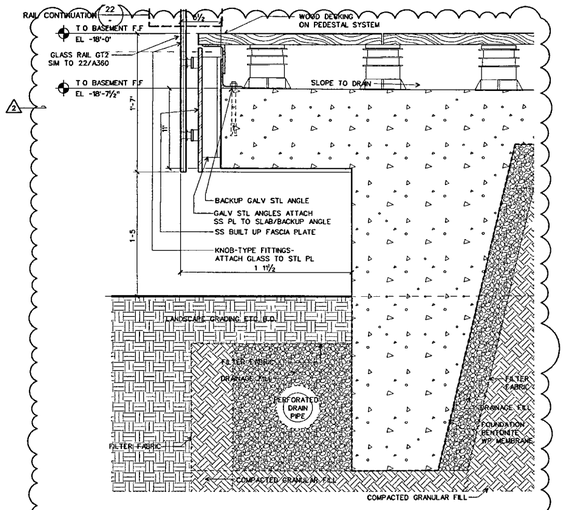

SECTION DETAIL AT CAFE TERRACE RAIL

SCALE 1-1/2 " = 1'-0" 30

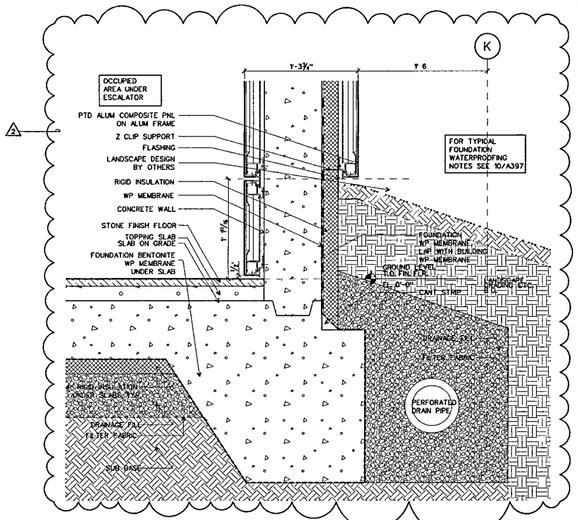

WALL SYSTEM C: DETAIL SECTION @ ESCALATOR BOX

SCALE 1-1/2 " = 1'-0" D-CWC01 21

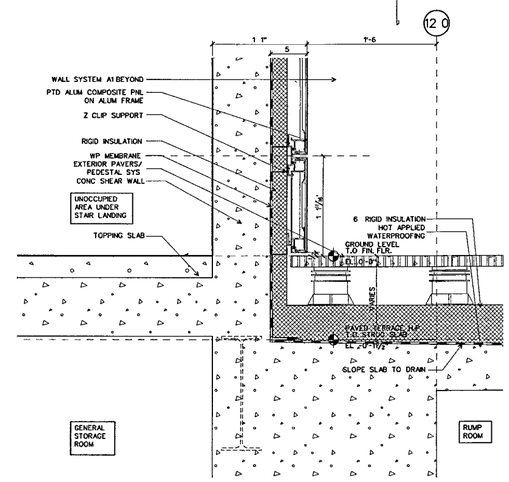

WALL SYSTEM C: DETAIL SECTION @ ESCALATOR BOX BASE (PLAZA)

SCALE 1-1/2 " = 1-0 D-CWC01 20

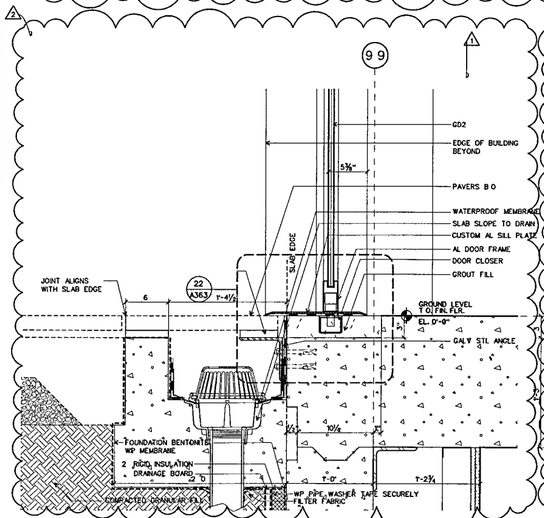

WALL SYSTEM C: DETAIL SECTION @ DOOR BASE

SCALE 1-1/2 " = 1'-0" D-CWC01 13

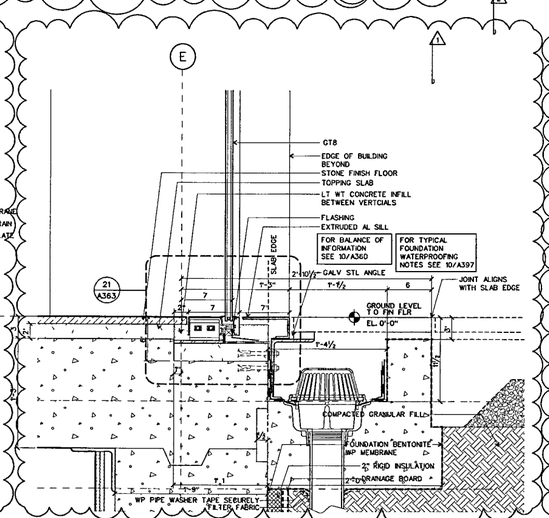

WALL SYSTEM C: DETAIL SECTION @ CORE GLAZING BASE

SCALE 1-1/2 " = 1-0 D-CWC01 12

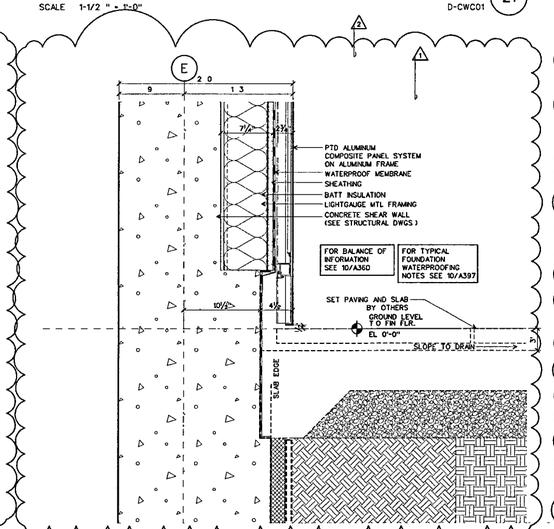

WALL SYSTEM C: DETAIL SECTION @ BASE SHEAR WALL

SCALE 1-1/2 " = 1-0 D-CWC01 11

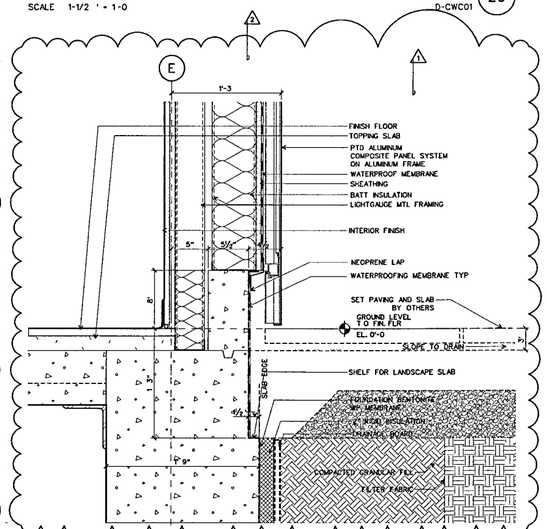

WALL SYSTEM C: TYP. DETAIL SECTION @ BASE

SCALE 1-1/2 " = 1-0 D-CWC01 10

WILLIAM J CLINTON PRESIDENTIAL CENTER

LITTLE ROCK, ARKANSAS

Architect

POLSHEK PARTNERSHIP LLP
320 West 13th Street
New York, New York 10014
212 807 7171

Coordinating Architects

POLK STANLEY YEARY ARCHITECTS Ltd
700 South Schiller Street
Little Rock Arkansas 72201
501 378 0878

WITSELL EVANS RASCO
901 West Third Street
Little Rock, Arkansas 72201
501 374 5300

WOODS CARADINE ARCHITECTS
2200 South Main Street
Little Rock Arkansas 72206
501 374 4060

Landscape Architects

HARGREAVES ASSOCIATES
118 Magazine Street
Cambridge Massachusettes 02139
617 661 0070

LANDSCAPE ARCHITECTURE, Inc.
2300 Cottondale Lane Suite 202
Little Rock, Arkansas 72202
501 374 5610

Structural Engineer

LESLIE E. ROBERTSON ASSOC , RLLP
30 Broad Street, 47th Floor
New York New York 10004
212 750 9000

MEP Engineers

FLACK + KURTZ Inc.
475 Fifth Avenue
New York, New York 10017
212 532 9600

CROMWELL ARCHITECTS ENGINEERS
101 South Spring Street
Little Rock, Arkansas 72201
501 372 2900

Curtainwall Consultant

R. A. HEINTGES ARCHITECTS
126 Fifth Avenue, 9th Floor
New York, New York 10011
212 652-2966

Seal

RICHARD OLOCK REGISTERED ARCHITECT 3405 ARKANSAS

Issue	Date
2 100% Construction Documents	09/27/02
1 90% Progress Printing	08/30/02
100% Struct/ CD Progress	07/01/02
Bridge Bldg Substructure	06/14/02
100% Design Development	03/01/02

Job No 9908

Scale 1-1/2" = 1'-0"

Date September 27, 2002

Title WALL SYSTEM C PLAZA AND BASE DETAIL SECTIONS

Sheet No A360

FOR OFFICIAL USE ONLY