



100% Construction Documents	09/27/02
50% Progress Printing	08/30/02
100% Struct CD Progress	07/01/02
Issue	Date


Job No 9808

Scale 1 1/2" = 1'-0"


Date September 27, 2002

Title **WALL SYSTEM C DETAIL SECTIONS**


Sheet No **A361**

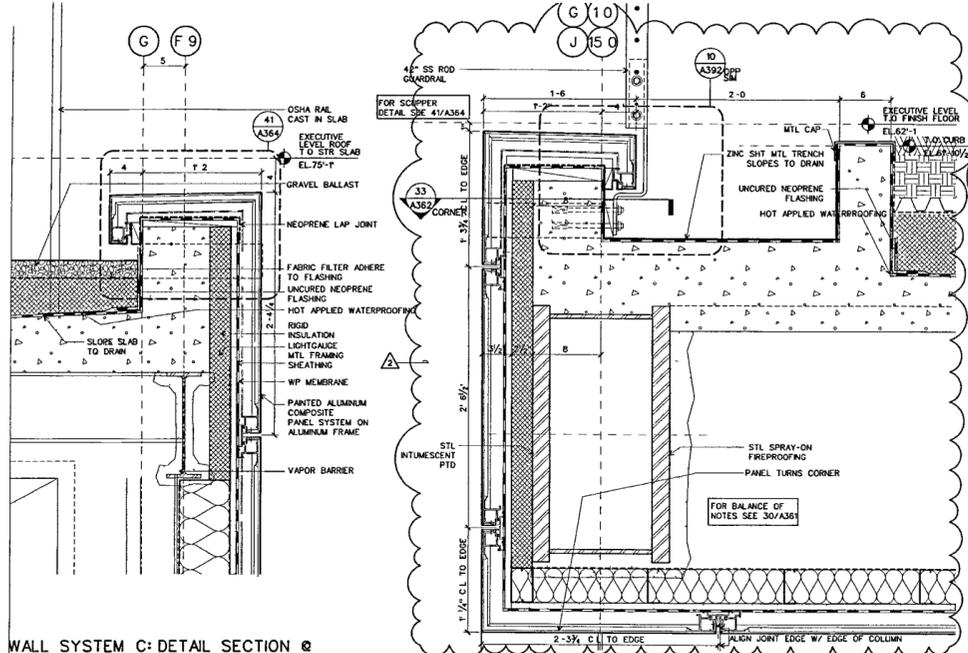


WALL SYSTEM C: DETAIL SECTION @ TOP OF WALL EXEC LEVEL
SCALE 1-1/2" = 1'-0"
D-CWC02 33

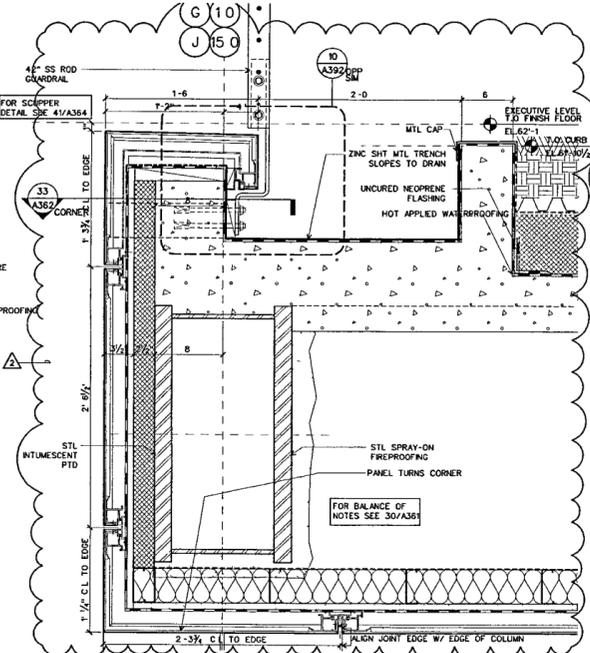


WALL SYSTEM C: DETAIL SECTION @ N & S ENDS OF BUILDING, UPPER EXTERIOR SOFFIT
SCALE 1-1/2" = 1'-0"
D-CWC02 32

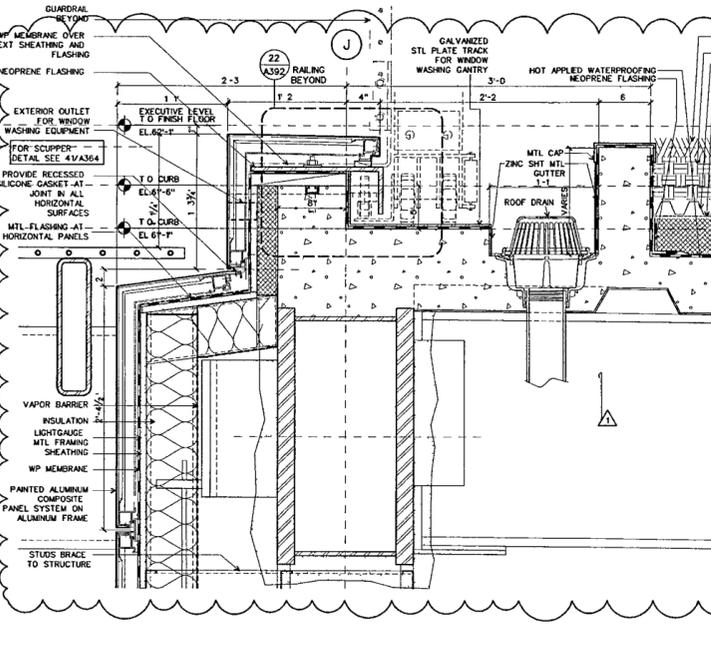


WALL SYSTEM C: DETAIL SECTION @ TYPICAL PARAPET EAST
SCALE 1-1/2" = 1'-0"
D-CWC02 31

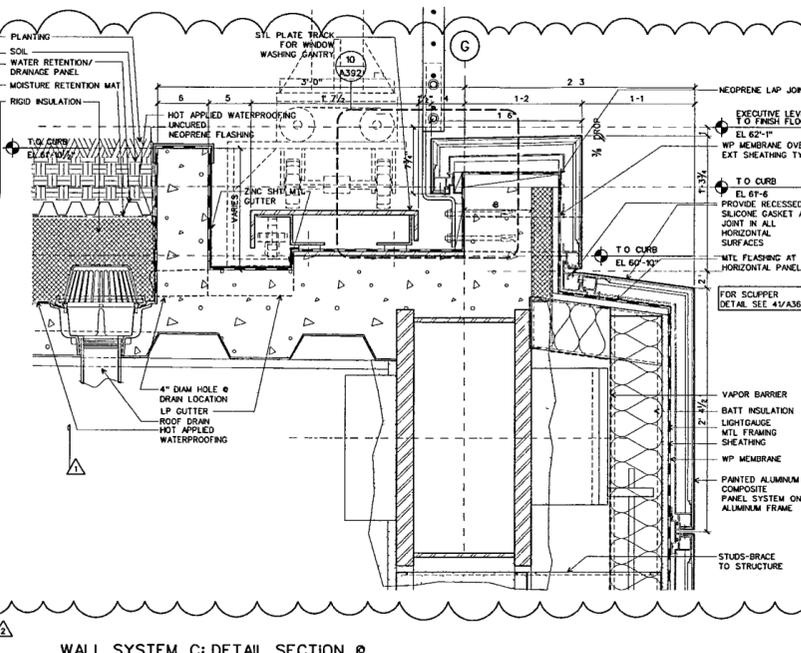


WALL SYSTEM C: DETAIL SECTION @ TYPICAL PARAPET EAST
SCALE 1-1/2" = 1'-0"
D-CWC02 30

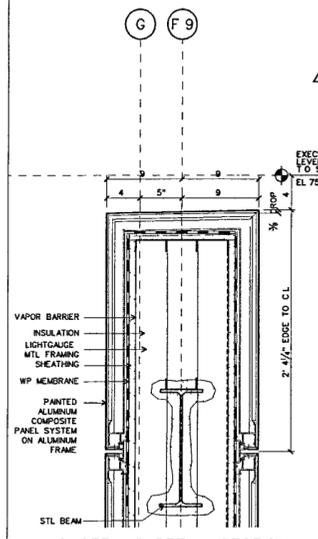


WALL SYSTEM C: DETAIL SECTION @ FREESTANDING WALL EXEC. LEVEL
SCALE 1-1/2" = 1'-0"
D-CWC02 23

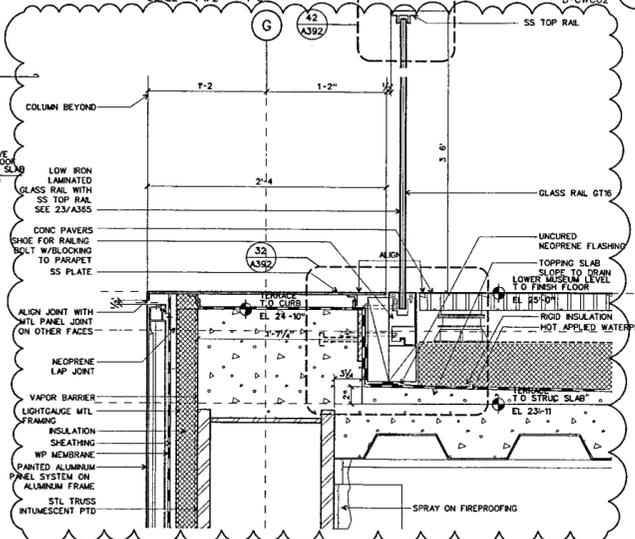


WALL SYSTEM C: DETAIL SECTION @ BALCONY EDGE
SCALE 1-1/2" = 1'-0"
D-CWC02 22

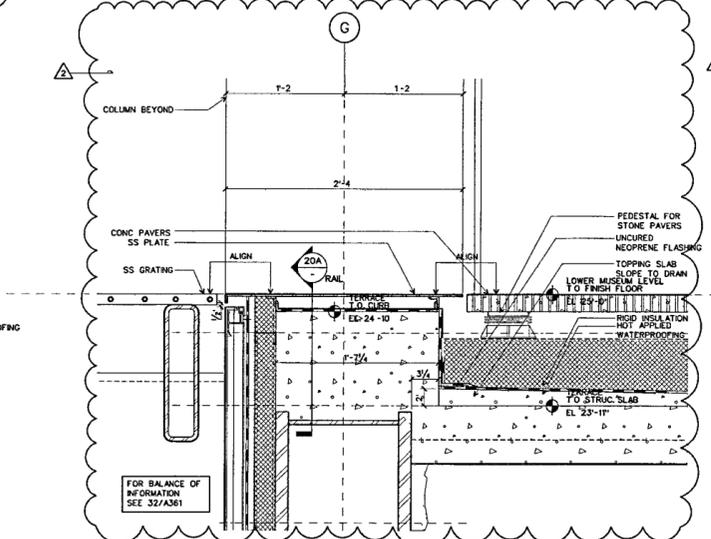


WALL SYSTEM C: DETAIL SECTION @ BALCONY/GRATING
SCALE 1-1/2" = 1'-0"
D-CWC02 21

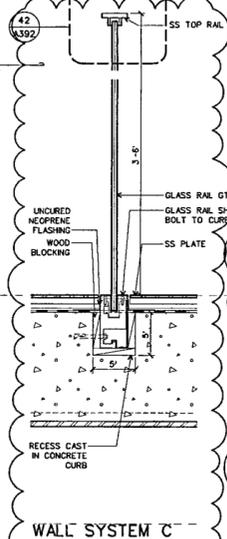


WALL SYSTEM C: DETAIL SECTION @ RAIL-CURB
SCALE 1-1/2" = 1'-0"
D-CWC02 20A

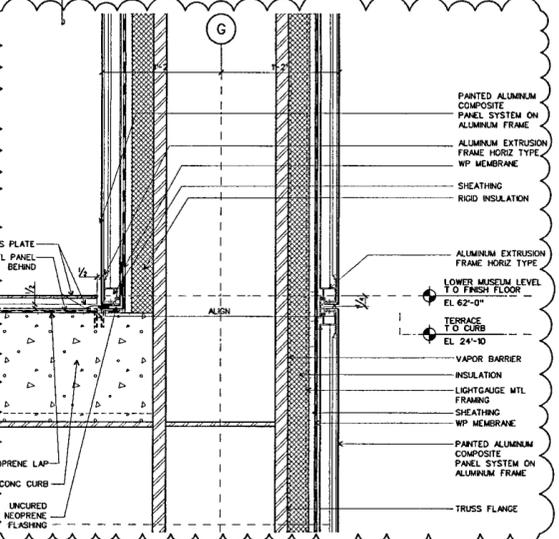


WALL SYSTEM C: DETAIL SECTION @ COLUMN-BALCONY INTERSECTION
SCALE 1-1/2" = 1'-0"
D-CWC02 20

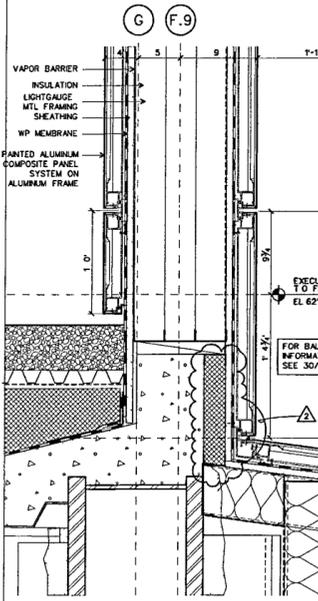


WALL SYSTEM C: DETAIL SECTION @ FREESTANDING WALL EXEC. LEVEL
SCALE 1-1/2" = 1'-0"
D-CWC02 13

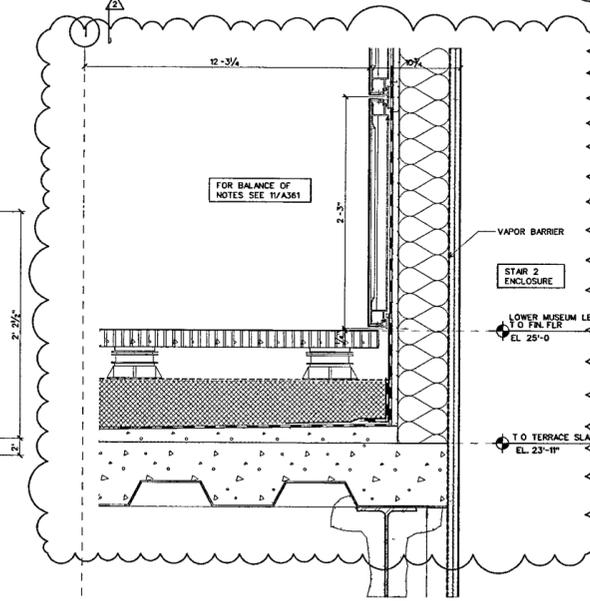

WALL SYSTEM C: DETAIL SECTION @ BALCONY-WALL INTERSECTION
SCALE 1-1/2" = 1'-0"
D-CWC02 12

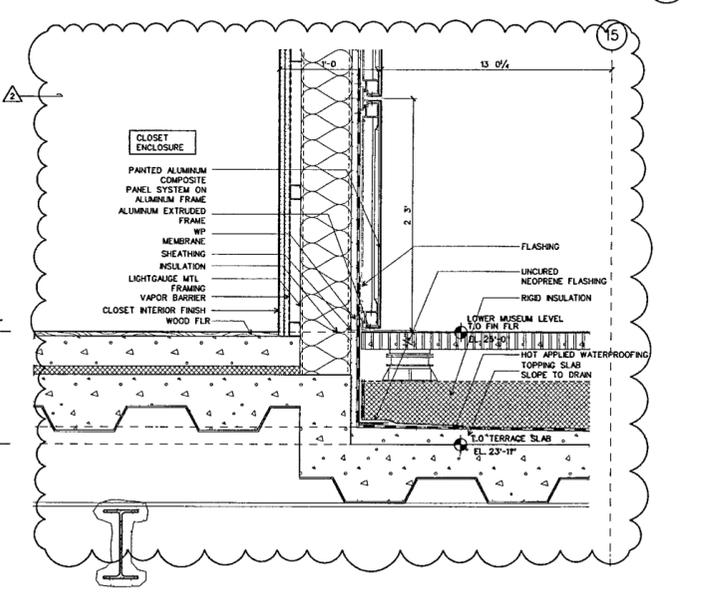

WALL SYSTEM C: DETAIL SECTION @ ESCALATOR ENCLOSURE EDGE
SCALE 1-1/2" = 1'-0"
D-CWC02 11

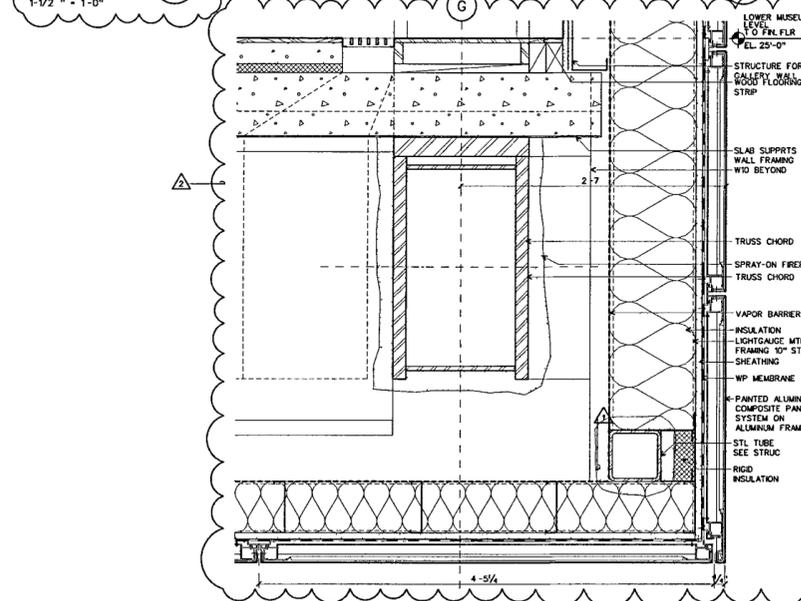

WALL SYSTEM C: DETAIL SECTION @ EAST BUILDING EDGE
SCALE 1-1/2" = 1'-0"
D-CWC02 10