

LITTLE ROCK, ARKANSAS

Architect
POLSHEK PARTNERSHIP LLP
320 West 13th Street
New York, New York 10014
212.807.7171

Coordinating Architects
POLK STANLEY YEARY ARCHITECTS LTD
700 South Schiller Street
Little Rock, Arkansas 72201
501.378.0878

WITSELL EVANS RASCO
901 West Third Street
Little Rock, Arkansas 72201
501.374.5300

WOODS CARADINE ARCHITECTS
2200 South Main Street
Little Rock, Arkansas 72206
501.374.4050

Landscape Architects
HARGREAVES ASSOCIATES
118 Magazine Street
Cambridge, Massachusetts 02139
617.661.0070


LANDSCAPE ARCHITECTURE, Inc.
2300 Cottondale Lane Suite 202
Little Rock, Arkansas 72202
501.374.5610

Structural Engineer
LESLIE E. ROBERTSON ASSOC., RLLP
30 Broad Street, 4th Floor
New York, New York 10004
212.750.9000


MEP Engineers
FLACK + KURTZ Inc.
475 Fifth Avenue
New York, New York 10017
212.532.9600

CROMWELL ARCHITECTS ENGINEERS
101 South Spring Street
Little Rock, Arkansas 72201
501.372.2900

Curtainwall Consultant
R. A. HEINTGES ARCHITECTS
128 Fifth Avenue, 9th Floor
New York, New York 10011
212.652.2966

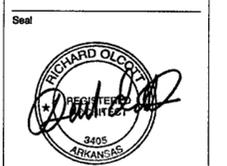


100% Construction Documents	09/27/02
90% Progress Printing	08/30/02
100% Struct/CD Progress	07/01/02
Issue	Date

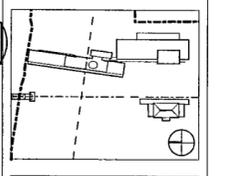


Job No: 9908
Scale: AS NOTED
Date: September 27, 2002
Title: WALL SYSTEM C DETAIL SECTIONS AND PLANS


Sheet No: **A362**

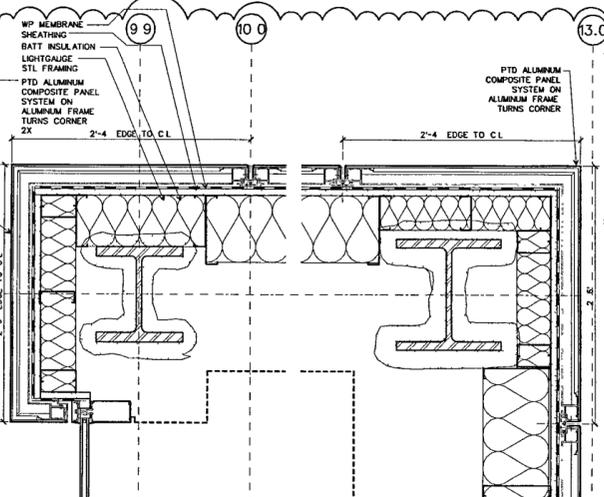


WALL SYSTEM C: DETAIL PLAN-SECTION @ CORE BUILDING, NE & SE CORNERS
SCALE 1/2" = 1'-0"
D-CWC03 34

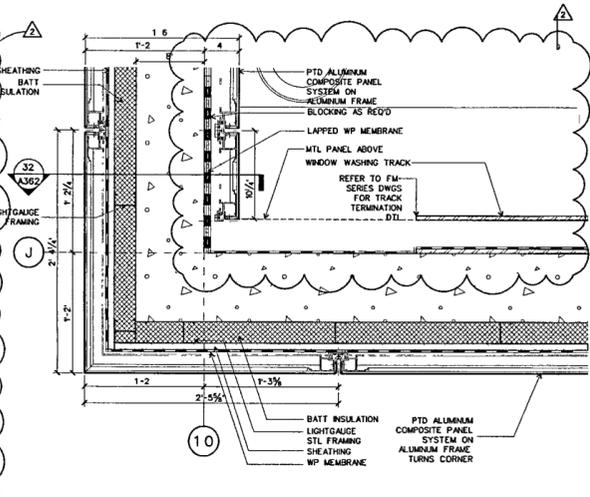


WALL SYSTEM C: DETAIL PLAN-SECTION @ PARAPET CORNER
SCALE 1/2" = 1'-0"
D-CWC03 33

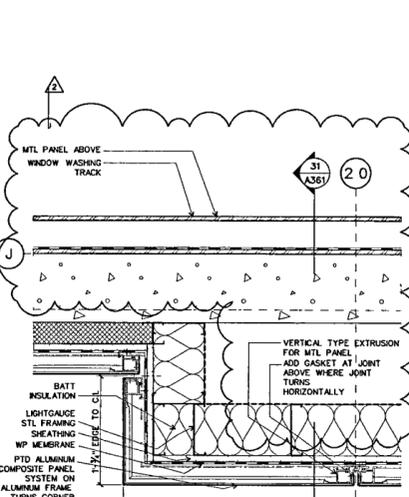


WALL SYSTEM C: DETAIL PLAN-SECTION @ PARAPET
SCALE 1/2" = 1'-0"
D-CWC03 32

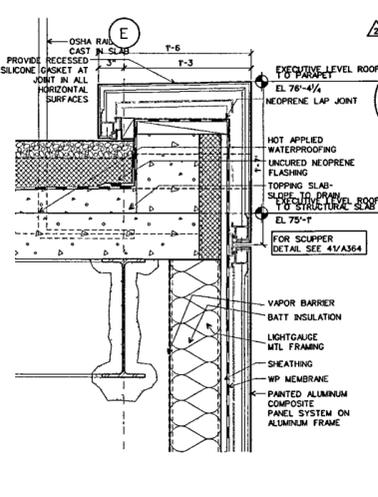


WALL SYSTEM C: DETAIL SECTION @ CORE PARAPET
SCALE 1/2" = 1'-0"
D-CWC03 31

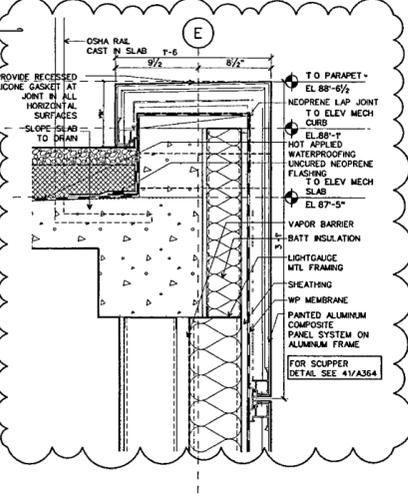


WALL SYSTEM C: DETAIL SECTION @ PARAPET ELEV MECH
SCALE 1/2" = 1'-0"
D-CWC03 30

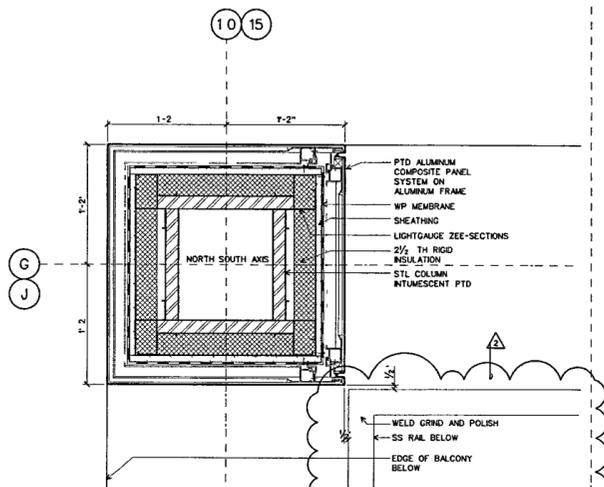


WALL SYSTEM C: DETAIL SECTION @ CORNER CLAD TRUSS
SCALE 1/2" = 1'-0"
D-CWC03 24

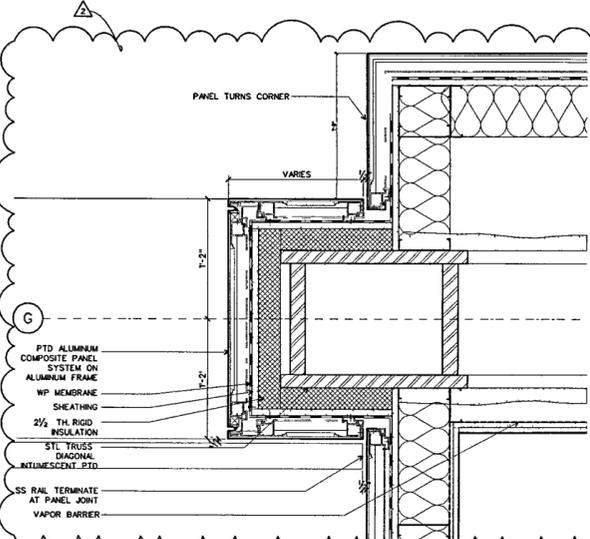


WALL SYSTEM C: DETAIL SECTION @ CORNER CLAD TRUSS
SCALE 1/2" = 1'-0"
D-CWC03 23

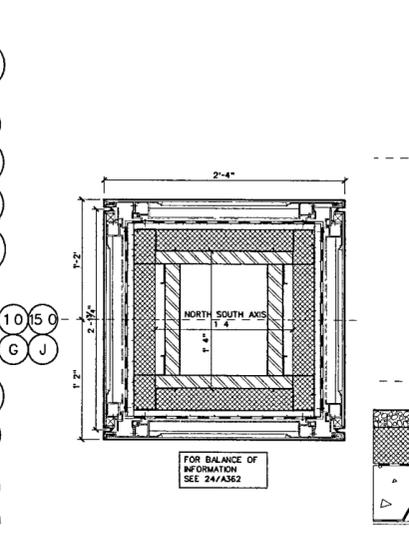


WALL SYSTEM C: DETAIL SECTION @ DIAGONAL CLAD TRUSS
SCALE 1/2" = 1'-0"
D-CWC03 22

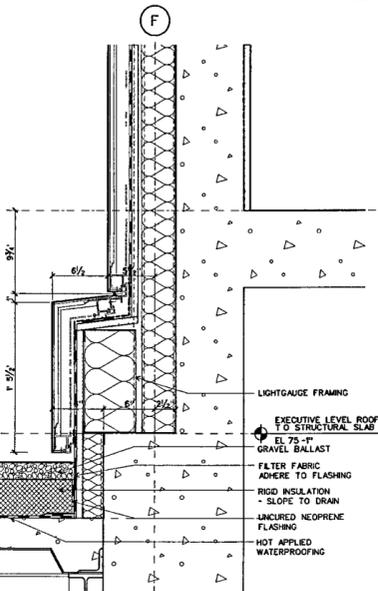


WALL SYSTEM C: DETAIL SECTION @ ELEV. MECH. BASE/ROOF
SCALE 1/2" = 1'-0"
D-CWC03 21

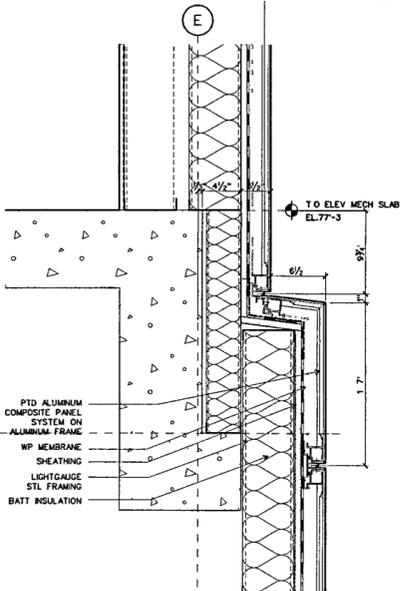


WALL SYSTEM C: DETAIL SECTION @ ELEV. MECH. BASE
SCALE 1/2" = 1'-0"
D-CWC03 20

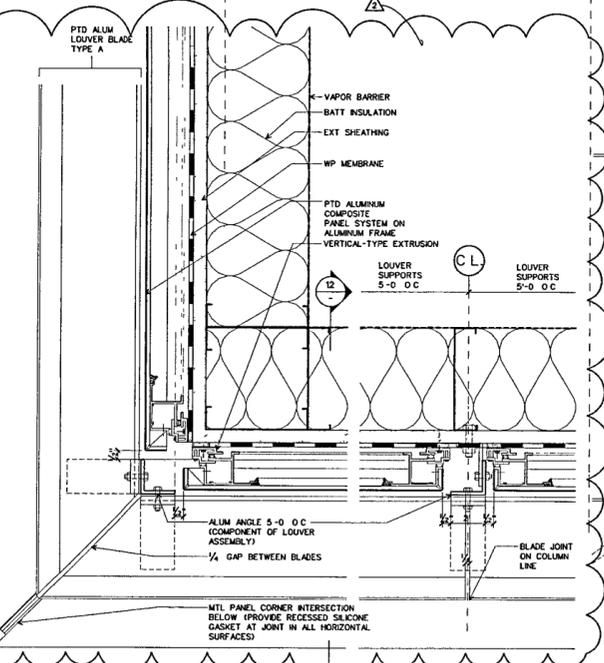


WALL SYSTEM C: DETAIL PLAN-SECTION @ LOUVER A CORNER
SCALE 3" = 1'-0"
D-CWC03 14

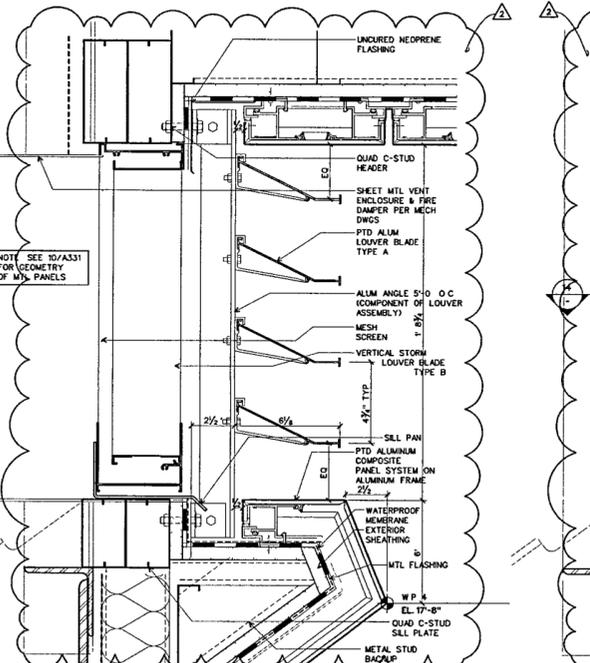


WALL SYSTEM C: DETAIL SECTION @ LOUVER A OPEN
SCALE 3" = 1'-0"
D-CWC03 13

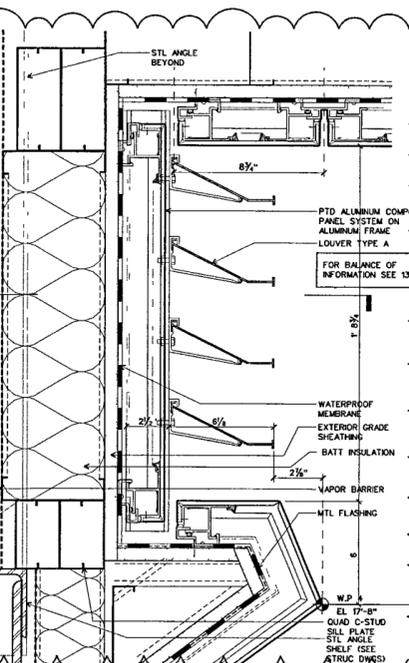

WALL SYSTEM C: DETAIL SECTION @ LOUVER A BLANKED OFF
SCALE 3" = 1'-0"
D-CWC03 12

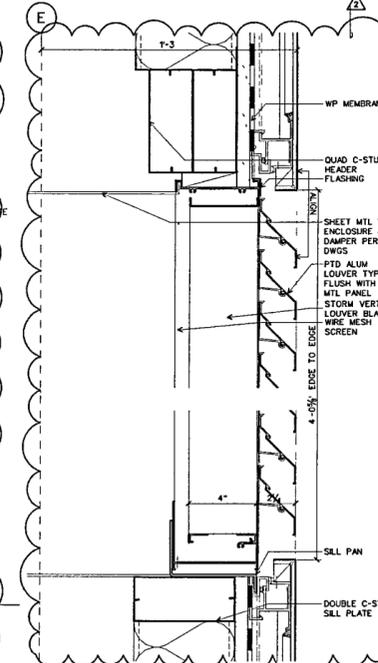

WALL SYSTEM C: DETAIL SECTION @ LOUVER B OPEN
SCALE 3" = 1'-0"
D-CWC03 11

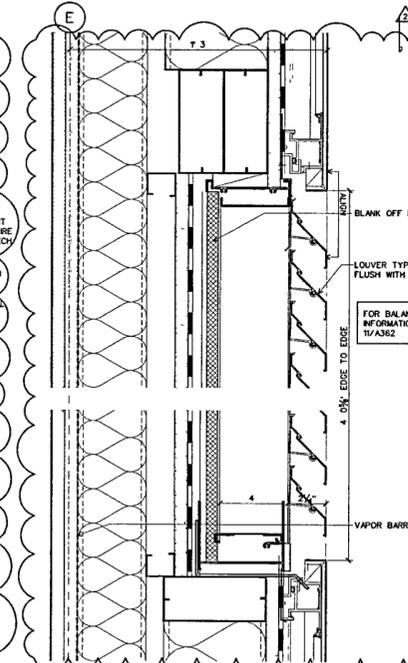

WALL SYSTEM C: DETAIL SECTION @ LOUVER B BLANKED OFF
SCALE 3" = 1'-0"
D-CWC03 10