

**WILLIAM J CLINTON
PRESIDENTIAL
CENTER**

LITTLE ROCK, ARKANSAS

Architect
POLSHEK PARTNERSHIP LLP
320 West 13th Street
New York, New York 10014
212 807 7171

Coordinating Architects
POLK STANLEY YEARY ARCHITECTS LTD
700 South Schiller Street
Little Rock, Arkansas 72201
501 378 0878

WITSELL EVANS RASCO
901 West Third Street
Little Rock, Arkansas 72201
501 374 5300

WOODS GARADINE ARCHITECTS
2200 South Main Street
Little Rock, Arkansas 72206
501 374 4060

Landscape Architects
HARGREAVES ASSOCIATES
118 Magacna Street
Cambridge, Massachusetts 02139
617.651.0070

LANDSCAPE ARCHITECTURE, Inc.
2300 Cottondale Lane Suite 202
Little Rock, Arkansas 72202
501.374.5810

Structural Engineer
LESLIE E ROBERTSON ASSOC, RLLP
30 Broad Street, 47th Floor
New York, New York 10004
212.750.9000


MEP Engineers
FLACK + KURTZ Inc
475 5th Avenue
New York, New York 10017
212.532.9600

CROMWELL ARCHITECTS ENGINEERS
101 South Spring Street
Little Rock, Arkansas 72201
501 372 2900

Curtainwall Consultant
R. A. HEINTGES ARCHITECTS
128 5th Avenue, 8th Floor
New York, New York 10011
212 652-2666



100% Construction Documents	09/27/02
90% Progress Printing	08/30/02
100% Struct/CD Progress	07/01/02
100% Design Development	03/01/02
Issue	Date

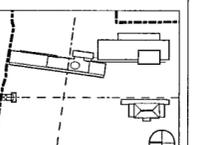


Job No 9908
Scale 1-1/2" = 1'-0"
Date September 27, 2002
Title


**WALL SYSTEMS D
AND E
DETAIL SECTIONS**

Sheet No


A365

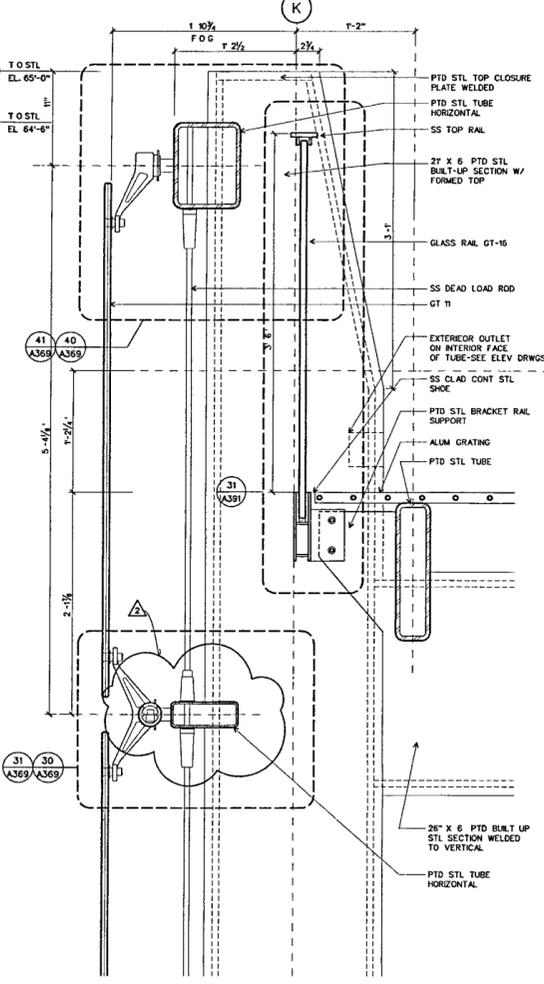


WALL SYSTEM E: DETAIL SECTION AT UPPER GRATING
SCALE 1-1/2" = 1'-0"
D-CWDE01

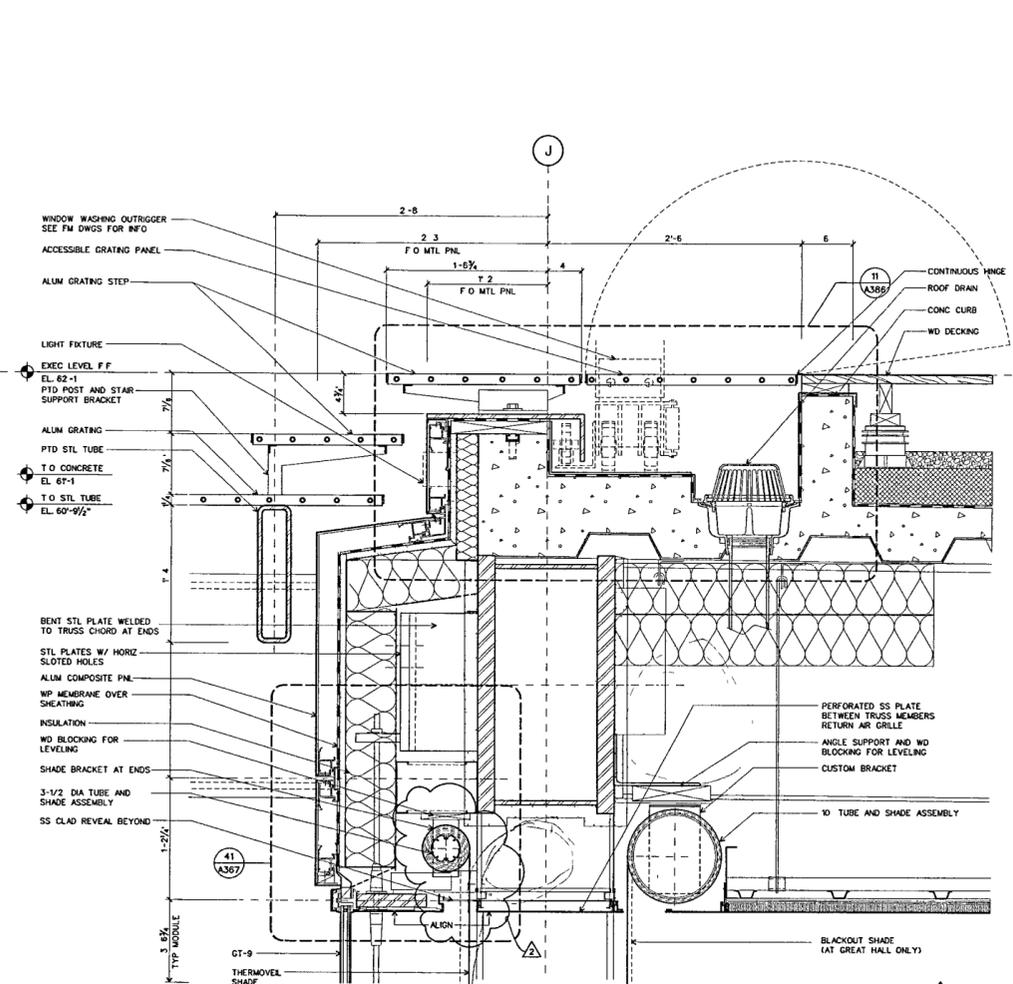


WALL SYSTEM D: DETAIL SECTION AT WEST HEAD
SCALE 1-1/2" = 1'-0"
D-CWDE01

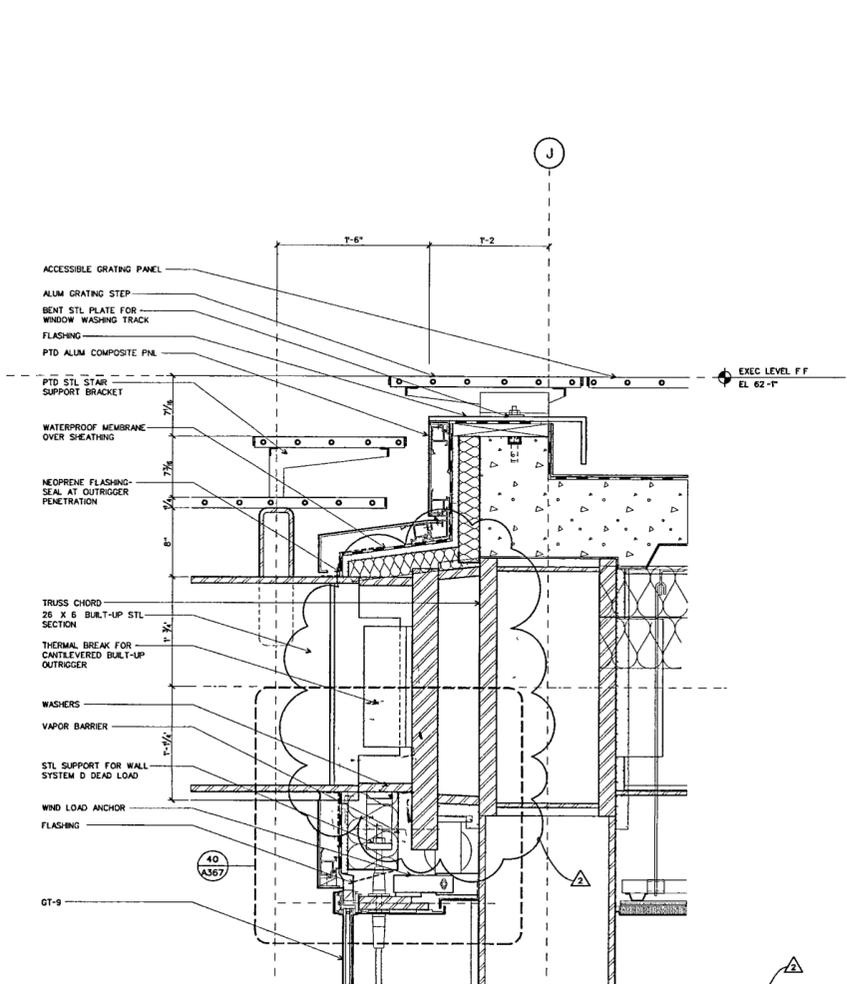


WALL SYSTEM D: SECTION AT WEST HEAD @ 30' MODULE
SCALE 1-1/2" = 1'-0"
D-CWDE01

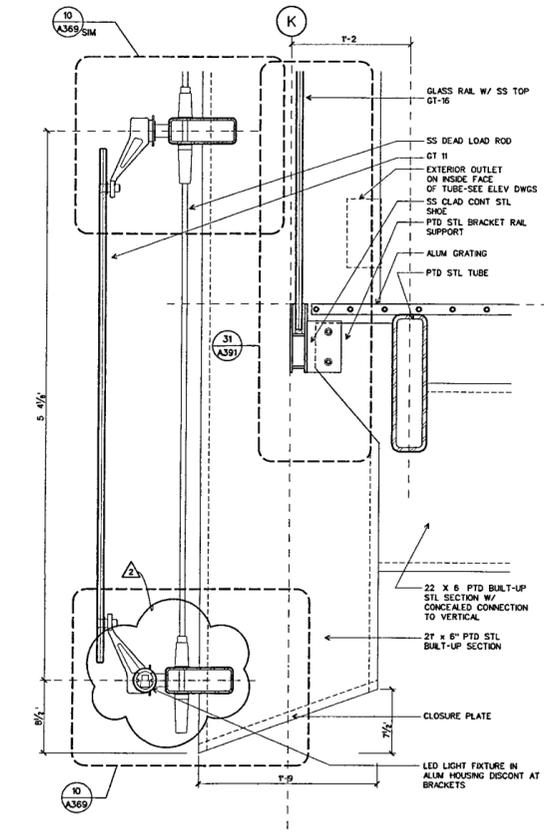

WALL SYSTEM E: DETAIL SECTION AT LOWER GRATING
SCALE 1-1/2" = 1'-0"
D-CWDE01

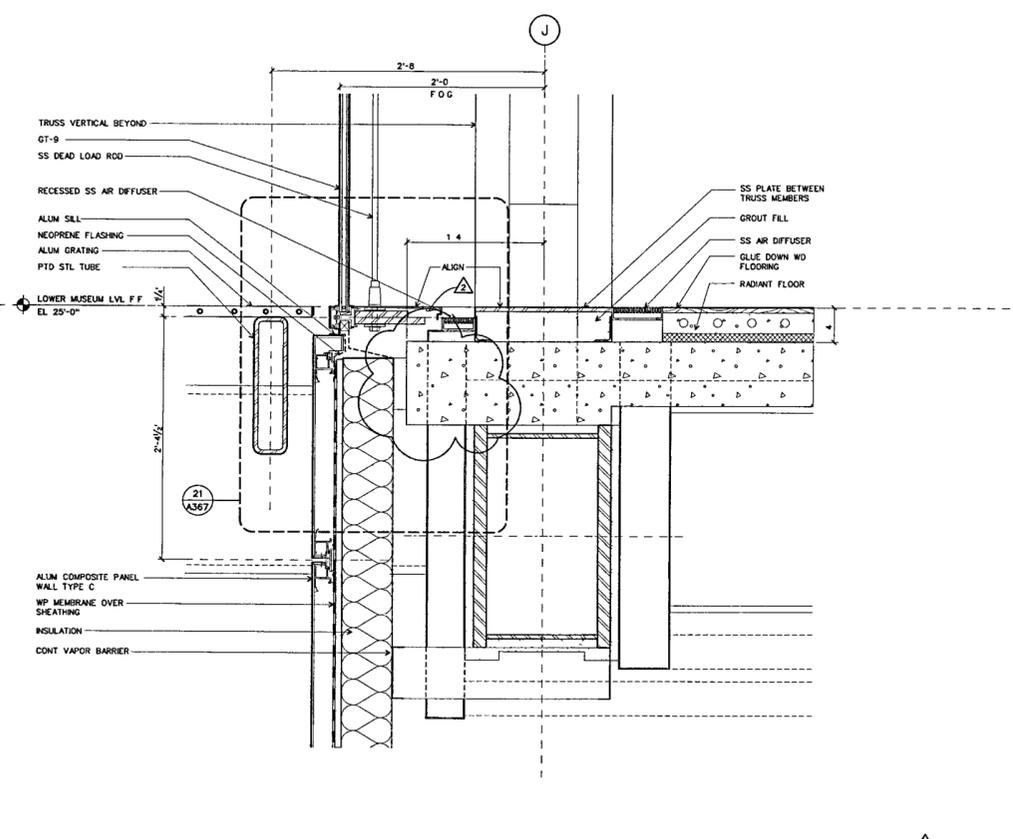

WALL SYSTEM D: DETAIL SECTION AT WEST SILL
SCALE 1-1/2" = 1'-0"
D-CWDE01

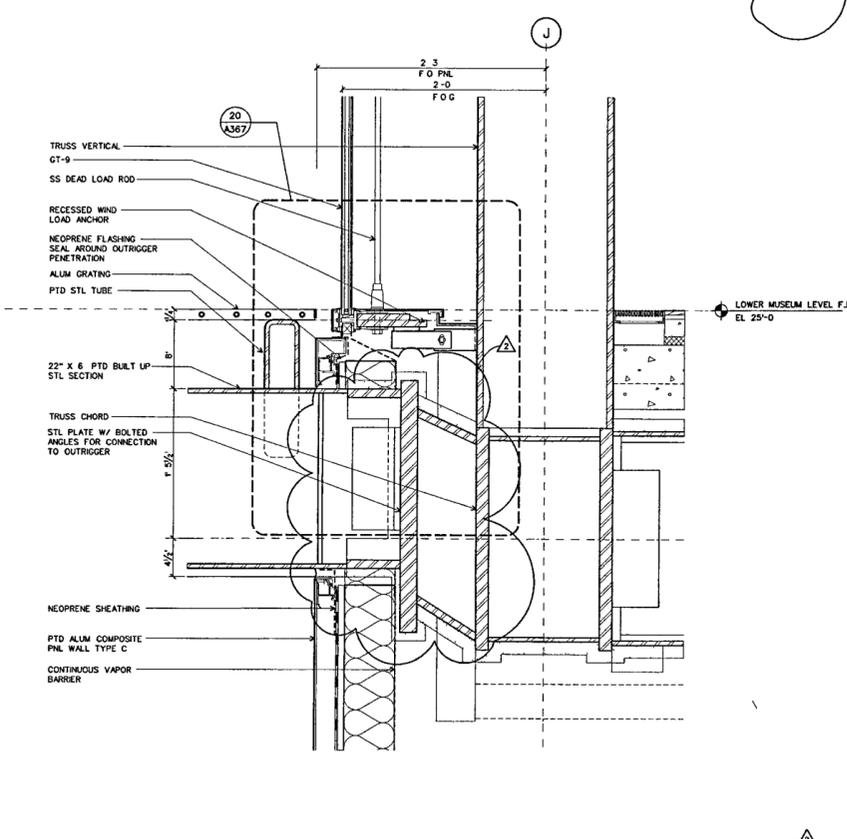

WALL SYSTEM D: SECTION AT WEST SILL @ 30' MODULE
SCALE 1-1/2" = 1'-0"
D-CWDE01

FOR OFFICIAL USE ONLY