

**WILLIAM J CLINTON
PRESIDENTIAL
CENTER**

LITTLE ROCK, ARKANSAS

Architect
POLSHEK PARTNERSHIP LLP
320 West 13th Street
New York, New York 10014
212 807 7171

Coordinating Architects
POLK STANLEY YEARY ARCHITECTS Ltd
700 South Schiller Street
Little Rock, Arkansas 72201
501 378 0878

WITSELL EVANS RASCO
901 West Third Street
Little Rock, Arkansas 72201
501 374 5300

WOODS CARADINE ARCHITECTS
2200 South Main Street
Little Rock, Arkansas 72206
501 374 4050

Landscape Architects
HARGREAVES ASSOCIATES
118 Magazine Street
Cambridge, Massachusetts 02139
617 661 0070


LANDSCAPE ARCHITECTURE, Inc.
2300 Cottondale Lane Suite 202
Little Rock, Arkansas 72202
501 374 5610

Structural Engineer
LESLIE E. ROBERTSON ASSOC., RLLP
30 Broad Street, 47th Floor
New York, New York 10004
212.750.9000


MEP Engineers
FLACK + KURTZ Inc.
475 Fifth Avenue
New York, New York 10017
212.532.9000

CROMWELL ARCHITECTS ENGINEERS
101 South Spring Street
Little Rock, Arkansas 72201
501 372-2900


Curtainwall Consultant
R. A. HEINTGES ARCHITECTS
126 Fifth Avenue, 9th Floor
New York, New York 10011
212 652-2968

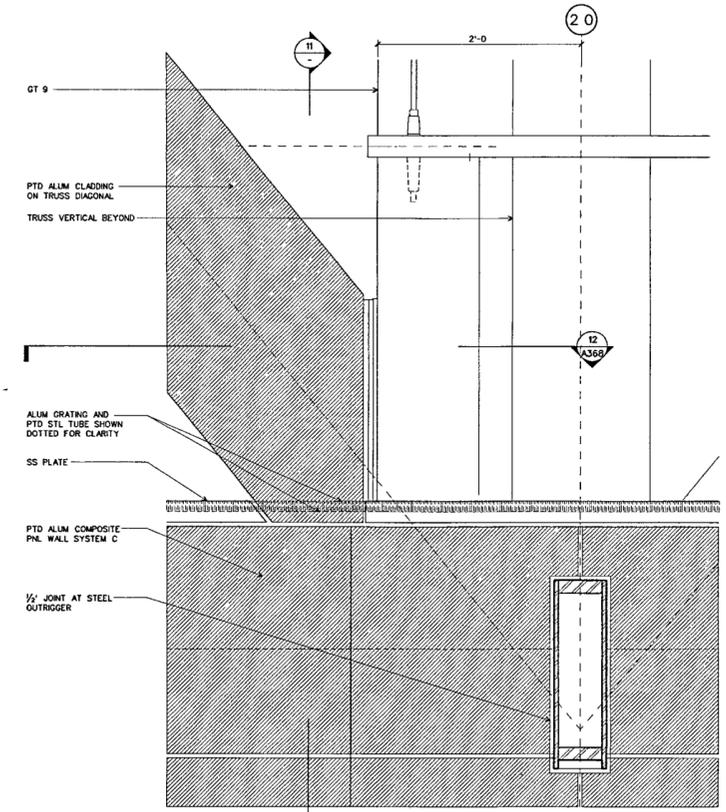


WALL SYSTEM D: ELEVATION OF SILL AT TRUSS 20
SCALE 1-1/2" = 1'-0" D-CWD01

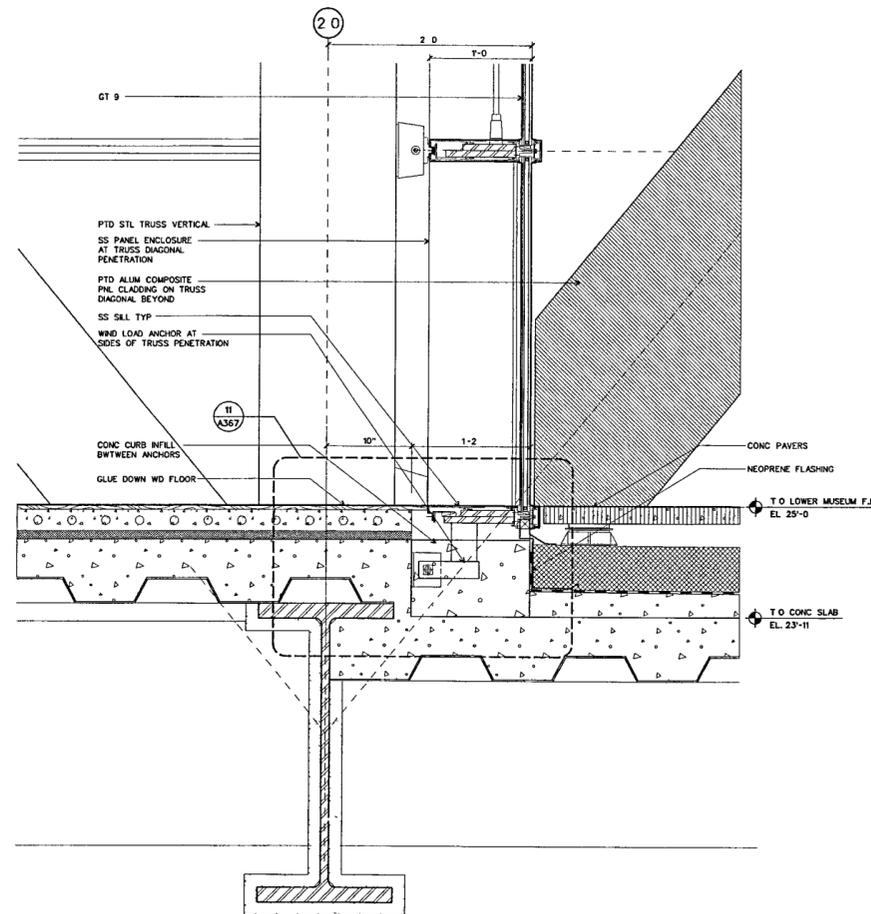

WALL SYSTEM D: SECTION OF SILL AT NORTH WALL 12
SCALE 1-1/2" = 1'-0" D-CWD01

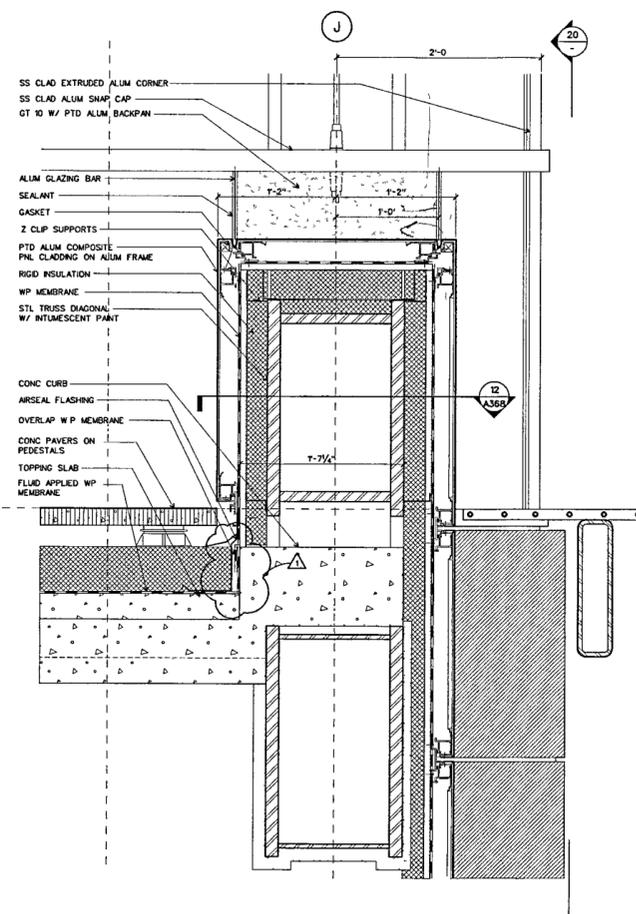


WALL SYSTEM D: SECTION AT TRUSS DIAGONAL 11
SCALE 1-1/2" = 1'-0" D-CWD01

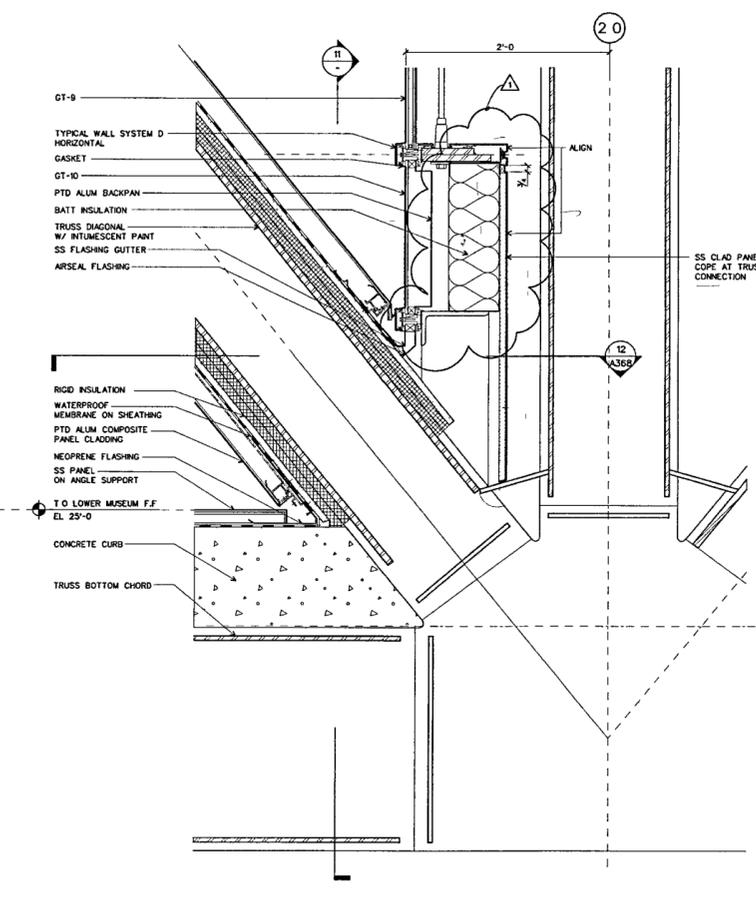

WALL SYSTEM D: SECTION OF SILL AT TRUSS 10
SCALE 1-1/2" = 1'-0" D-CWD01



100% Construction Documents	09/27/02
90% Progress Printing	08/30/02
100% Struct/CD Progress	07/01/02
100% Design Development	03/01/02
Issue	Date

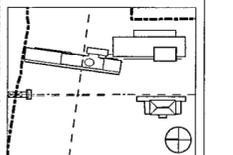

Job No 9008
Scale 1-1/2" = 1'-0"
Date September 27, 2002
Title

**WALL SYSTEMS D
SECTION DETAILS**

Sheet No
A366

FOR OFFICIAL USE ONLY