




WALL SYSTEM E: SECTION AT VERTICAL 41  
SCALE 3" = 1'-0" D-CWDE04

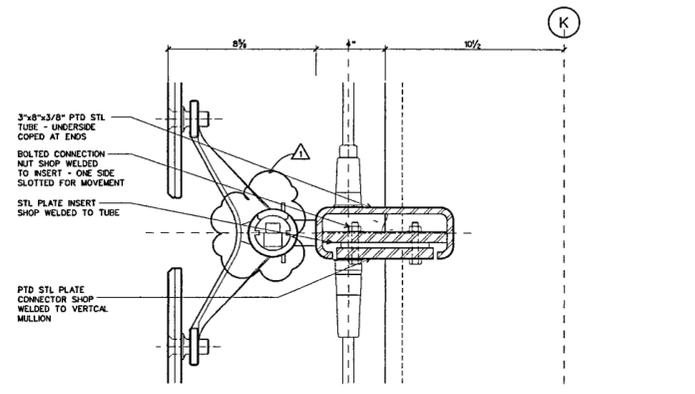


WALL SYSTEM E: SECTION AT VERTICAL 31  
SCALE 3" = 1'-0" D-CWDE04

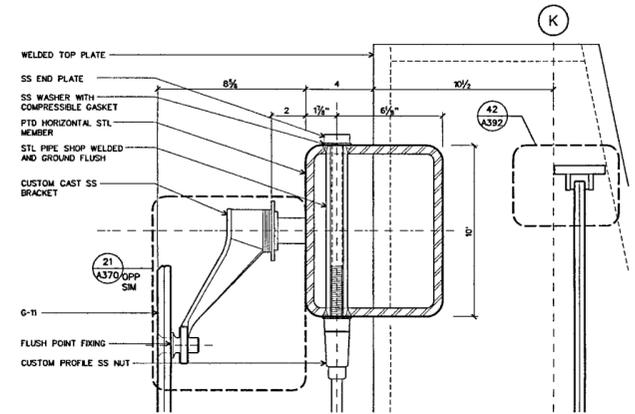


WALL SYSTEM E: SECTION AT TOP HORIZONTAL 40  
SCALE 3" = 1'-0" D-CWDE04

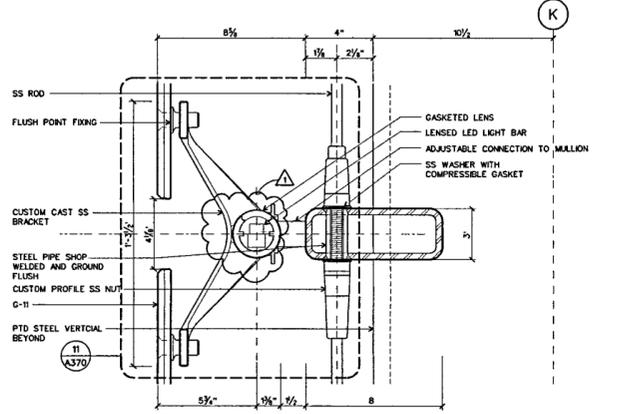


WALL SYSTEM E: SECTION AT TYP HORIZONTAL 30  
SCALE 3" = 1'-0" D-CWDE04

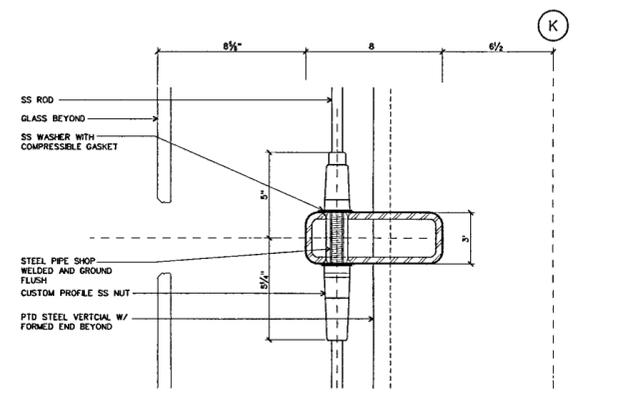


WALL SYSTEM E: SECTION AT HORIZONTAL 20  
SCALE 3" = 1'-0" D-CWDE04

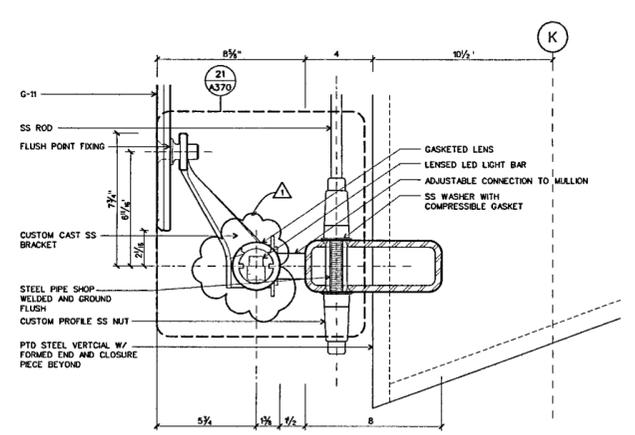

WALL SYSTEM E: SECTION AT BOTTOM HORIZONTAL 10  
SCALE 3" = 1'-0" D-CWDE04

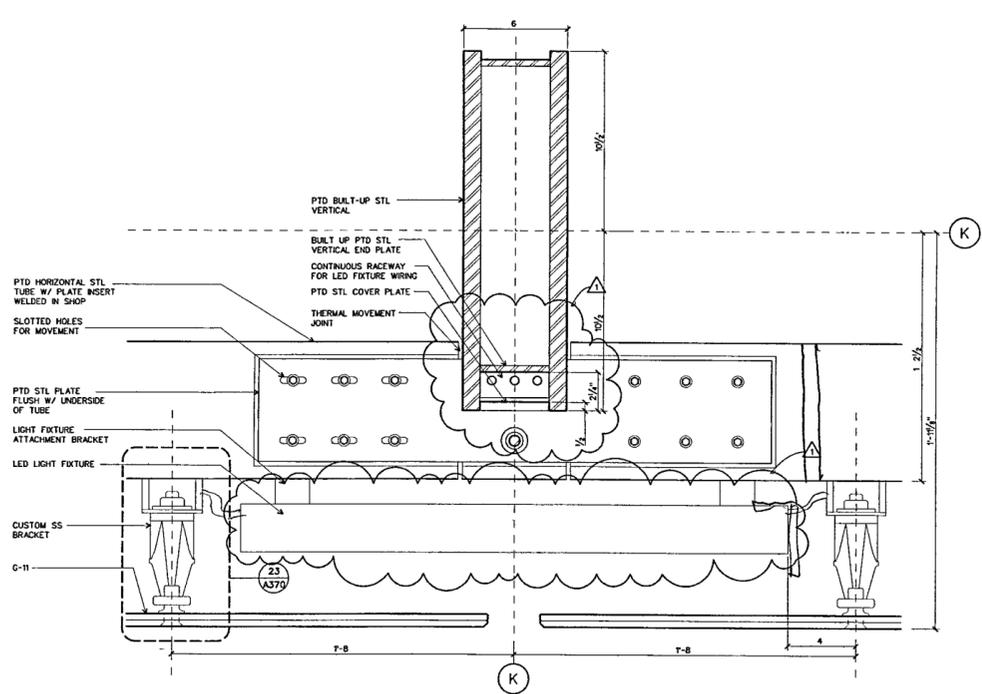

WALL SYSTEM E REFLECTED PLAN DETAIL AT VERTICAL 12  
SCALE 3" = 1'-0" D-CWDE04

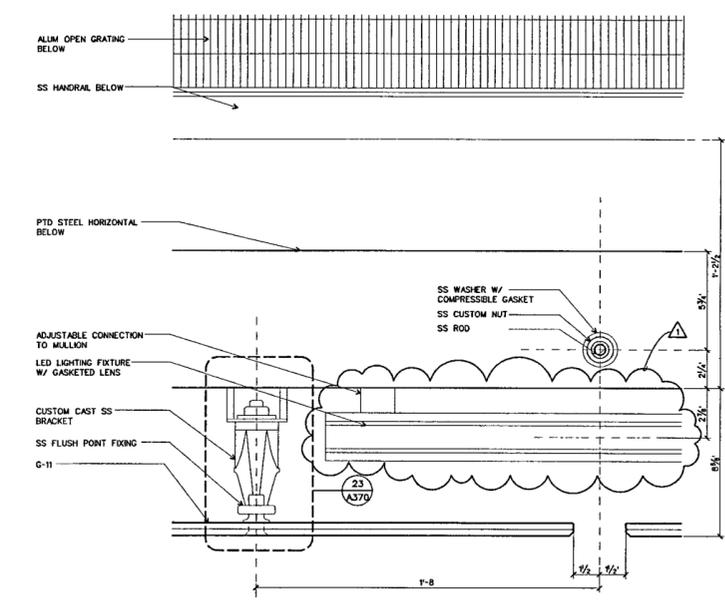

WALL SYSTEM E: PLAN DETAIL AT BRACKET 11  
SCALE 3" = 1'-0" D-CWDE04

**WILLIAM J CLINTON PRESIDENTIAL CENTER**

LITTLE ROCK, ARKANSAS

Architect  
POLISHEK PARTNERSHIP LLP  
320 West 13th Street  
New York, New York 10014  
212.607.7171

Coordinating Architects  
POLK STANLEY YEARY ARCHITECTS Ltd  
700 South Schiller Street  
Little Rock, Arkansas 72201  
501.378.0878

WITSELL EVANS RASCO  
901 West Third Street  
Little Rock, Arkansas 72201  
501.374.5300

WOODS CARADINE ARCHITECTS  
2200 South Main Street  
Little Rock, Arkansas 72206  
501.374.4060

Landscape Architects  
HARGREAVES ASSOCIATES  
115 Magazine Street  
Cambridge, Massachusetts 02139  
617.661.0070


LANDSCAPE ARCHITECTURE, Inc.  
2300 Cottondale Lane Suite 202  
Little Rock, Arkansas 72202  
501.374.5810

Structural Engineer  
LESLIE E. ROBERTSON ASSOC RLLP  
30 Broad Street, 47th Floor  
New York, New York 10004  
212.750.9000


MEP Engineers  
FLACK + KURTZ Inc.  
475 Fifth Avenue  
New York, New York 10017  
212.532.9600

CROMWELL ARCHITECTS ENGINEERS  
101 South Spring Street  
Little Rock, Arkansas 72201  
501.372.2900

Curtainwall Consultant  
R. A. HEINTGES ARCHITECTS  
126 Fifth Avenue, 8th Floor  
New York, New York 10011  
212.652-2968

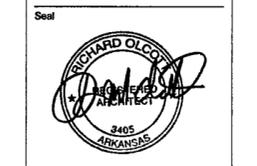

100% Construction Documents	06/27/02
90% Progress Printing	08/30/02
100% Struct./ CD Progress	07/01/02
100% Design Development	03/01/02
Issue	Date

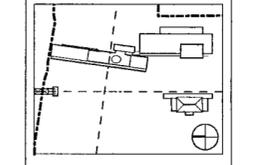

Job No 9908

Scale AS NOTED

Date September 27, 2002

Title WALL SYSTEM E PLAN AND SECTION DETAILS

Sheet No

**A369**