

**WILLIAM J CLINTON
PRESIDENTIAL
CENTER**

LITTLE ROCK, ARKANSAS

Architect
POLSHKE PARTNERSHIP LLP
320 West 13th Street
New York, New York 10014
212 607 7171

Coordinating Architects
POLK STANLEY YEARY ARCHITECTS LPA
700 South Schiller Street
Little Rock, Arkansas 72201
501 378 0878

WITSELL EVANS RASCO
601 West Third Street
Little Rock, Arkansas 72201
501 374 5300

WOODS GARADINE ARCHITECTS
2200 South Main Street
Little Rock, Arkansas 72206
501 374 4080

Landscape Architects
HARGREAVES ASSOCIATES
118 Magazine Street
Cambridge, Massachusetts 02139
617 661 0070

LANDSCAPE ARCHITECTURE, Inc.
2300 Cottondale Lane Suite 202
Little Rock, Arkansas 72202
501 374 6610

Structural Engineer
LESLIE E ROBERTSON ASSOC, RLLP
30 Broad Street, 47th Floor
New York, New York 10004
212 750 9000


MEP Engineers
FLACK + KURTZ Inc.
475 Fifth Avenue
New York, New York 10017
212 532 9600

CROMWELL ARCHITECTS ENGINEERS
101 South Spring Street
Little Rock, Arkansas 72201
501 372 2900

Curtainwall Consultant
R. A. HEINTGES ARCHITECTS
128 Fifth Avenue, 9th Floor
New York, New York 10011
212 653-2950




Addendum #2	11/15/02
100% Construction Documents	09/27/02
90% Progress Printing	08/30/02
100% Struct/CD Progress	07/01/02
Bridge Bldg Substructure	06/14/02
100% Design Development	03/01/02
Issue	Date

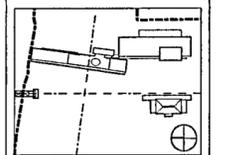


Job No 9908
Scale 1-1/2" = 1'-0"
Date September 27, 2002

Title
**WALL SYSTEM G
DETAIL PLANS AND
SECTIONS**


Sheet No
A375

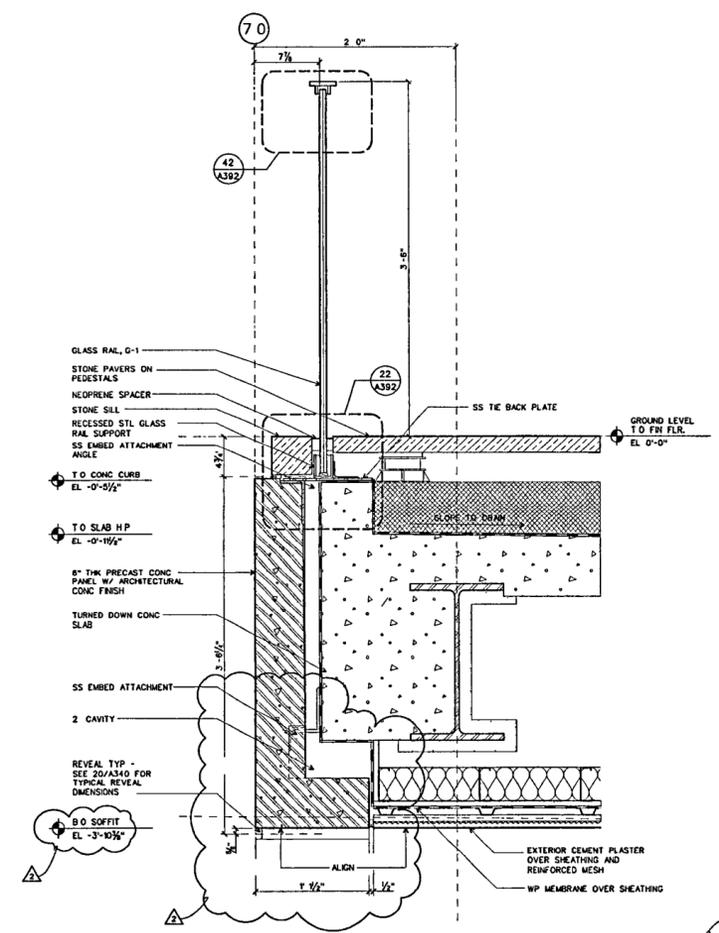


WALL SYSTEM G: DETAIL SECTION AT NORTH TERRACE
SCALE 1-1/2" = 1'-0" D-CWG02 22

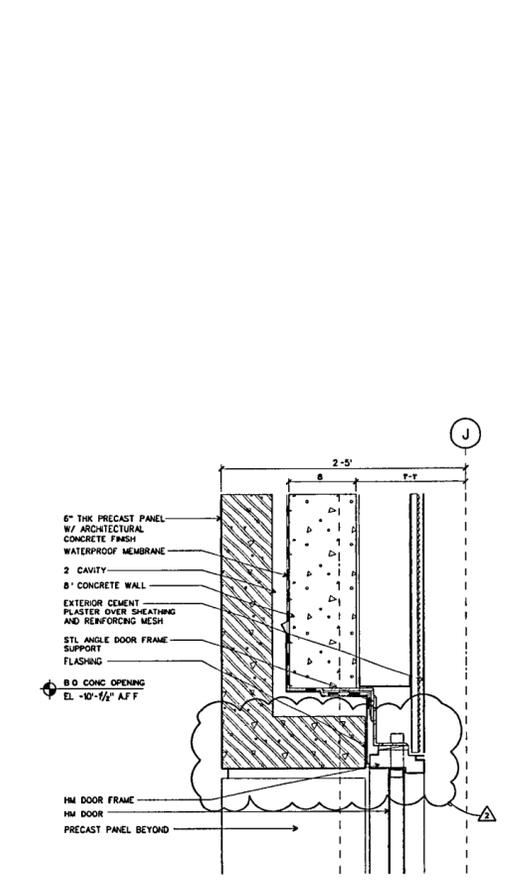


WALL SYSTEM G: DETAIL SECTION AT DOOR HEAD
SCALE 1-1/2" = 1'-0" D-CWG02 21

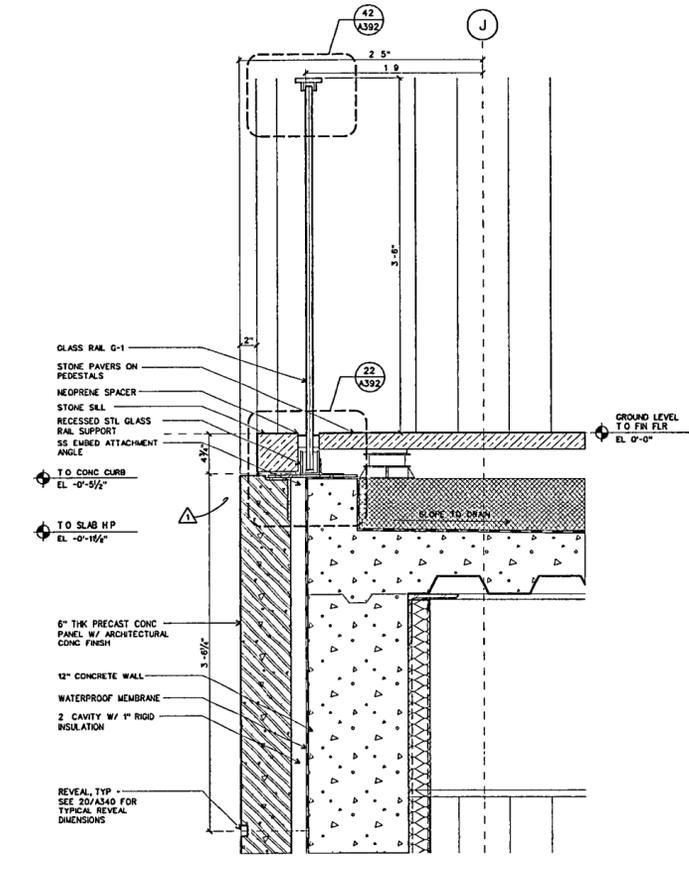


WALL SYSTEM G: DETAIL SECTION AT EAST TERRACE
SCALE 1-1/2" = 1'-0" D-CWG02 20

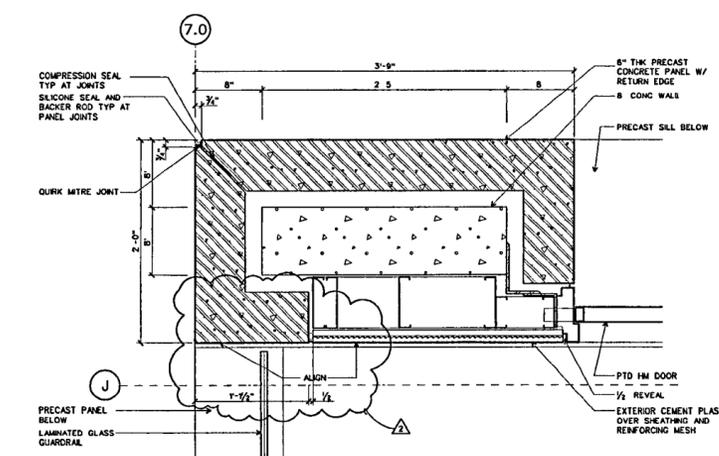

WALL SYSTEM G: PLAN DETAIL AT DOOR JAMB
SCALE 1-1/2" = 1'-0" D-CWG02 12

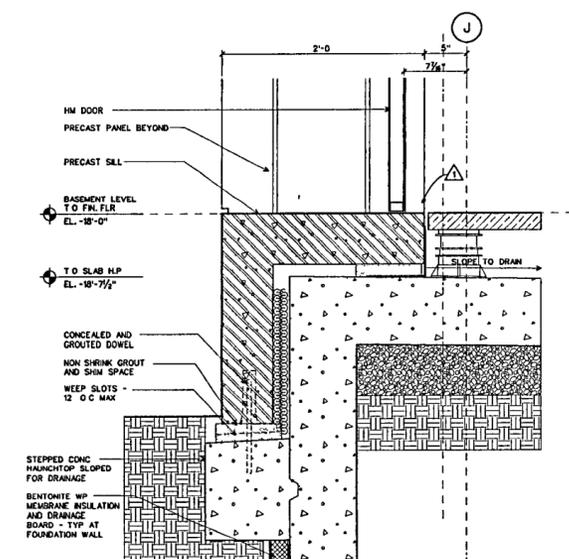

WALL SYSTEM G: DETAIL SECTION AT DOOR SILL
SCALE 1-1/2" = 1'-0" D-CWG02 11

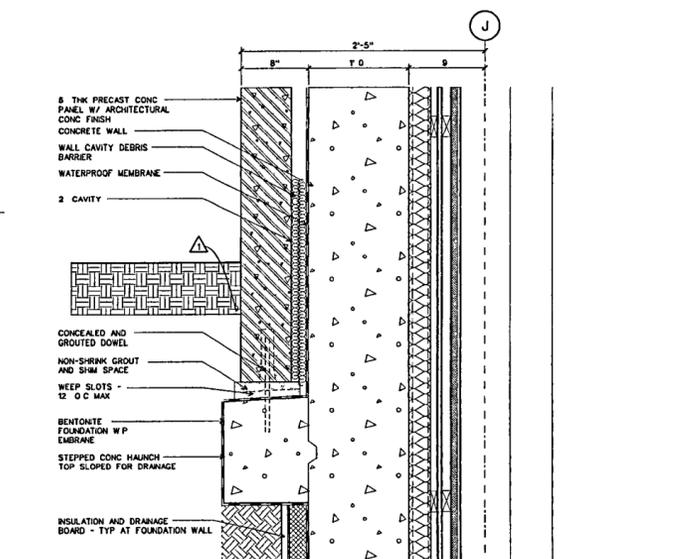

WALL SYSTEM G: DETAIL SECTION AT SILL
SCALE 1-1/2" = 1'-0" D-CWG02 10