

**WILLIAM J. CLINTON
PRESIDENTIAL
CENTER**

LITTLE ROCK, ARKANSAS

Architect

POLSHEK PARTNERSHIP LLP
320 West 13th Street
New York, New York 10014
212.807 7171

Coordinating Architects

POLK STANLEY YEARY ARCHITECTS Ltd
700 South Schiller Street
Little Rock, Arkansas 72201
501.378 0878

WITSELL EVANS & RASCO
901 West Third Street
Little Rock, Arkansas 72201
501.374.5300

WOODS GARADINE ARCHITECTS
2200 South Main Street
Little Rock, Arkansas 72206
501.374.4060

Landscape Architects

HARGREAVES ASSOCIATES
118 Magazine Street
Cambridge, Massachusetts 02138
617 661 0070

LANDSCAPE ARCHITECTURE, Inc.
2300 Cottondale Lane Suite 202
Little Rock, Arkansas 72202
501.374.5610

Structural Engineer

LESLIE E. ROBERTSON ASSOC., PLLP
30 Broad Street, 47th Floor
New York, New York 10017
212.750 9000

MEP Engineers

FLACK + KURTZ Inc.
476 Fifth Avenue
New York, New York 10017
212.532 9600

CIVIL ARCHITECTS ENGINEERS

101 South Spring Street
Little Rock, Arkansas 72201
501.372.2900


Curtilwall Consultant

R.A. HEINTGES ARCHITECTS
128 Fifth Avenue, 9th Floor
New York, New York 10011
212.652 2968

Seal



Revision #	Date
1	11/15/02
2	10/23/02
3	09/27/02
4	08/30/02
5	07/01/02


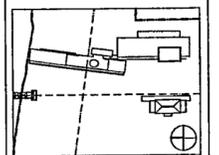


Job No. PPA 9908
PSY 426D
Scale 1 1/2" = 1'-0"
Date September 27, 2002
Title

**WALL SYSTEM H GLASS-
PLANS & SECTIONS**

Sheet No. **A377**

FOR OFFICIAL USE ONLY

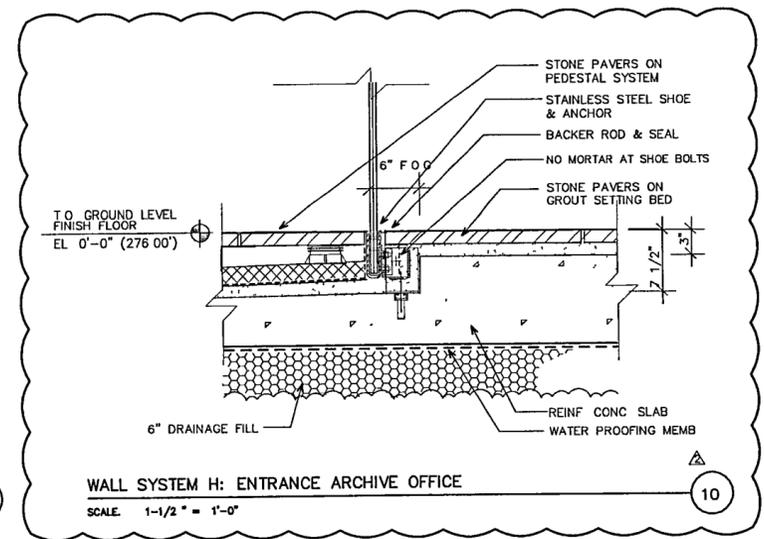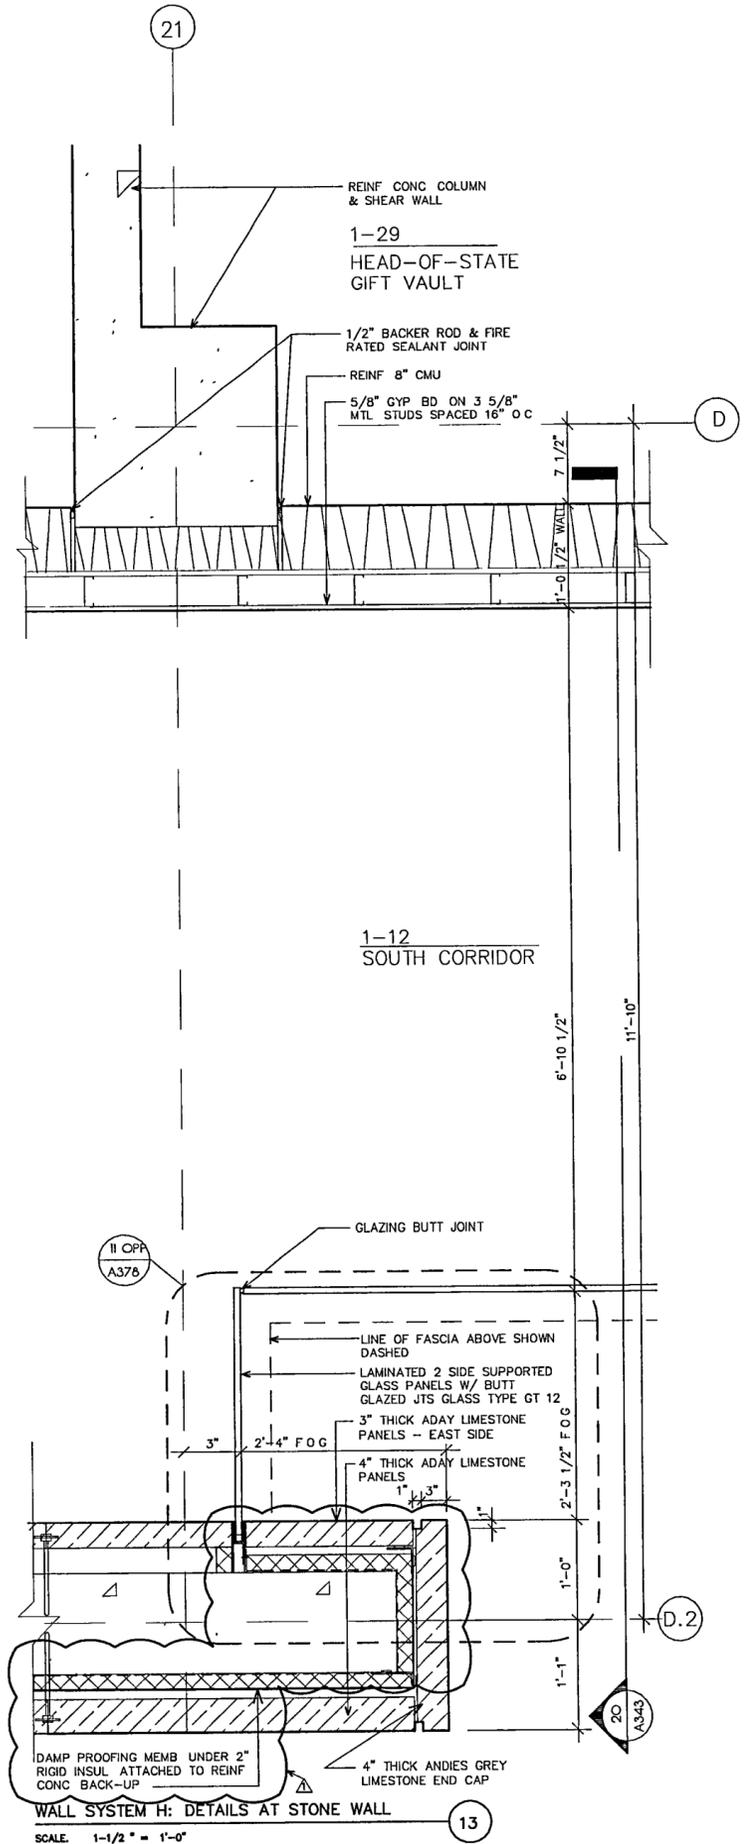

FRIDAY NOVEMBER 15 2002 12 01 PM

DETAIL NOT USED
SCALE 1-1/2" = 1'-0"