

**WILLIAM J. CLINTON
PRESIDENTIAL
CENTER**

LITTLE ROCK, ARKANSAS

Architect
POLSHAK PARTNERSHIP LLP
320 West 13th Street
New York, New York 10014
212.607.7171

Coordinating Architects
POLK STANLEY YEARY ARCHITECTS Ltd
700 South Schiller Street
Little Rock, Arkansas 72201
501.378.0878

WITBELL EVANS & RASCO
801 West Third Street
Little Rock, Arkansas 72201
501.374.5300

WOODS CARADINE ARCHITECTS
2200 South Main Street
Little Rock, Arkansas 72208
501.374.4060

Landscape Architects
HARGREAVES ASSOCIATES
118 Magazine Street
Cambridge, Massachusetts 02139
617.661.0070

LANDSCAPE ARCHITECTURE, Inc.
2300 Cotondale Lane Suite 202
Little Rock, Arkansas 72202
501.374.5610

Structural Engineer
LESLIE E ROBERTSON ASSOC., RLLP
30 Broad Street, 47th Floor
New York, New York 10017
212.750.8000


MEP Engineers
FLACK + KURTZ Inc.
475 Fifth Avenue
New York, New York 10017
212.532.9600

CROMWELL ARCHITECTS ENGINEERS
101 South Spring Street
Little Rock, Arkansas 72201
501.372.2900

Curtainwall Consultant
R.A. HEINTGES ARCHITECTS
128 Fifth Avenue, 9th Floor
New York, New York 10011
212.682.2968



ADDENDUM #	Date
ADDENDUM #2	11/15/02
ADDENDUM #1	10/23/02
100% Construction Documents	09/27/02
80% Progress Printing	08/30/02
100% Structural/CD Progress	07/01/02
100% Steel & Concrete CD	05/15/02
100% Architectural CD Progress	03/01/02
Issue	Date

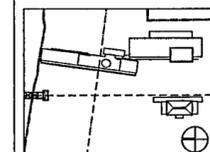

Job No PPA 9908
PSY 428D

Scale 3" = 1'-0"

Date September 27, 2002


Title

**WALL SYSTEM H GLASS:
PLAN & SECTION
DETAILS**

Sheet No


A378

FOR OFFICIAL USE ONLY

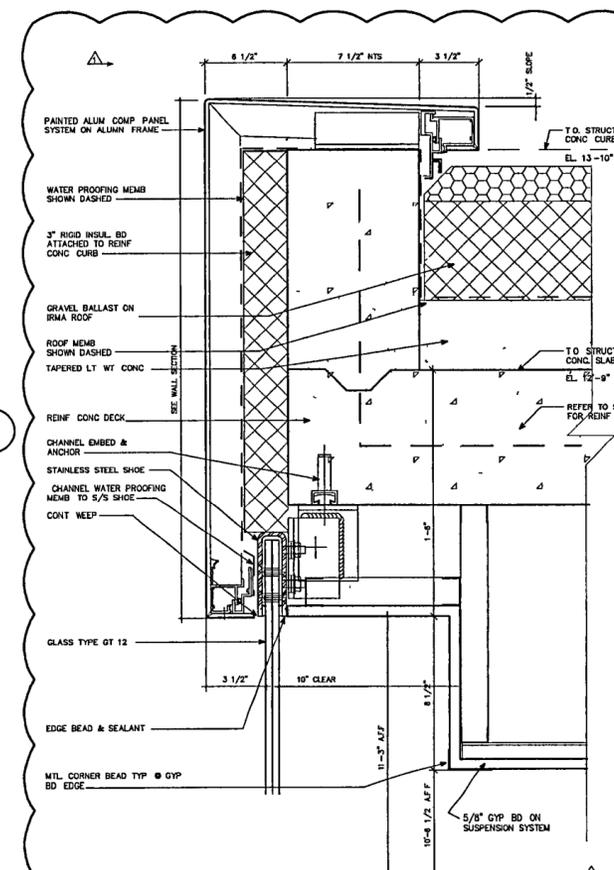


WALL SYSTEM H: DETAIL AT ROOF

SCALE 3" = 1'-0"

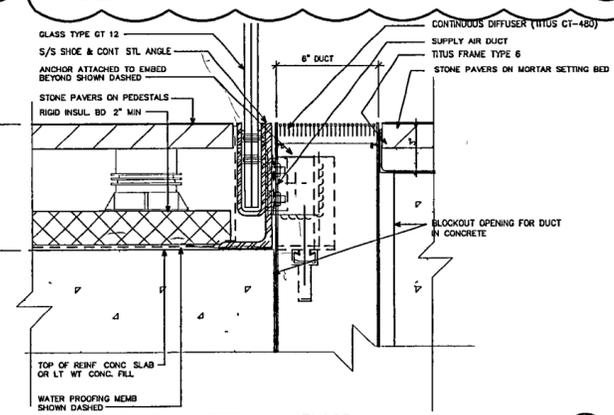


WALL SYSTEM H: DETAIL AT FLOOR

SCALE 3" = 1'-0"

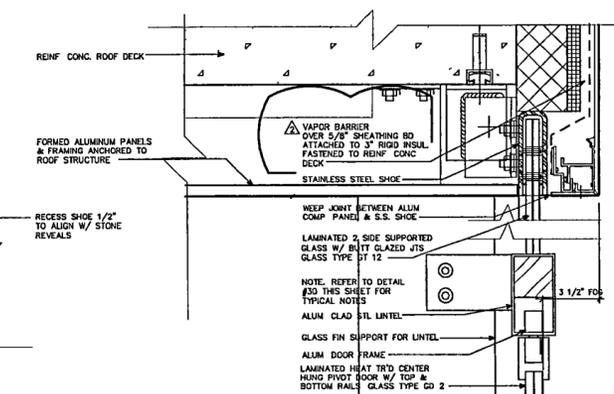


WALL SYSTEM H: DETAIL AT CEILING

SCALE 3" = 1'-0"

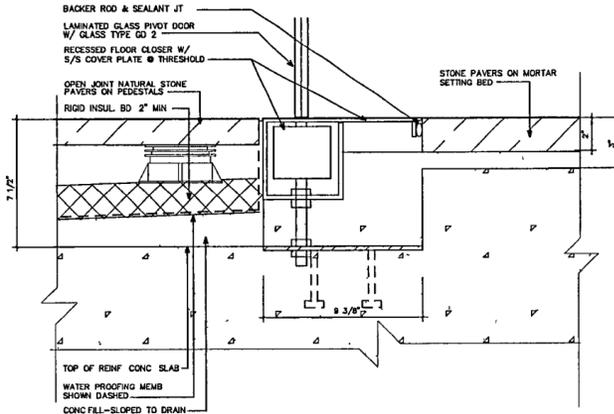


WALL SYSTEM H: DETAIL AT DOOR THRESHOLD

SCALE 3" = 1'-0"

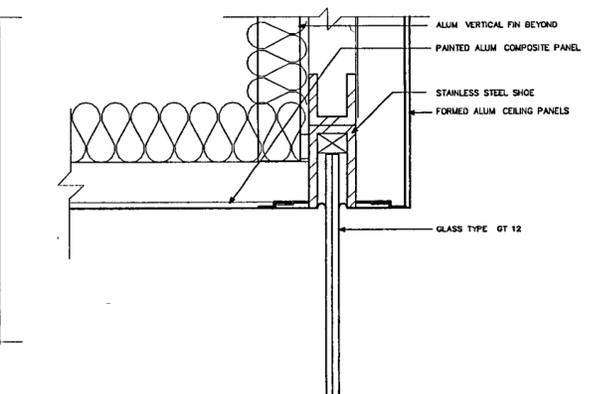


WALL SYSTEM H: TYP. DETAIL HEAD AT ENTRANCE

SCALE 3" = 1'-0"

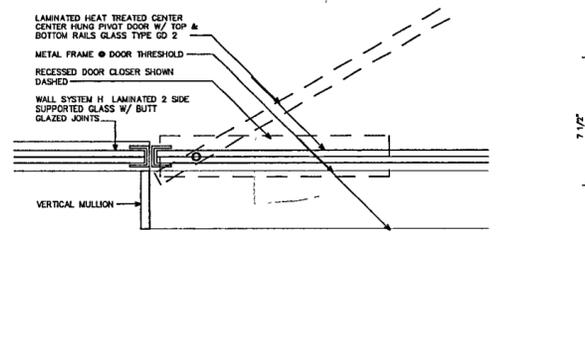


WALL SYSTEM H: PLAN DET. AT GLASS DOOR EAST

SCALE 3" = 1'-0"

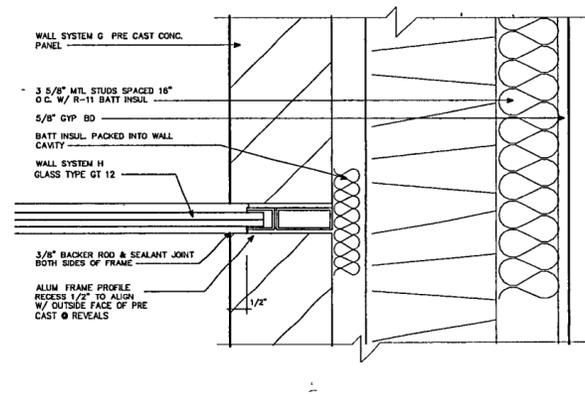


WALL SYSTEM H: PLAN DET. AT WALL SYSTEM G

SCALE 3" = 1'-0"

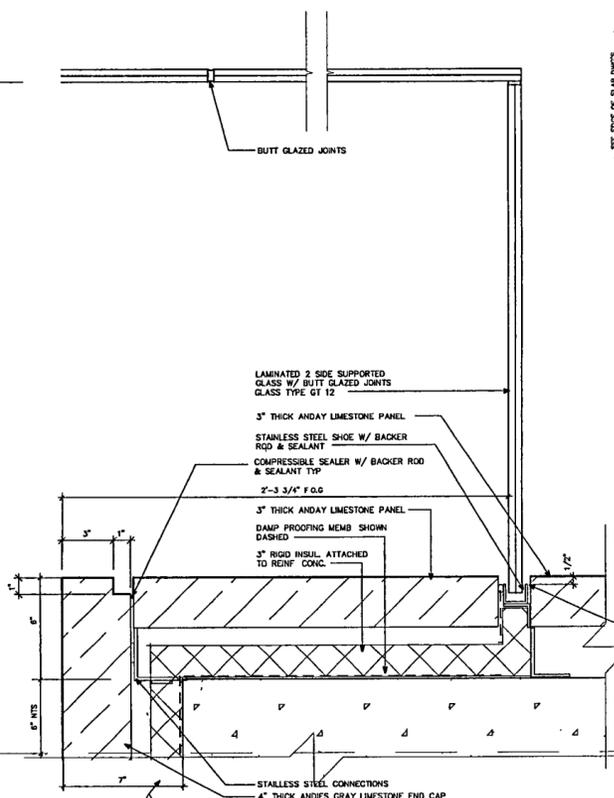

WALL SYSTEM H: PLAN DET. AT OPENINGS IN STONE WALL

SCALE 3" = 1'-0"

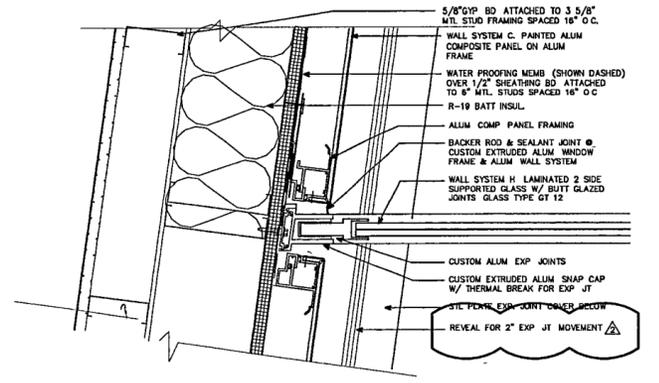

WALL SYSTEM H: PLAN DET. AT WALL SYSTEM C EAST

SCALE 3" = 1'-0"

FRIDAY, NOVEMBER 15, 2002 12:03 PM