

**WILLIAM J. CLINTON
PRESIDENTIAL
CENTER**

LITTLE ROCK, ARKANSAS

Architect
POLSHEK PARTNERSHIP LLP
320 West 13th Street
New York, New York 10014
212.807.7171

Coordinating Architects
POLK STANLEY YEARY ARCHITECTS Ltd
700 South Schiller Street
Little Rock, Arkansas 72201
501.378.0878

WITSELL EVANS & RASCO
901 West Third Street
Little Rock, Arkansas 72201
501.374.5300

WOODS CARADINE ARCHITECTS
2200 South Main Street
Little Rock, Arkansas 72206
501.374.4050

Landscape Architects
HARGREAVES ASSOCIATES
118 Magazine Street
Cambridge, Massachusetts 02139
617.861.0070


LANDSCAPE ARCHITECTURE, Inc.
2500 Cottondale Lane Suite 202
Little Rock, Arkansas 72202
501.374.6610

Structural Engineer
LESLIE E. ROBERTSON ASSOC., RLLP
30 Broad Street, 47th Floor
New York, New York 10017
212.750.9000


MEP Engineers
FLACK + KURTZ Inc.
475 Fifth Avenue
New York, New York 10017
212.532.8600

OROMWELL ARCHITECTS ENGINEERS
101 South Spring Street
Little Rock, Arkansas 72201
501.372.2900

Curtainwall Consultant
R.A. HENTGES ARCHITECTS
128 Fifth Avenue, 8th Floor
New York, New York 10011
212.652.2966

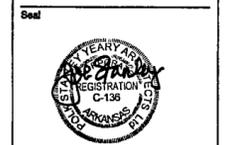


Revision	Date
Revision #4	11/22/02
Revision #3	11/15/02
Revision #1	10/23/02
100% Construction Documents	08/27/02
80% Progress Printing	08/30/02
100% Permit/CD Progress	07/01/02
100% Permit & Concrete CD	
Architectural CD Progress	05/15/02
100% Design Development	03/01/02
Issue	Date

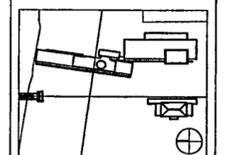


Job No PPA 9008
PSY 426D
Scale 1/2" = 1'-0"
Date September 27, 2002
Title

**SYSTEM F&H:
PLAN & SECTIONS**

Sheet No
A379

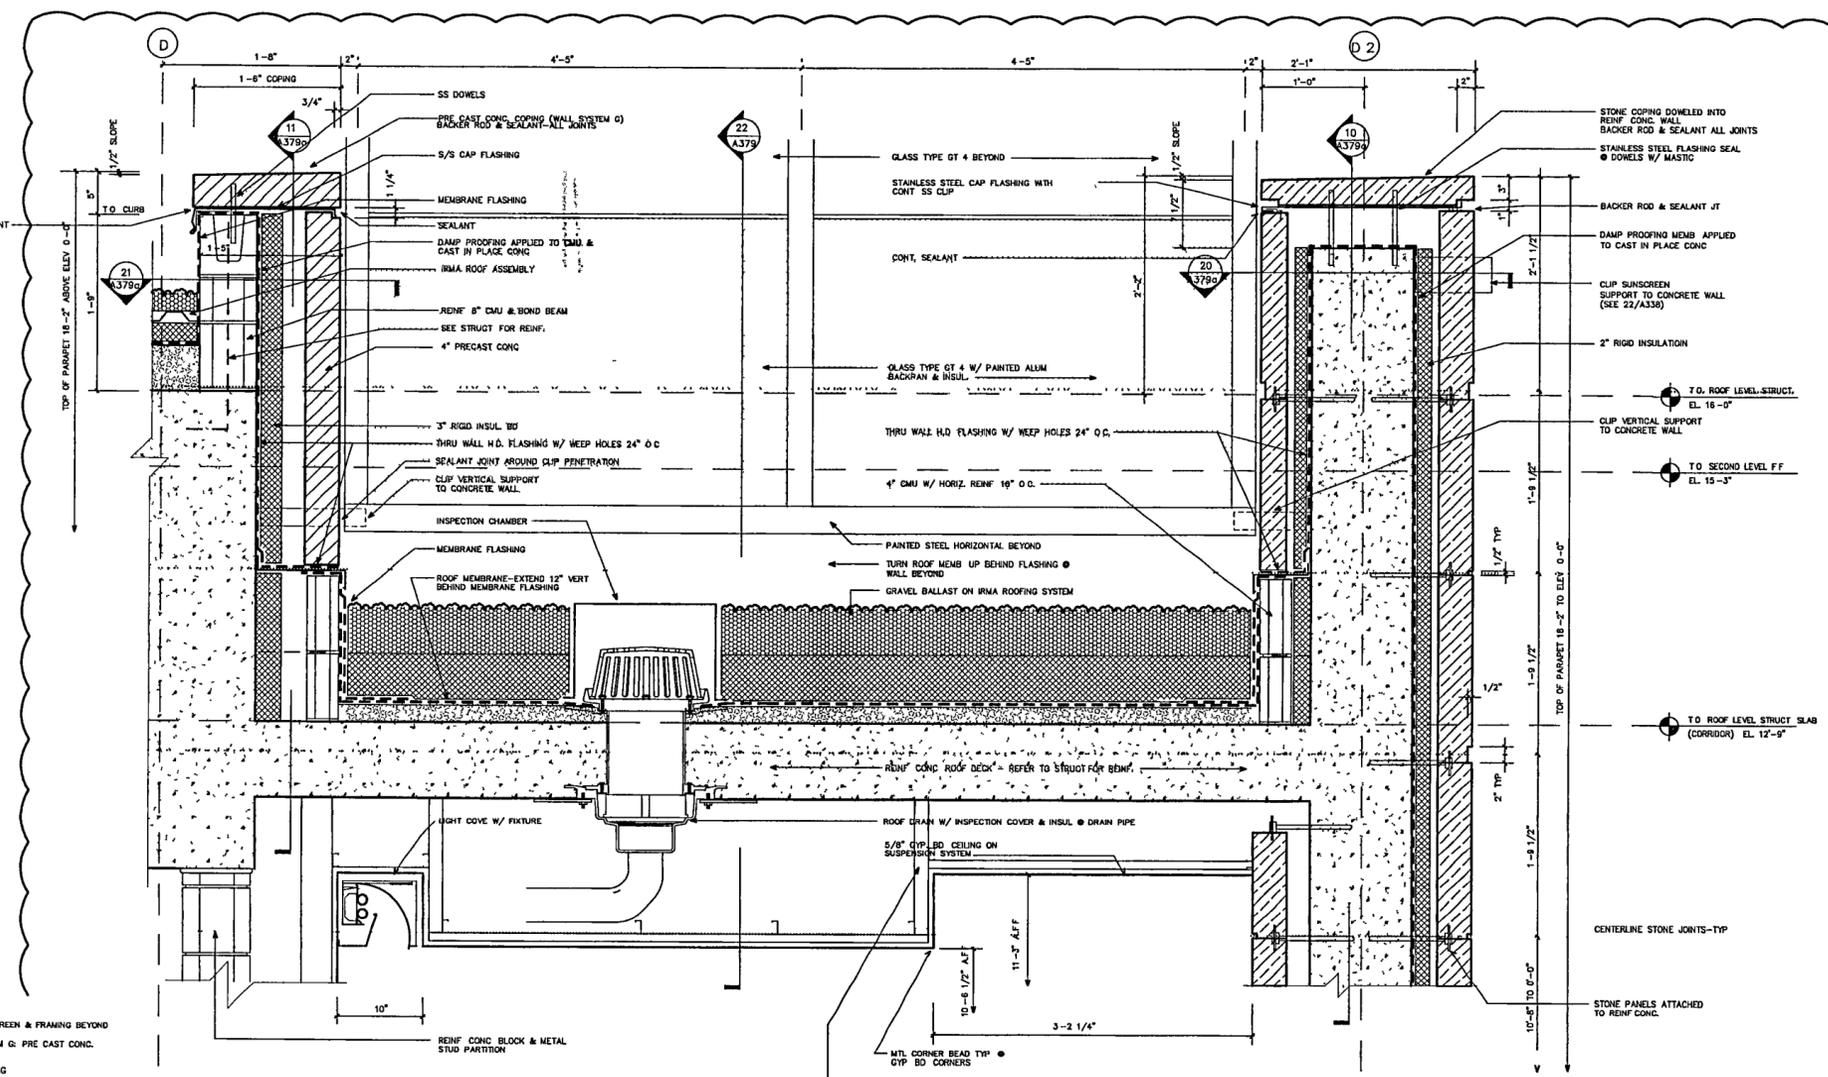

WALL SYSTEM H: EAST-WEST SECTION
SCALE 1-1/2" = 1'-0"

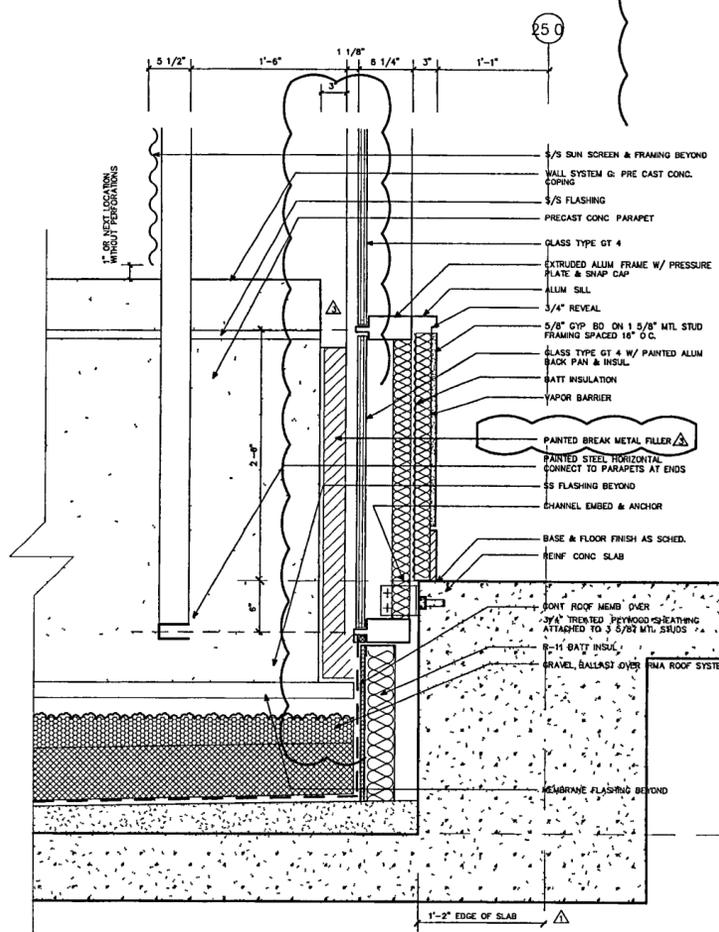

WALL SYSTEM H: SECTION AT WALL SYSTEM F
SCALE 1-1/2" = 1'-0"

MONDAY, DECEMBER 02, 2002 10:31 AM

FOR OFFICIAL USE ONLY