





100% Construction Documents	09/27/02
90% Progress Printing	08/30/02
100% Struct./CD Progress	07/01/02
100% Design Development	03/01/02
Issue	Date


Job No	9908
Scale	1-1/2" = 1'-0"
Date	September 27, 2002
Title	

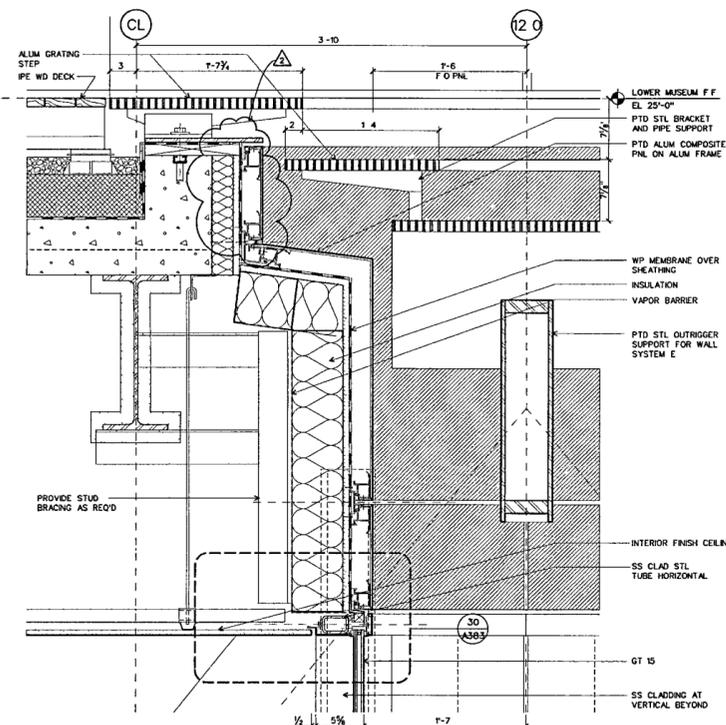


WALL SYSTEM K: DETAIL SECTION AT SOUTH HEAD 30
SCALE 1-1/2" = 1'-0" D-CWK01

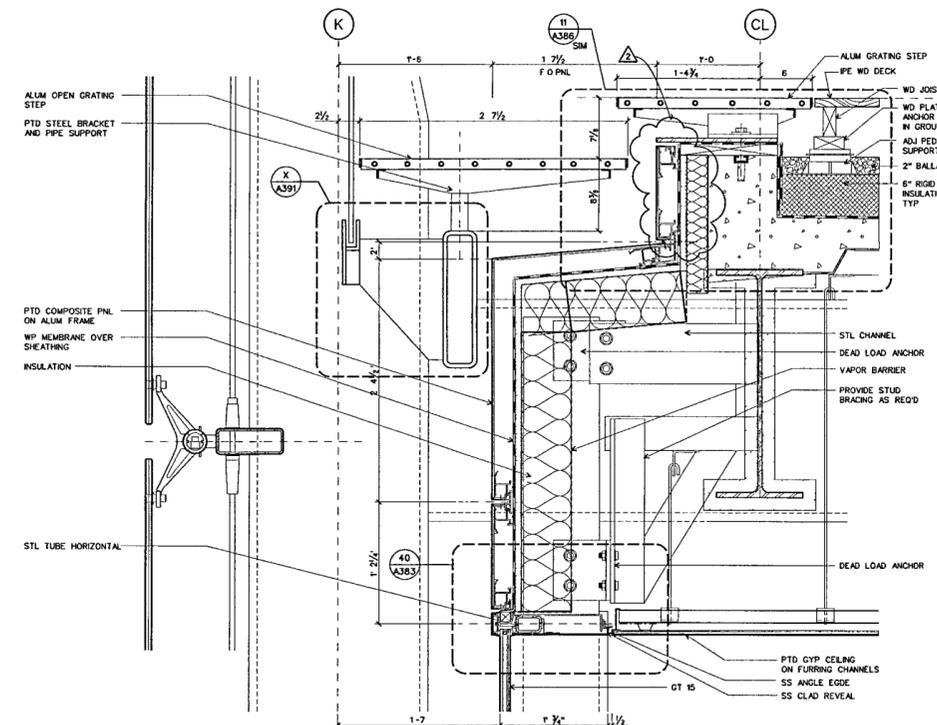


WALL SYSTEM K: DETAIL SECTION AT WEST HEAD 31
SCALE 1-1/2" = 1'-0" D-CWK01

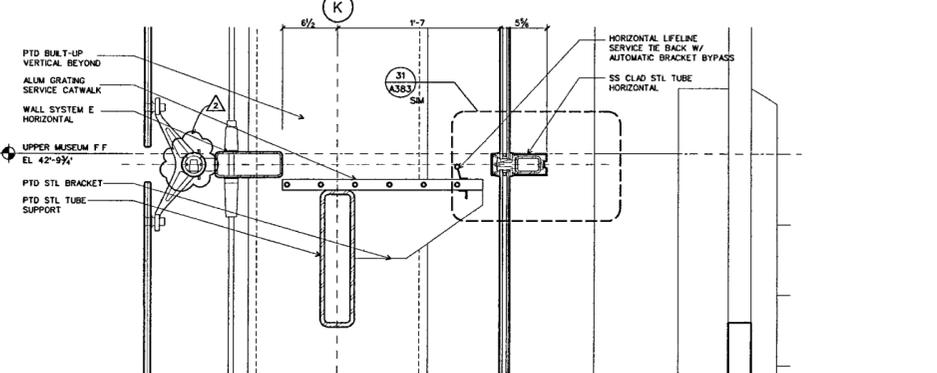


WALL SYSTEM K: SECTION AT UPPER MUSEUM SILL 21
SCALE 1-1/2" = 1'-0" D-CWK01

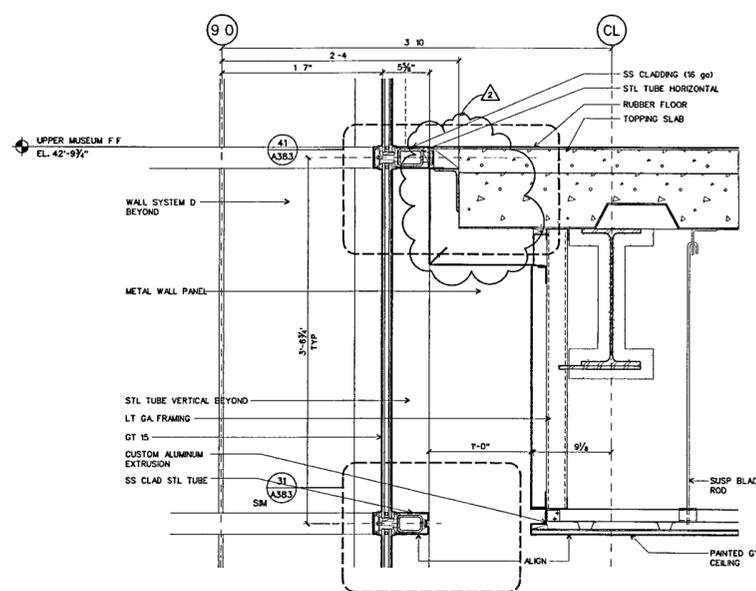


WALL SYSTEM K: SECTION AT UPPER MUSEUM SILL 22
SCALE 1-1/2" = 1'-0" D-CWK01

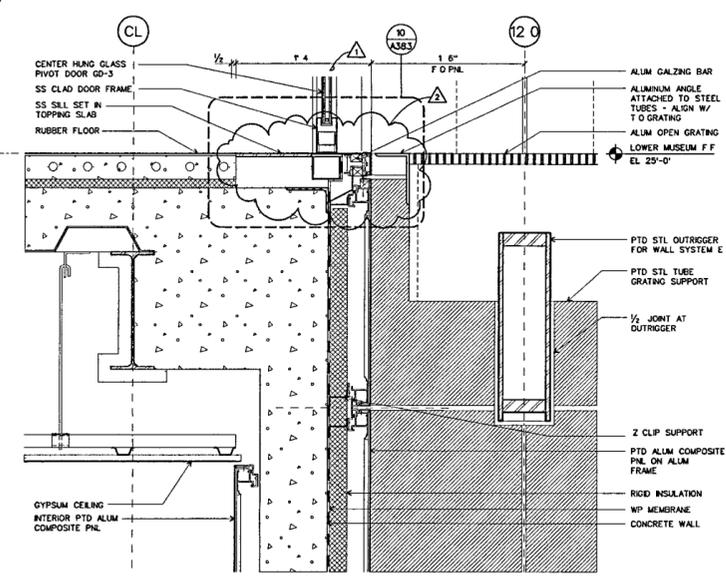

WALL SYSTEM K: DETAIL SECTION AT DOOR SILL 10
SCALE 1-1/2" = 1'-0" D-CWK01

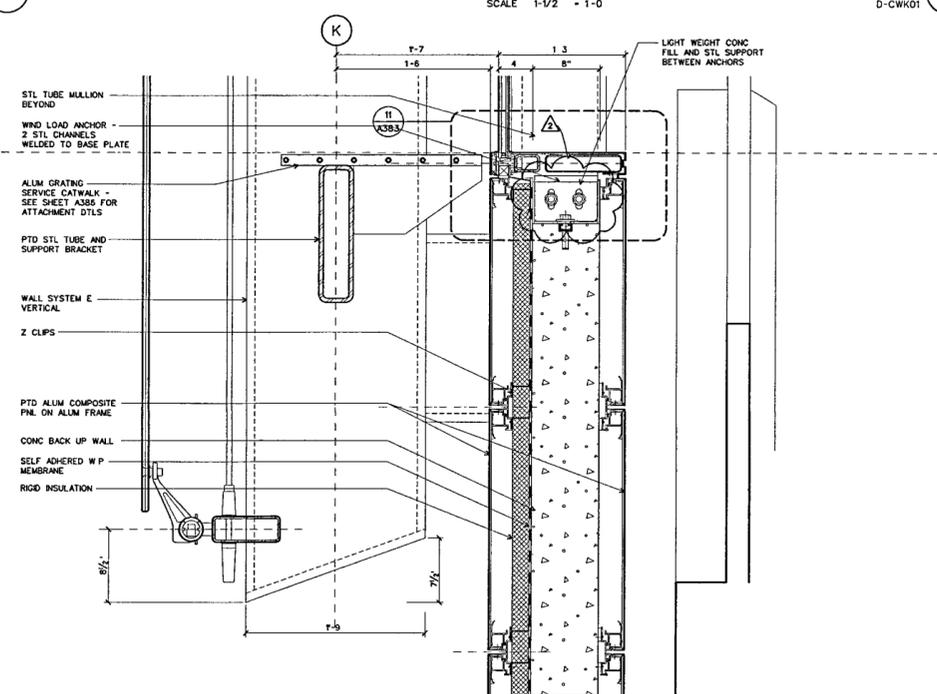

WALL SYSTEM K: DETAIL SECTION AT WEST SILL 11
SCALE 1-1/2" = 1'-0" D-CWK01

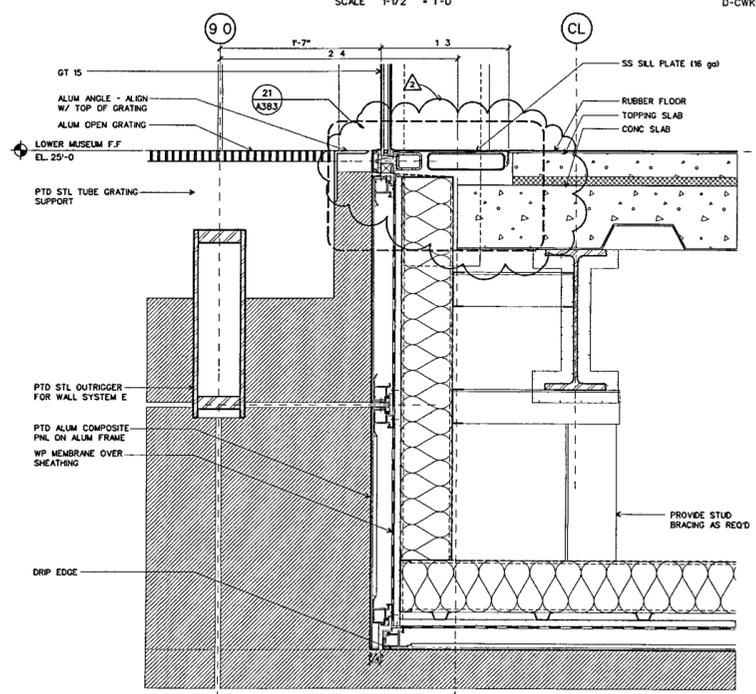

WALL SYSTEM K: DETAIL SECTION AT NORTH SILL 12
SCALE 1-1/2" = 1'-0" D-CWK01