


Seal



100% Construction Documents 09/27/02
90% Progress Printing 08/30/02
Issue Date

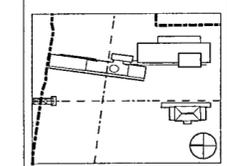

Job No 9908
Scale AS NOTED

Date September 27, 2002




Title

MUSEUM BUILDING
ROOF DETAILS - EXEC
LVL ROOF & SKYLIGHT


Sheet No

A388


FOR OFFICIAL USE ONLY

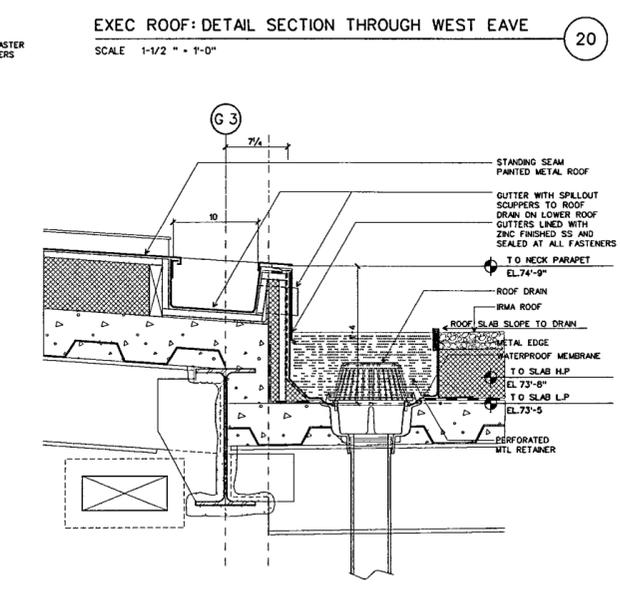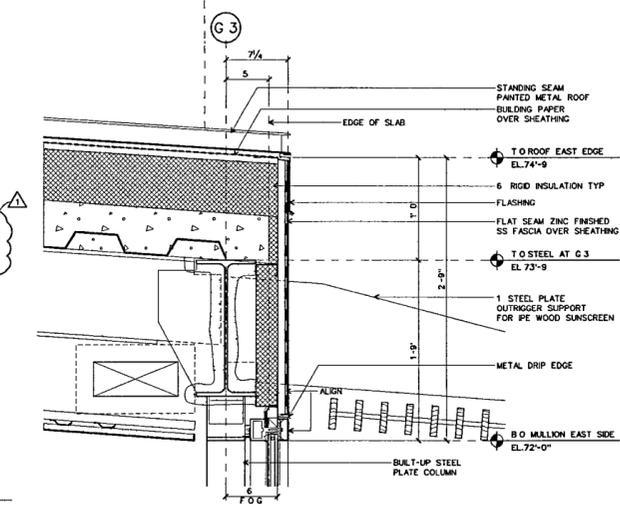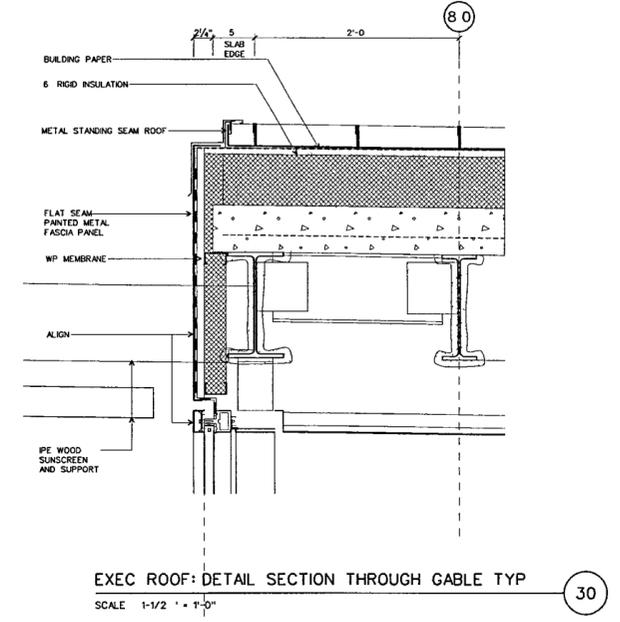


EXEC ROOF: DETAIL SECTION OF TRANSITION TO CORE ROOF
SCALE 1-1/2" = 1'-0"

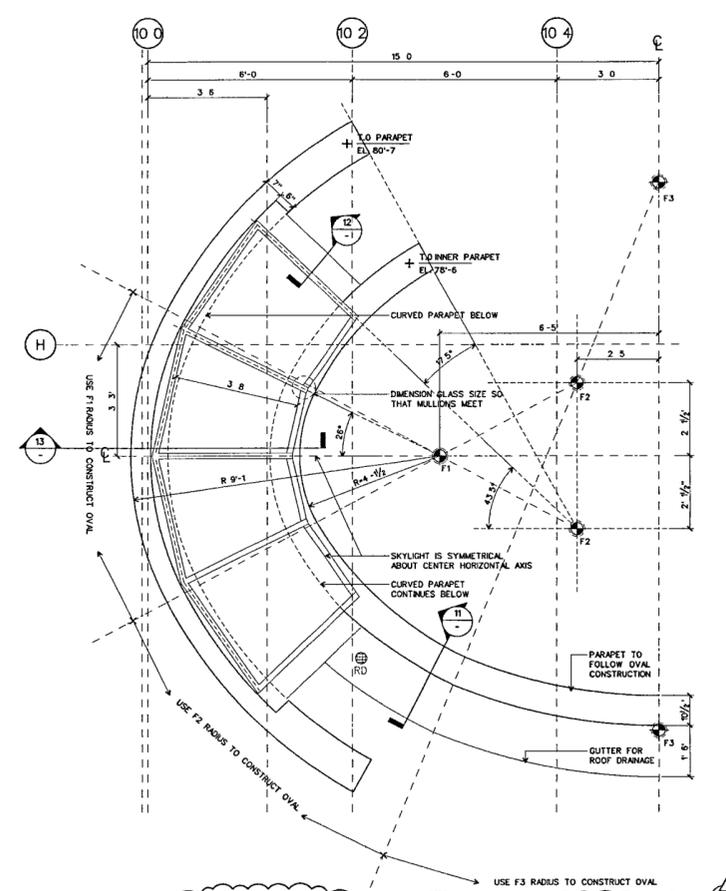

SKYLIGHT PLAN
SCALE 1-1/2" = 1'-0"

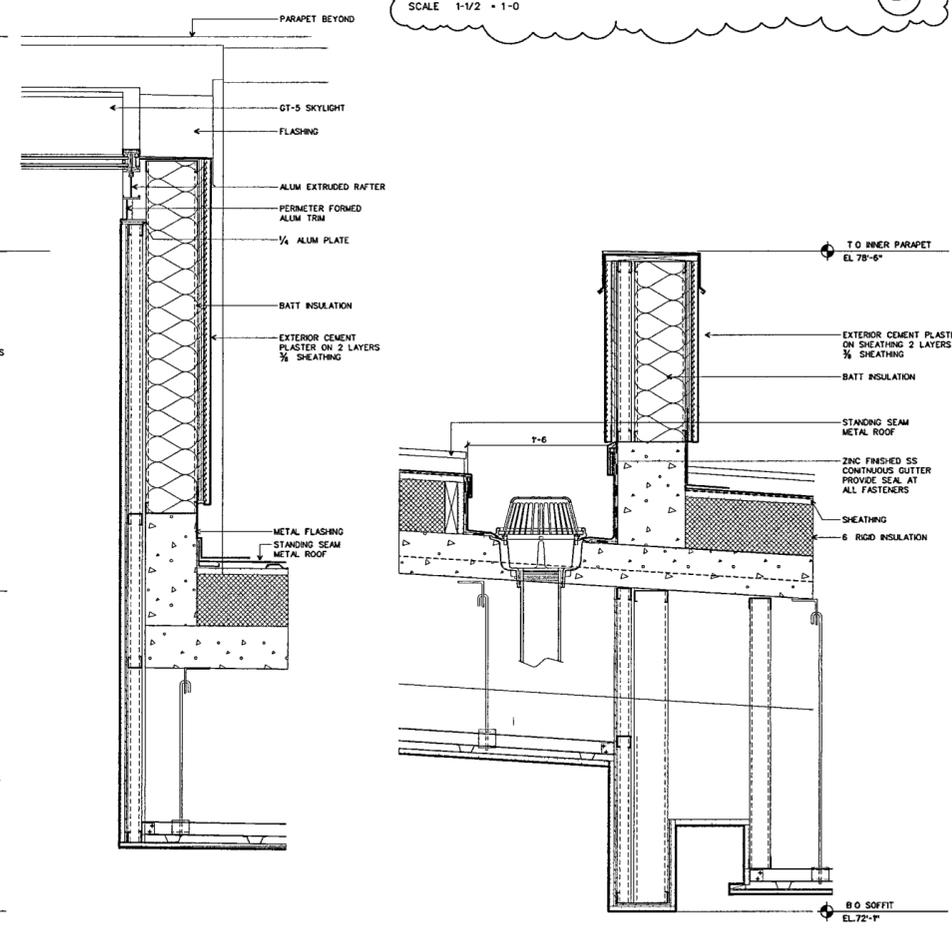

EXEC SKYLIGHT: DETAIL SECTION OF GABLE
SCALE 1-1/2" = 1'-0"

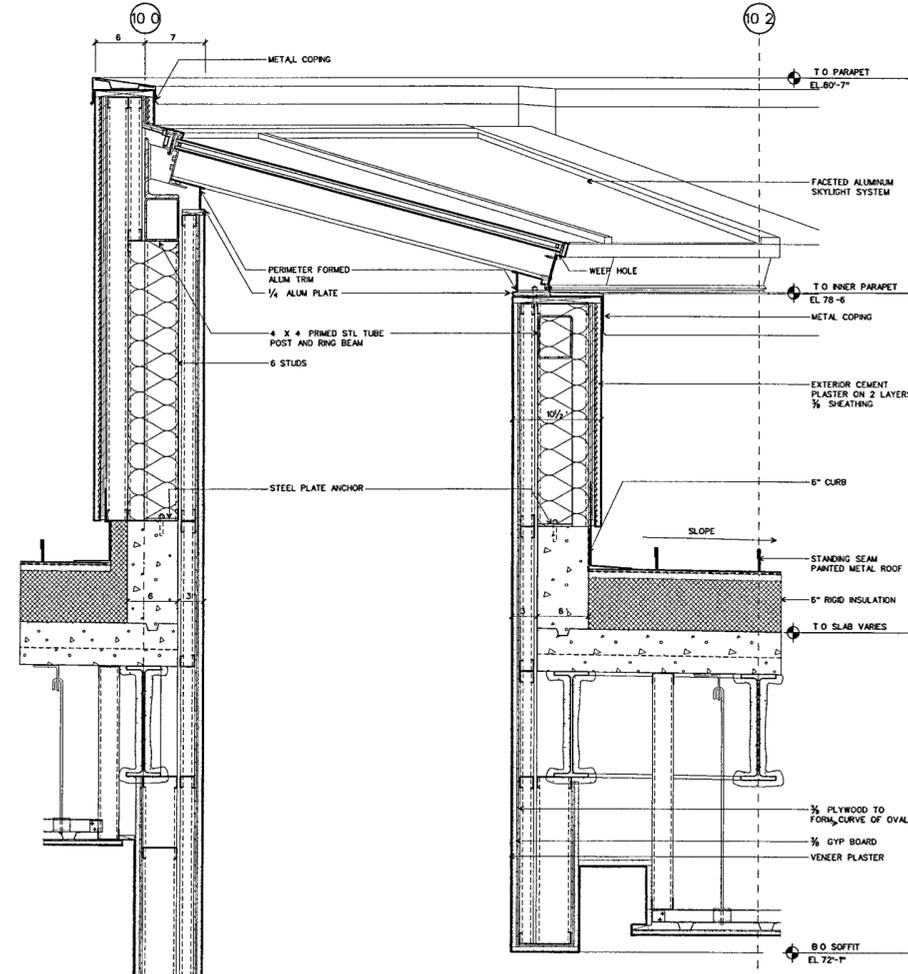

EXEC SKYLIGHT: SECTION DETAIL
SCALE 1-1/2" = 1'-0"

EXEC ROOF: DETAIL SECTION THROUGH WEST PARAPET
SCALE 1-1/2" = 1'-0"