

LITTLE ROCK, ARKANSAS

Architect  
POLSHEK PARTNERSHIP LLP  
320 West 13th Street  
New York, New York 10014  
212.807.7171

Coordinating Architects  
POLK STANLEY YEARY ARCHITECTS LTD  
700 South Schiller Street  
Little Rock, Arkansas 72201  
501.378.0878

WITSELL EVANS & RASCO  
124 West Capitol Avenue, Suite 1750  
Little Rock, Arkansas 72201  
501.374.5300

WOODS CARADINE ARCHITECTS  
2200 South Main Street  
Little Rock, Arkansas 72206  
501.374.4000

Landscape Architects  
HARGREAVES ASSOCIATES  
118 Magazine Street  
Cambridge, Massachusetts 02139  
617.661.0070

LANDSCAPE ARCHITECTURE, Inc.  
400 West Capitol Avenue  
Suite 1600 Regions Center  
Little Rock, Arkansas 72201  
501.374.5610

Structural Engineer  
LESLIE E. ROBERTSON ASSOC., RLLP  
30 Broad Street, 47th Floor  
New York, New York 10004  
212.750.9000


MEP Engineers  
FLACK + KURTZ Inc.  
475 Fifth Avenue  
New York, New York 10017  
212.532.9600

CROMWELL ARCHITECTS ENGINEERS  
101 South Spring Street  
Little Rock, Arkansas 72201  
501.372.2900

Elevator Consultants  
IROS ELEVATOR DESIGN SERVICES  
10 Stuyvesant Avenue  
Lyndhurst, New Jersey 07071  
1.201.933.6076

See

100% Construction Documents	09/27/02
90% Progress Printing	08/30/02
CD PROGRESS PRINTING	07/01/02
100% DD SUBMISSION	03/01/02
Issue	Date

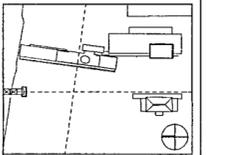

Job No	9908
Scale	1/4" = 1'-0"
Date	September 27, 2002
Title	

**ELEVATOR LAYOUT**

Sheet No  
**A524**

INDICATES WORK TYPICALLY  
NOT INCLUDED IN THE  
ELEVATOR SCOPE OF WORK

**FOR OFFICIAL USE ONLY**


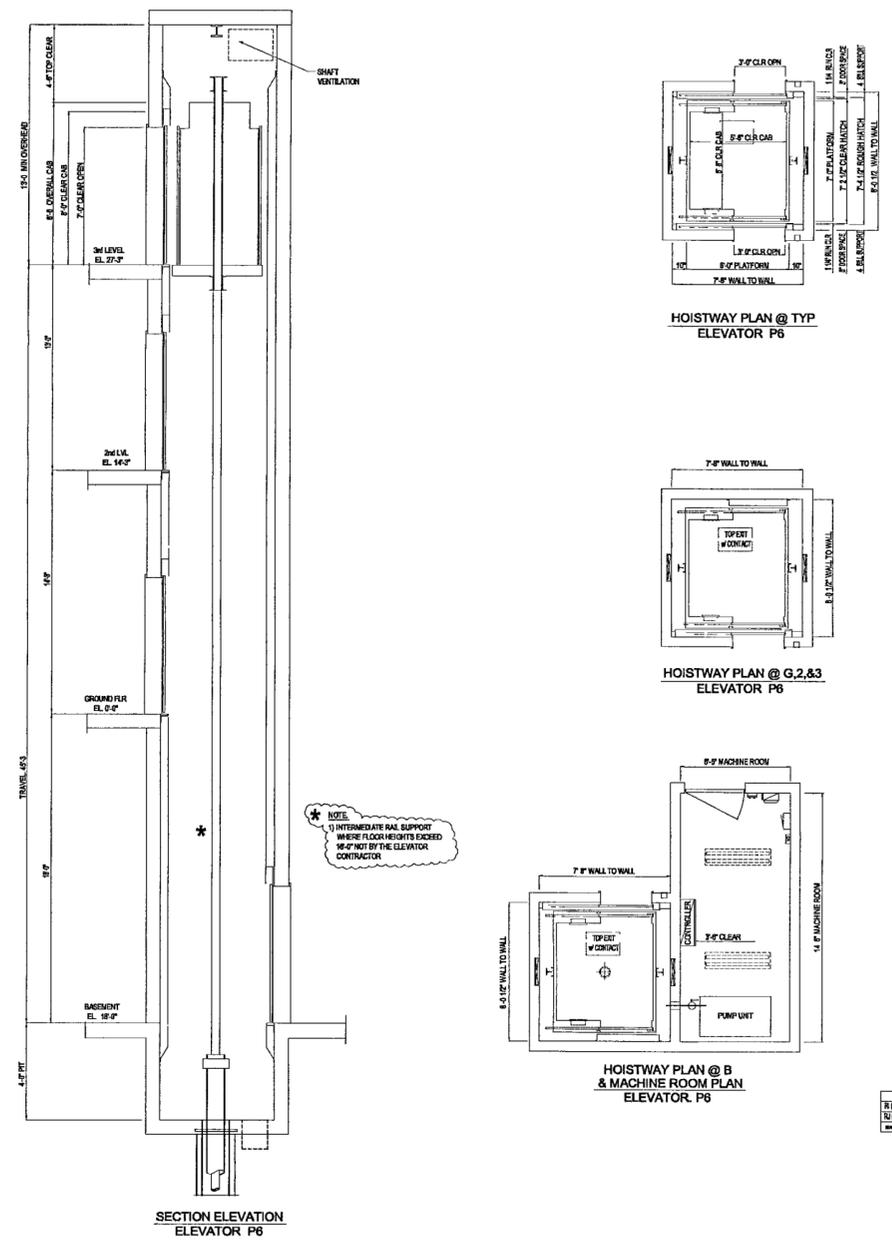


TABLE OF ESTIMATED PIT REACTIONS ELEVATOR P6

REACTION	TYPE	REMARKS
R1	SR	LOADING
R2	SR	LOADING
SEE SHEET No. A522 FOR TYPICAL NOTES

**PASSEGER ELEVATOR P6**  
3,000 LB. CAPACITY @ 150 F.P.M.  
CONVENTIONAL HYDRAULIC ELEVATOR

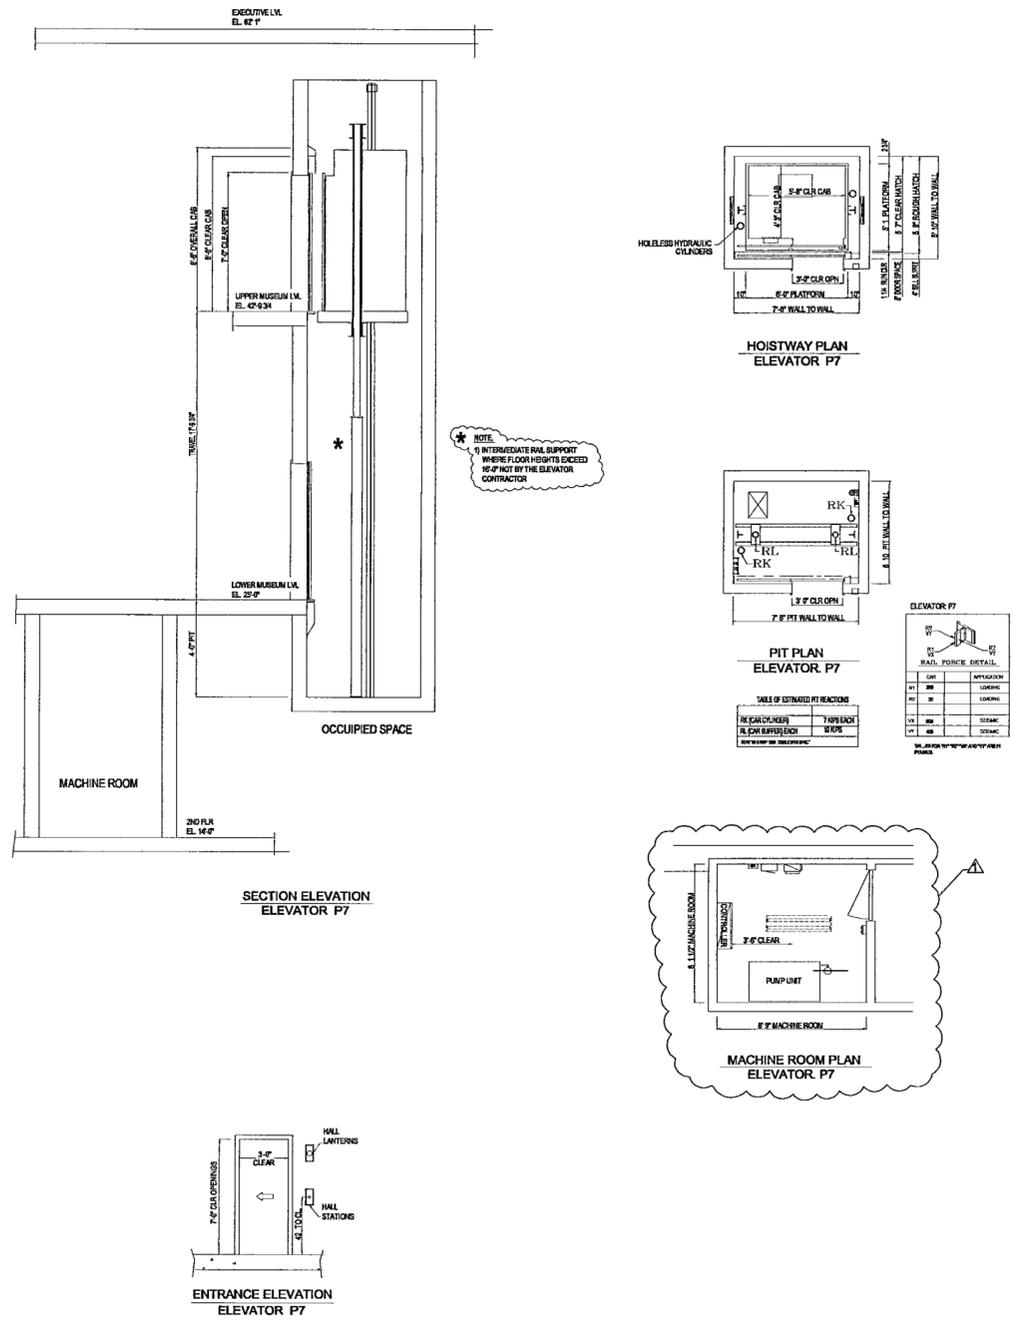

SEE SHEET No. A522 FOR TYPICAL NOTES

**PASSEGER ELEVATOR P7**  
2,000 LB. CAPACITY @ 100 F.P.M.  
HOLELESS HYDRAULIC ELEVATOR