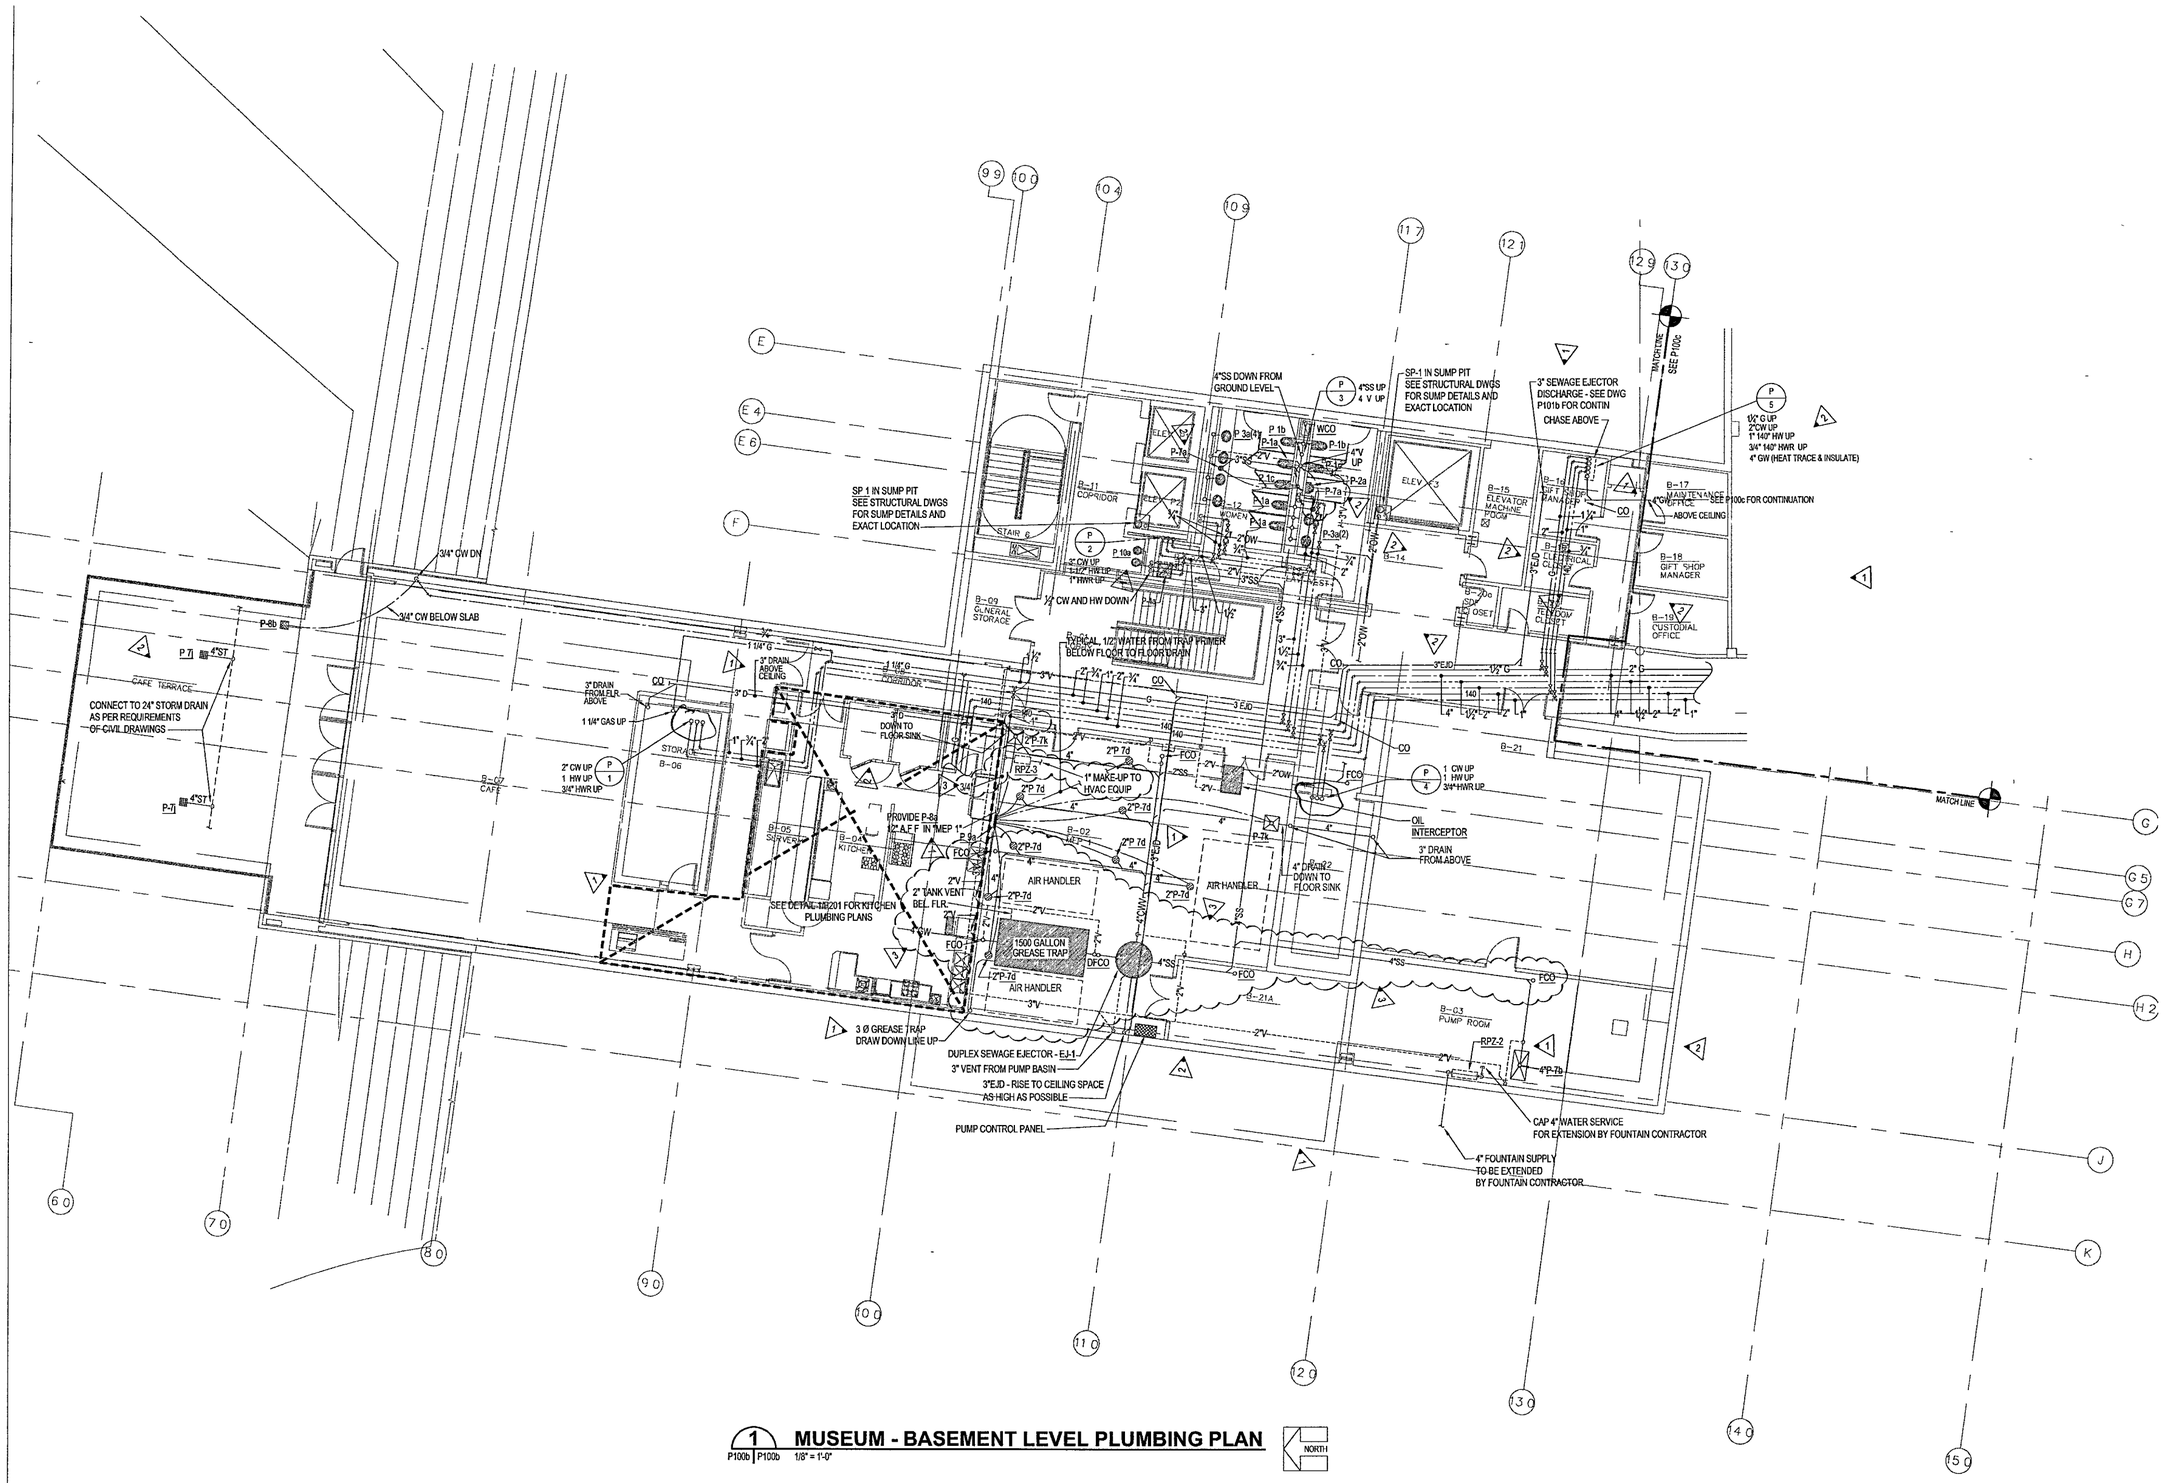

1 MUSEUM - BASEMENT LEVEL PLUMBING PLAN

P100b | P100b 1/8" = 1'-0"

NORTH

WILLIAM J. CLINTON PRESIDENTIAL CENTER

LITTLE ROCK ARKANSAS

Architect

POLSHEK PARTNERSHIP LLP
320 West 13th Street
New York, New York 10014
212.807 7171

Coordinating Architects

POLK STANLEY YEARY ARCHITECTS Ltd
700 South Schiller Street
Little Rock, Arkansas 72201
501 378 0878

WITSELL EVANS RASCO
901 West Third Street
Little Rock, Arkansas 72201
501.374 5300

WOODS CARADINE ARCHITECTS
2200 South Main Street
Little Rock Arkansas 72206
501.374 4060

Landscape Architects

HARGREAVES ASSOCIATES
118 Magazine Street
Cambridge, Massachusettes 02139
617 661 0070

LANDSCAPE ARCHITECTURE Inc.
2300 Cottondale Lane Suite 202
Little Rock, Arkansas 72202
501 374 5610

Structural Engineer

LESLIE E. ROBERTSON ASSOC RLLP
30 Broad Street 47th Floor
New York New York 10004
212.750 9000

MEP Engineers

FLACK + KURTZ Inc
475 Fifth Avenue
New York, New York 10017
212 532.9600

CROMWELL ARCHITECTS ENGINEERS
101 South Spring Street
Little Rock Arkansas 72201
501 372.2000

Curtainwall Consultant

R. A. HEINTGES ARCHITECTS
126 Fifth Avenue 5th Floor
New York, New York 10011
212.652 2966

100% PLUMBING
CONSTRUCTION DRAWINGS
ISSUE - JULY 1, 2002

Seal

STATE OF ARKANSAS
REGISTERED PROFESSIONAL ENGINEER
No 9395
BRIAN T. FERRAZZA

Issue		Date
3	100% Construction Documents	09/27/02
	90% Progress Printing	08/30/02
2	General Revisions ASI #6	26 Aug 02
1	General Revisions ASI #3	9 Aug 02
	Plumbing Contract Documents	07/01/02
	100% Design Development Titled as P100a	03/01/02

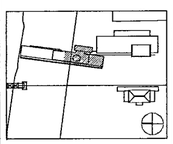

Job No POLSHEK & PARTNERS ARCH. 9908
CROMWELL AE 99-114

Scale 1/8" = 1'-0"

Date JULY 01 2002

Title MUSEUM BASEMENT LEVEL PLUMBING PARTIAL PLAN

Sheet No. P100b

CERTIFICATE OF AUTHORIZATION
CROMWELL ENGINEERS
#5
ARKANSAS ENGINEER

FOR OFFICIAL USE ONLY

1/5/18