

**WILLIAM J CLINTON
PRESIDENTIAL
CENTER**

LITTLE ROCK, ARKANSAS

Architect
POLSHEK PARTNERSHIP LLP
320 West 13th Street
New York, New York 10014
212 807 7171

Coordinating Architects
POLK STANLEY YEARY ARCHITECTS, Ltd
700 South Schiller Street
Little Rock, Arkansas 72201
501 378 0878

WITSELL EVANS RASCO
801 West Third Street
Little Rock, Arkansas 72201
501 374 5300

WOODS CARADINE ARCHITECTS
2200 South Main Street
Little Rock, Arkansas 72206
501 374 4060

Landscape Architects
HARGREAVES ASSOCIATES
118 Magazine Street
Cambridge Massachusetts 02139
617 861 0070

LANDSCAPE ARCHITECTURE, Inc.
2300 Cottondale Lane Suite 202
Little Rock, Arkansas 72202
501 374 5610


Structural Engineer
LESLIE E. ROBERTSON ASSOC. R.L.P.
30 Broad Street 47th Floor
New York, New York 10004
212 750 9000

MEP Engineers
FLACK + KURTZ Inc
475 Fifth Avenue
New York, New York 10017
212 532 9600


CROMWELL ARCHITECTS ENGINEERS
101 South Spring Street
Little Rock, Arkansas 72201
501 372 2900

Curtilwall Consultant
R. A. HEINTGES ARCHITECTS
126 Fifth Avenue, 9th Floor
New York, New York 10011
212 652 2966

**100% PLUMBING
CONSTRUCTION DRAWINGS
ISSUE - JULY 1, 2002**

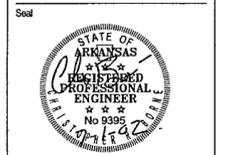

Issue	Date
100% Construction Documents	09/27/02
90% Progress Printing	08/30/02
General Revisions ASI #3	9 Aug 02
Plumbing Contract Documents	07/01/02
100% Design Development	03/01/02

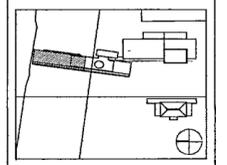



Job No. POLSHEK & PARTNERS ARCH 9908
CROMWELL AE 99-114

Scale 1/8" = 1'-0"

Date JULY 01, 2002

Title **MUSEUM
LOWER LEVEL
PLUMBING
PARTIAL PLAN**

Sheet No. **P103a**

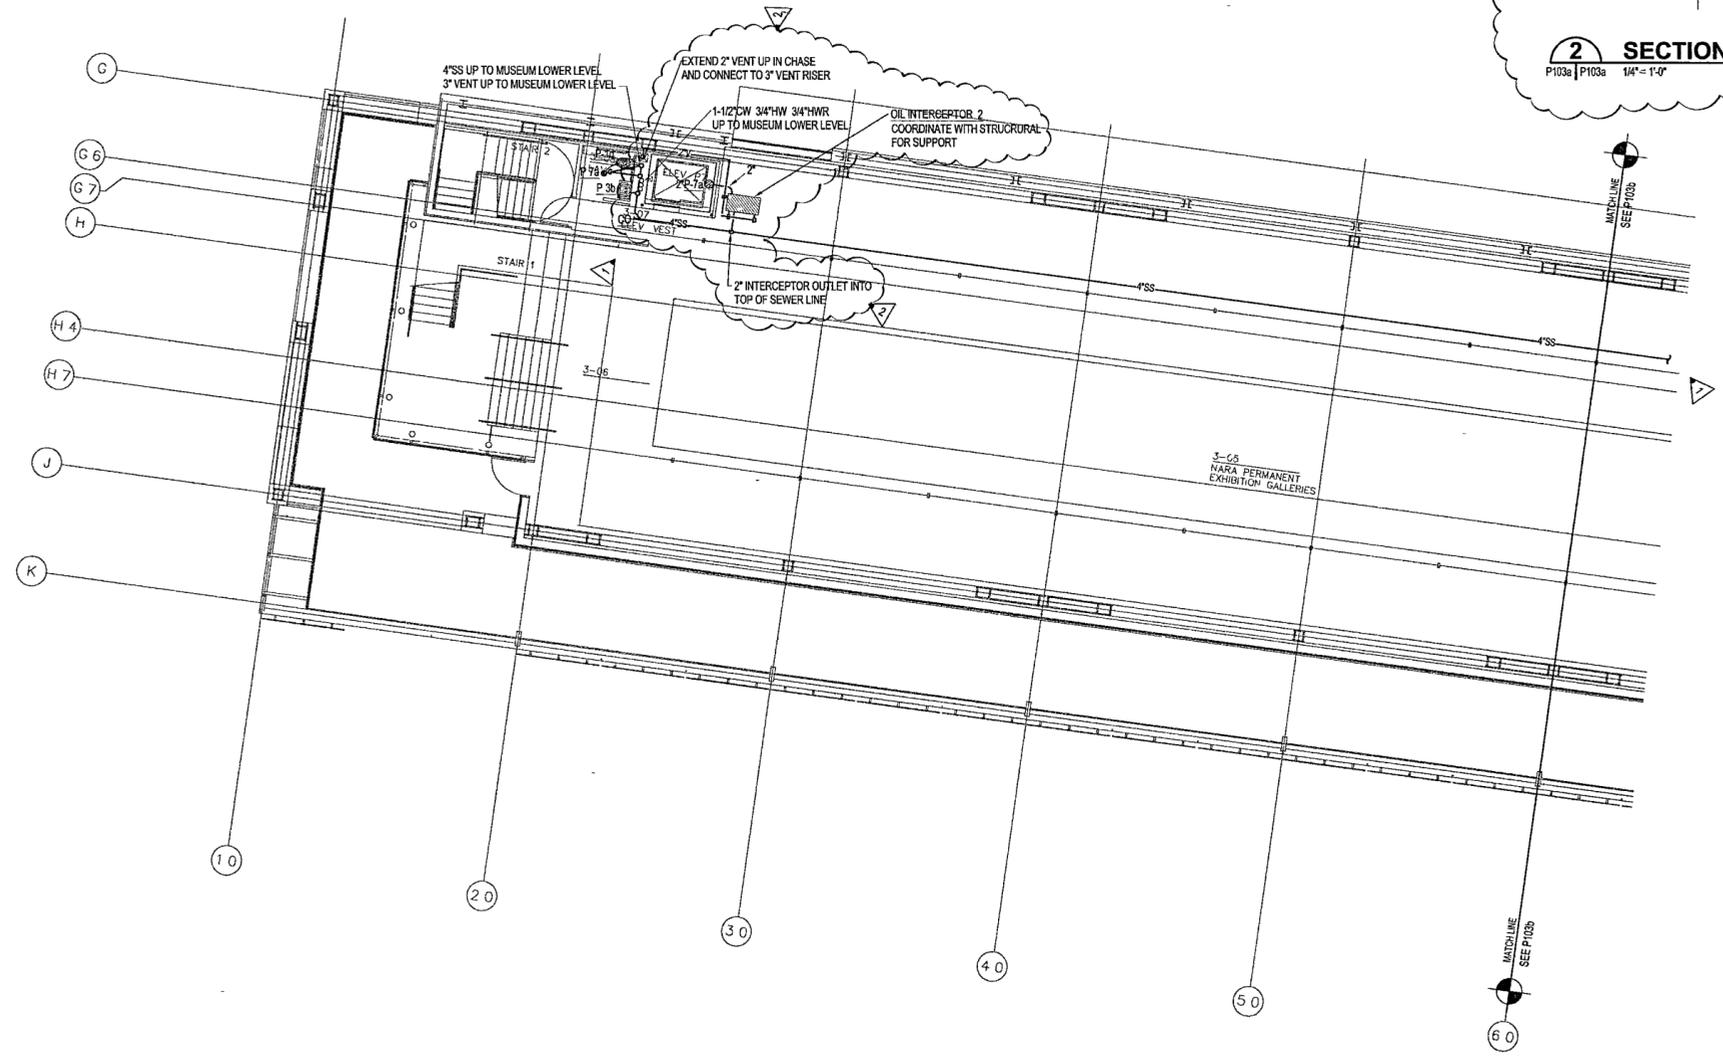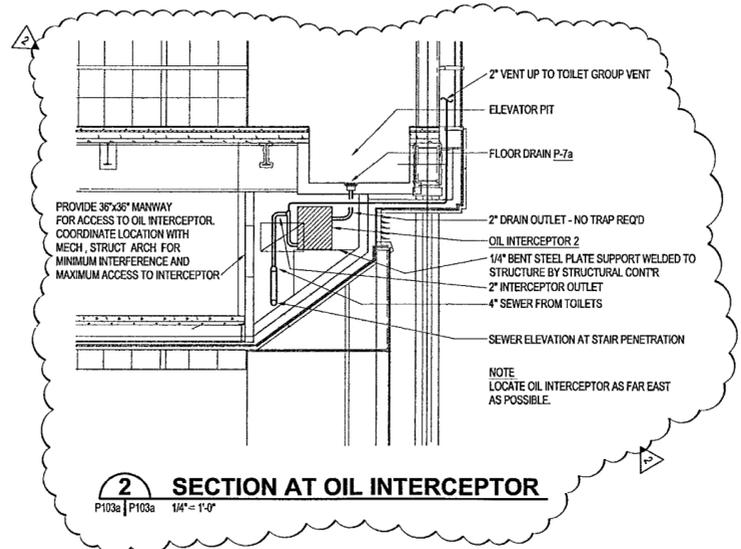

1 MUSEUM - LOWER LEVEL PLUMBING PLAN
P103a | P103a 1/8" = 1'-0"



FOR OFFICIAL USE ONLY