




**1 ELEVATOR SUMP PUMP**  
P3 01 | P3 01 NO SCALE

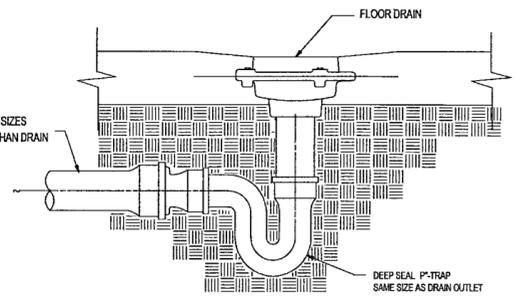


**5 COMBINATION WASTE AND VENT DRAIN**  
P3 01 | P3 01 NO SCALE

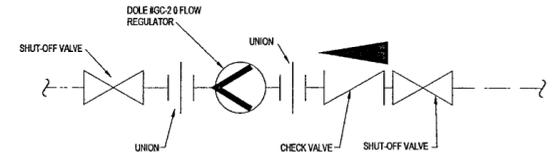


**7 TYPICAL H.W. RECIRC FLOW CONTROL**  
P3 01 | P3 01 NO SCALE

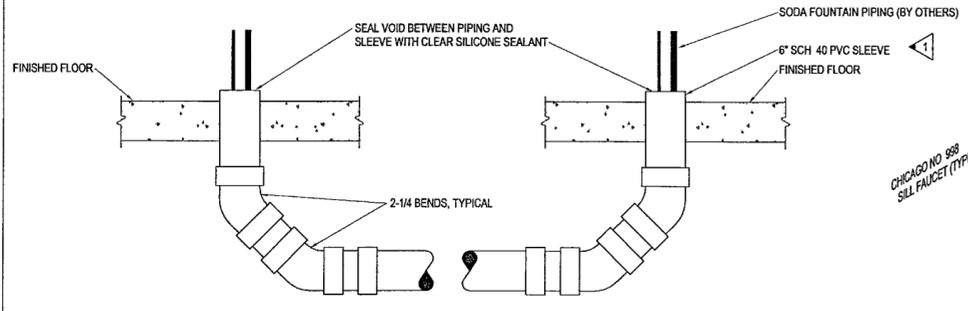


**9 UNDERFLOOR SODA LINE SLEEVE**  
P2 01 | P2 01 NO SCALE

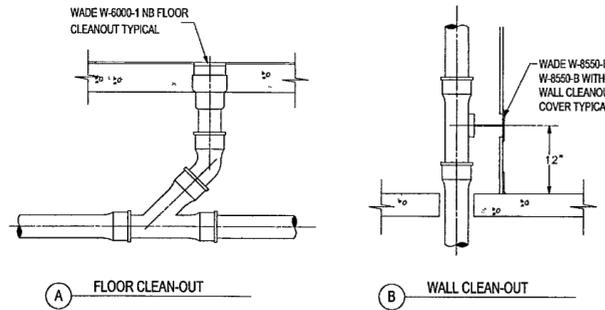


**12 TYPICAL CLEANOUTS**  
P3 01 | P3 01 NO SCALE

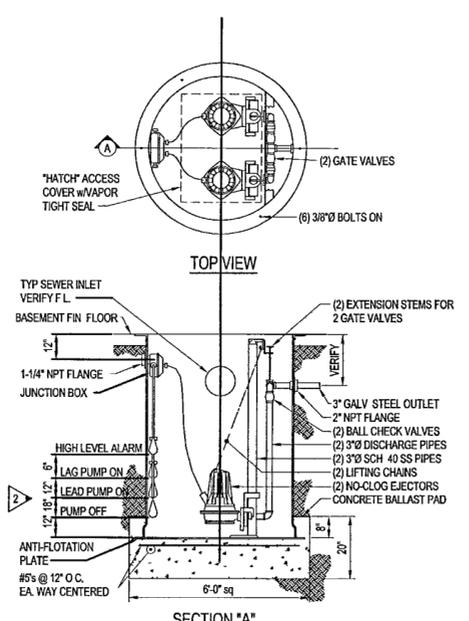


**2 SEWAGE EJECTOR PUMP**  
P3 01 | P3 01 NO SCALE

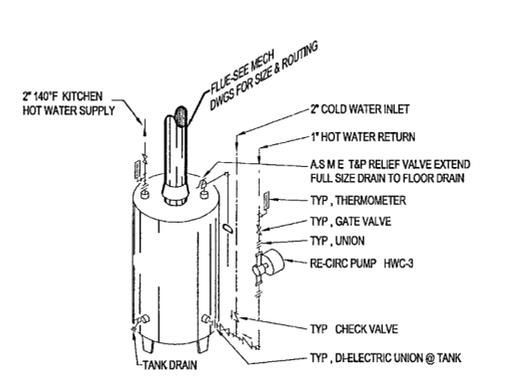


**3 KITCHEN WATER HEATER**  
P3 01 | P3 01 NO SCALE

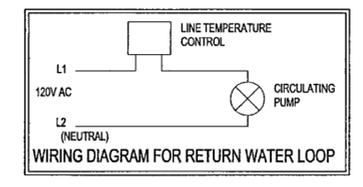


**5 RECIRC. CONTROL SCHEMATIC**  
P3 01 | P3 01 NO SCALE

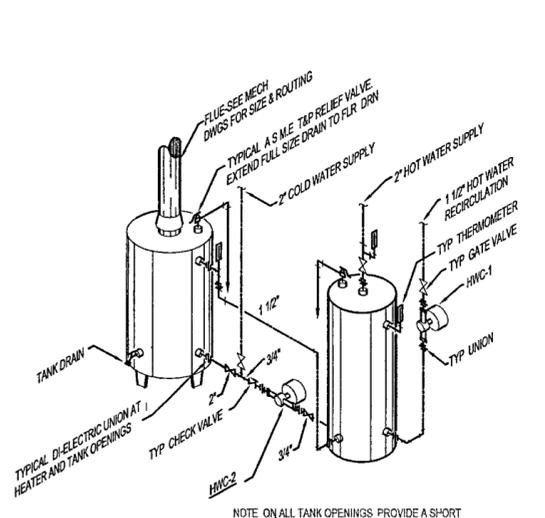


**4 DOMESTIC WATER HEATER**  
P3 01 | P3 01 NO SCALE

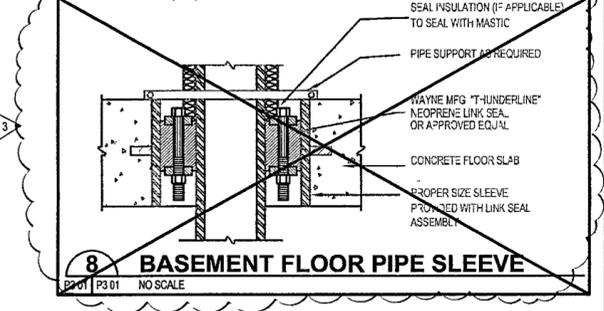


**8 BASEMENT FLOOR PIPE SLEEVE**  
P3 01 | P3 01 NO SCALE

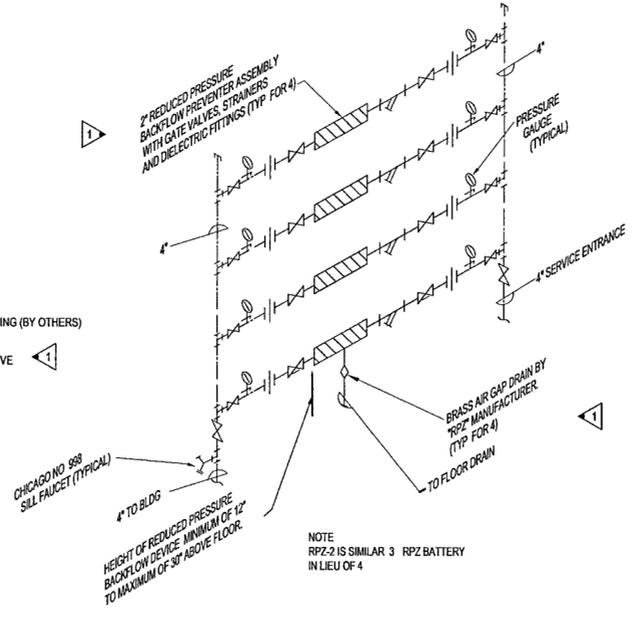


**10 RPZ-1 BACKFLOW PREVENTER**  
P3 01 | P3 01 NO SCALE

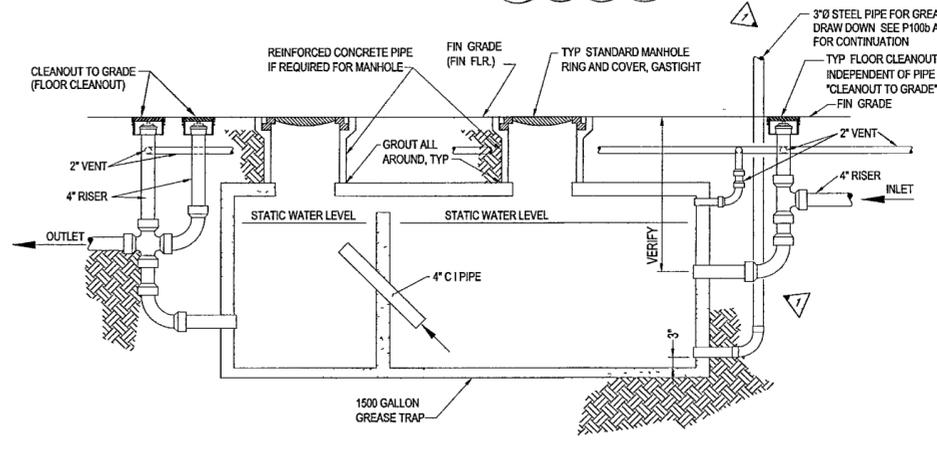


**11 GREASE TRAP - 1500 GALLONS**  
P3 01 | P3 01 NO SCALE

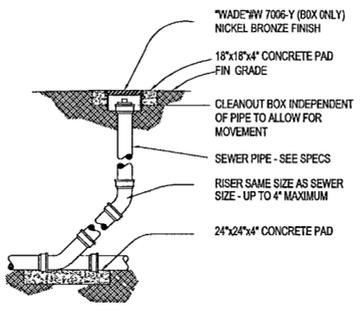

**13 CLEANOUT TO GRADE**  
P3 01 | P3 01 NO SCALE

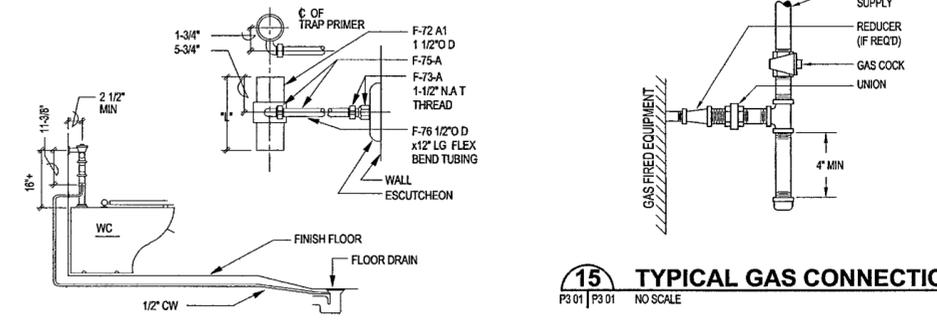

**14 WATER CLOSET TRAP PRIMER**  
P3 01 | P3 01 NO SCALE

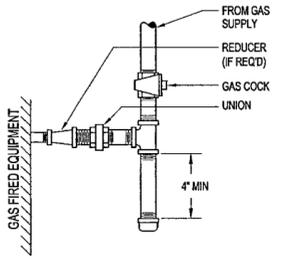

**15 TYPICAL GAS CONNECTION**  
P3 01 | P3 01 NO SCALE

**WILLIAM J CLINTON  
PRESIDENTIAL  
CENTER**

LITTLE ROCK, ARKANSAS

**Architect**  
POLSHEK PARTNERSHIP LLP  
329 West 13th Street  
New York, New York 10014  
212 807 7171

**Coordinating Architects**  
POLSKY STANLEY YEARY ARCHITECTS Ltd  
700 South Gardner Street  
Little Rock, Arkansas 72201  
501 374 0378

**IFITSELL EVANS RASCO**  
681 West Third Street  
Little Rock, Arkansas 72201  
501 374 5300

**WOODS CARADINE ARCHITECTS**  
2201 St. in Main Street  
Little Rock, Arkansas 72206  
501 374 4060

**Landscape Architects**  
HARGREAVES ASSOCIATES  
118 Magazine Street  
Columbia, Missouri 65201  
617 861 0070

**LANDSCAPE ARCHITECTURE Inc**  
2300 Columbia Lane Suite 202  
Little Rock, Arkansas 72202  
501 374 5510

**Structural Engineer**  
LESLIE E. ROBINSON ASSOC. RLLP  
39 Broad Street 4th Floor  
New York, New York 10014  
212 750 9300

**MEP Engineers**  
FLACK + KURTZ Inc  
475 Fifth Avenue  
New York, New York 10017  
212 512 9600


**CROMWELL ARCHITECTS ENGINEERS**  
101 South Spring Street  
Little Rock, Arkansas 72201  
501 372 2800

**Curranwall Consultant**  
R. A. HEINTGES ARCHITECTS  
126 Fifth Avenue 9th Floor  
New York, New York 10011  
212 852-2956

**100% PLUMBING  
CONSTRUCTION DRAWINGS  
ISSUE - JULY 1, 2002**



Issue	Date
100% Construction Documents	09/27/02
90% Progress Printing	08/30/02
General Revisions - ASI #8	25 Aug 02
General Revisions - ASI #3	9 Aug 02
Plumbing Contract Documents	07/01/02

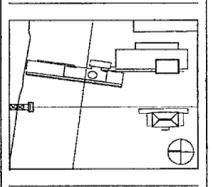

Job No: POLSHEK & PARTNERS ARCH 8908  
CROMWELL AE 99-114

Scale: \_\_\_\_\_  
Date: \_\_\_\_\_

Title: \_\_\_\_\_

**PLUMBING  
DETAILS**

Sheet No: \_\_\_\_\_

**P401**



FOR OFFICIAL USE ONLY