

**WILLIAM J CLINTON
PRESIDENTIAL
CENTER**

LITTLE ROCK, ARKANSAS

Architect
POLSHAK PARTNERSHIP LLP
320 West 13th Street
New York, New York 10014
212.607.7171

Coordinating Architects
POLK STANLEY YEARY ARCHITECTS Ltd
700 South Schafer Street
Little Rock, Arkansas 72201
501.378.0878

WITSELL EVANS RASCO
901 West Third Street
Little Rock, Arkansas 72201
501.374.5300

WOODS CARADINE ARCHITECTS
2200 South Main Street
Little Rock, Arkansas 72206
501.374.4060

Landscape Architects
HARGREAVES ASSOCIATES
118 Magazine Street
Cambridge, Massachusetts 02139
617.681.0070

LANDSCAPE ARCHITECTURE Inc.
2300 Cottondale Lane Suite 202
Little Rock, Arkansas 72202
501.374.5810

Structural Engineer
LESLIE E. ROBERTSON ASSOC. RLLP
30 Broad Street, 47th Floor
New York, New York 10004
212.750.9000


MEP Engineers
FLACK + KURTZ Inc.
475 Fifth Avenue
New York, New York 10017
212.532.9600

CROMWELL ARCHITECTS ENGINEERS
161 South Spring Street
Little Rock, Arkansas 72201
501.372.2900

Curtainwall Consultant
R. A. HENTGES ARCHITECTS
128 Fifth Avenue, 9th Floor
New York, New York 10011
212.652.2968

Seal

Issue	Date
10 100% CONSTRUCTION DOCS	09/27/02
9 SFS-14	09/12/02
8 90% PROGRESS PRINTING	08/30/02
7 SFS-4 (RFI # 103)	07/30/02
6 100% STRUCTURAL CD	07/01/02
5 100% STL & CONC CD	05/15/02
4 BUILDING DEPT	03/18/02
3 BID ISSUE	03/01/02
2 75% DESIGN DEVEL.	01/25/02
1 50% DESIGN DEVEL.	12/19/01

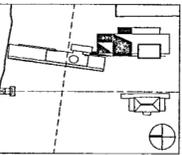

Job No 9908
Scale 1/8"=1'-0"
Date DEC 11, 2001
Title


**FOUNDATION AND
BASEMENT LEVEL
PLAN**

Sheet No
S100c

NOTES:

- REFER TO THE STRUCTURAL DRAWING BOOK FOR GENERAL NOTES TYPICAL DETAILS, SCHEDULES AND ALL REFERENCED DETAILS AND SECTIONS REFER TO S220 SERIES DRAWINGS FOR WALL ELEVATIONS AND REINFORCEMENT REFER TO SLAB EDGE DRAWINGS FOR SLAB EDGE LOCATIONS AND DIMENSIONS
- TOP OF CONCRETE IS AT REFERENCE ELEVATION -18'-0" (EL 258'), UNLESS OTHERWISE NOTED [XXX], WHERE XXX IS MEASURED WITH RESPECT TO REFERENCE ELEVATION
- TOP OF FOOTING IS AT ELEVATION -20'-0" (EL 256'), UNLESS OTHERWISE NOTED AS [XXX] WHERE XXX IS MEASURED WITH RESPECT TO EL 0'
- FLOOR CONSTRUCTION IS 8" REINFORCED CONCRETE SLAB ON GROUND
- UNLESS OTHERWISE NOTED, CENTER OF SPREAD FOOTING COINCIDES WITH THE CENTER OF COLUMN ABOVE

- CONCRETE STRENGTH AND WEIGHT
FOOTINGS F'C = 3000 PSL, NW
SLABS ON GROUND F'C = 4000 PSL, NW
WALLS & COLUMNS F'C = 4000 PSL, NW
- Ψ INDICATES INFORMATION TO BE PROVIDED BY OTHERS

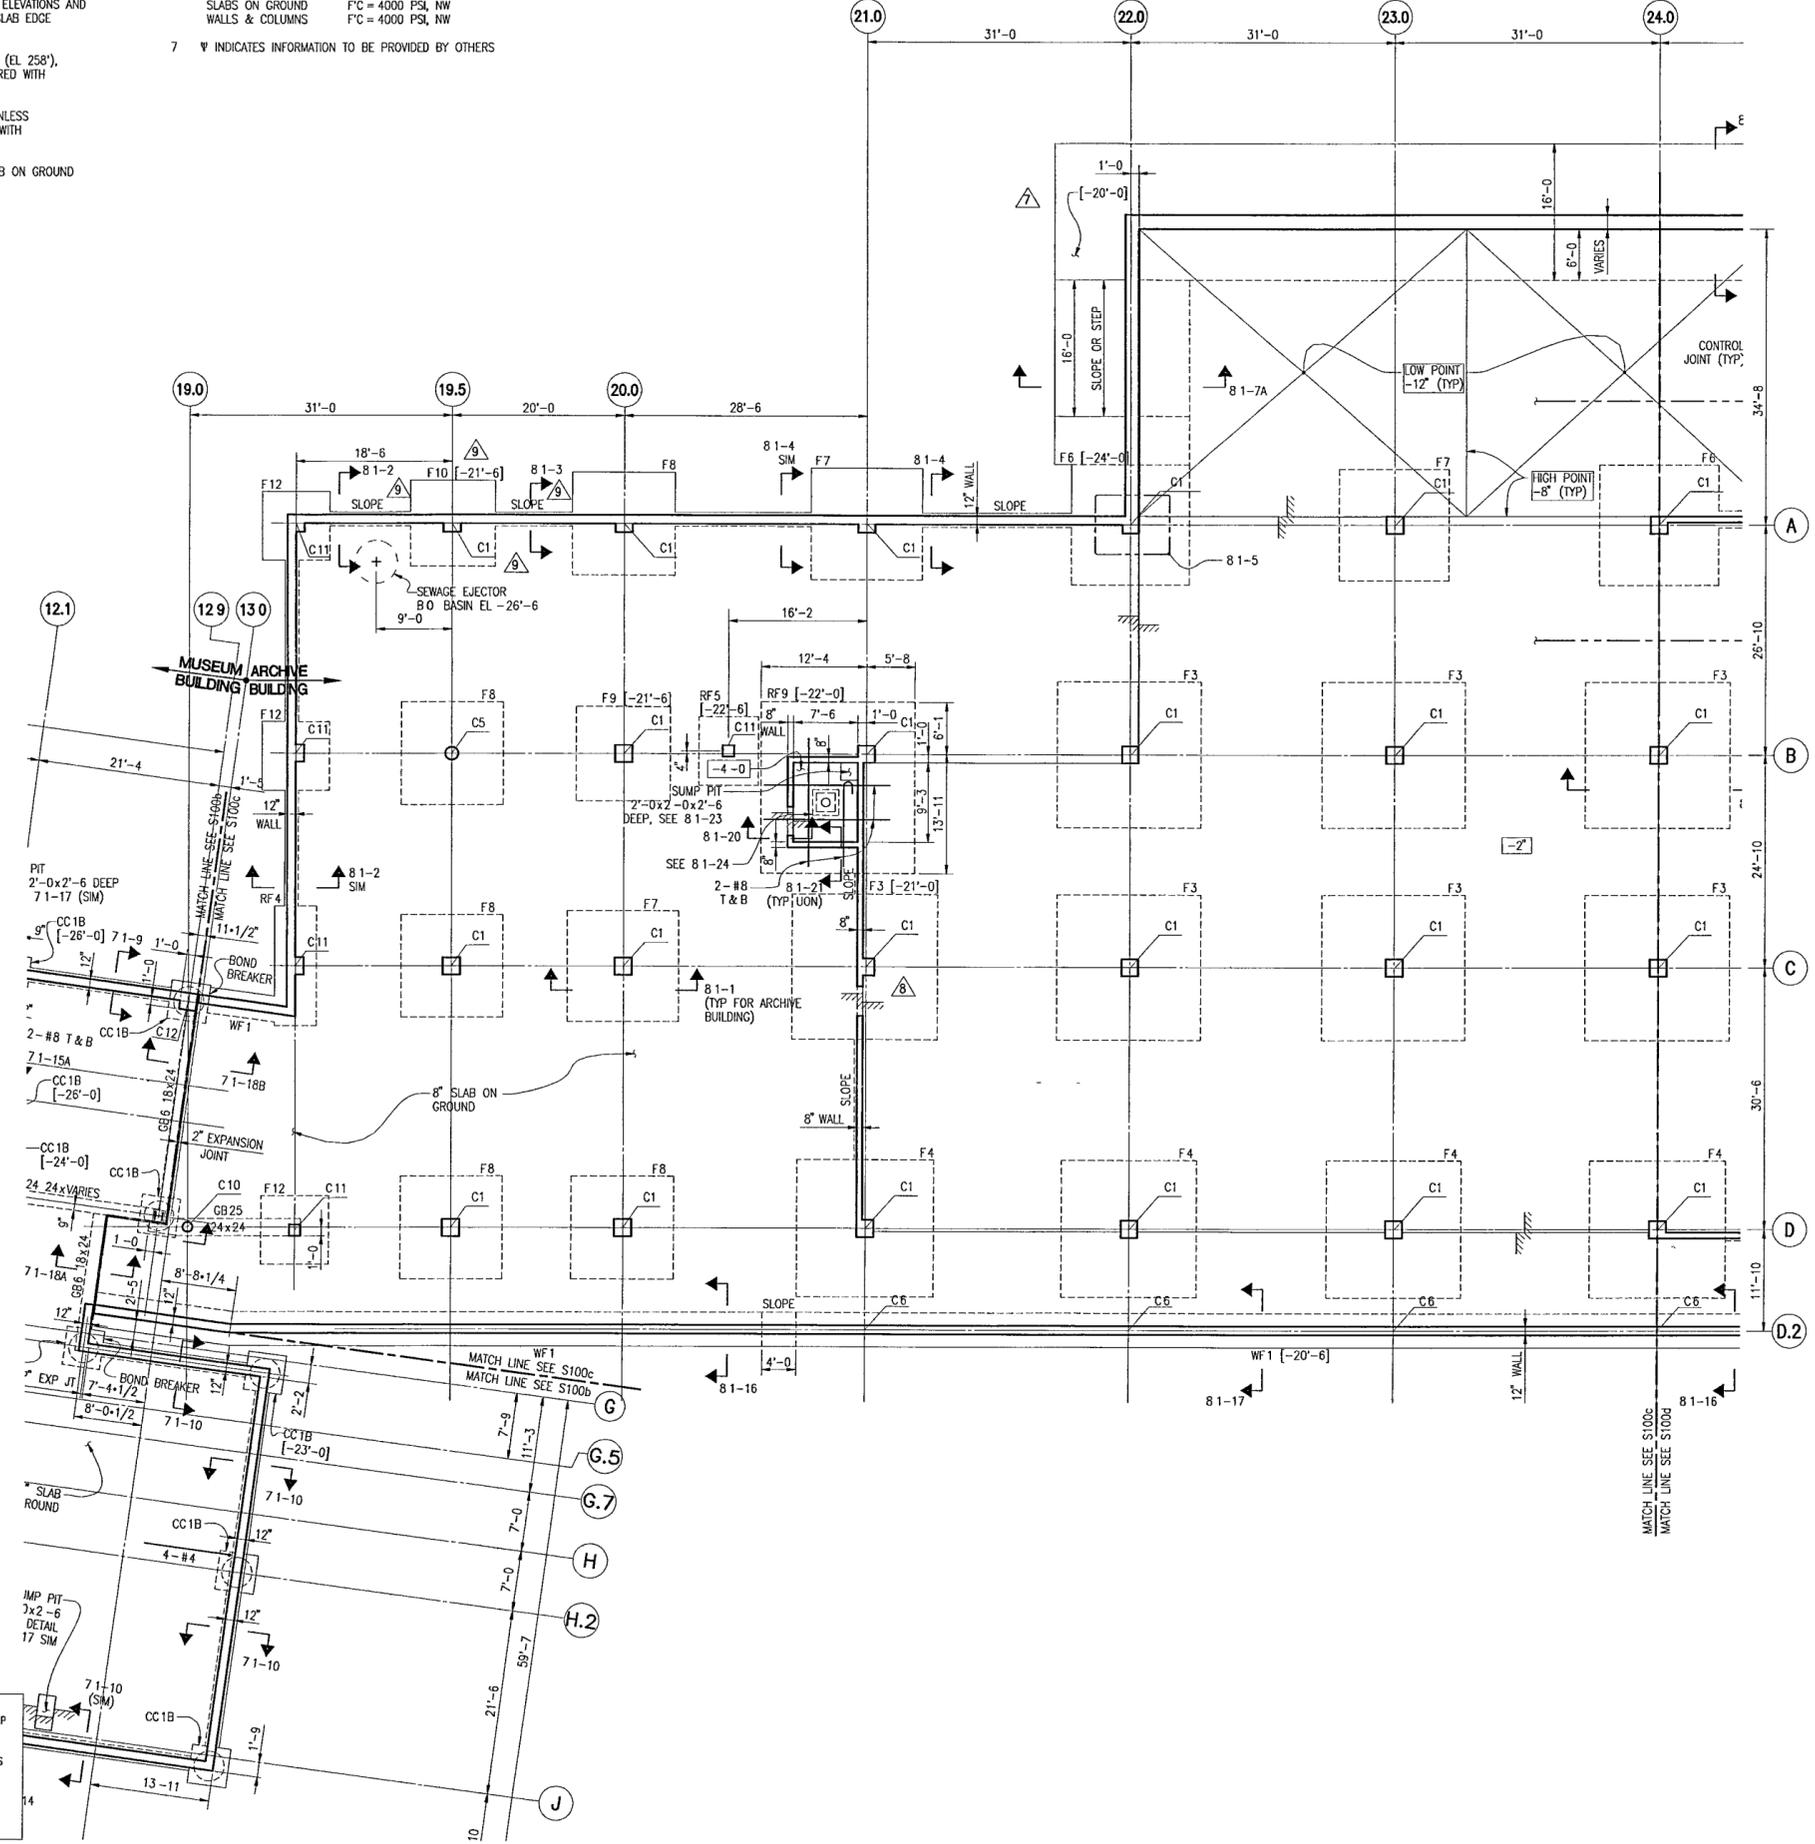

© Copyright LESLIE E. ROBERTSON ASSOCIATES, R.L.L.P.
WARNING IT IS A VIOLATION OF LAW FOR ANY PERSON, UNLESS ACTING UNDER THE DIRECTION OF A PROFESSIONAL LICENSED IN THE STATE OF THIS PROJECT TO ALTER IN ANY WAY THESE DRAWINGS WHERE ANY ITEM IS ALTERED THE SUPERVISING PROFESSIONAL SHALL AFFIX TO THE ITEM HIS SEAL AND THE INSCRIPTION ALTERED BY FOLLOWED BY HIS SIGNATURE, THE DATE, AND A SPECIFIC DESCRIPTION OF THE ALTERATION