

**WILLIAM J CLINTON
PRESIDENTIAL
CENTER**

LITTLE ROCK, ARKANSAS

Architect
POLSHEK PARTNERSHIP LLP
320 West 13th Street
New York, New York 10014
212.607.7171

Coordinating Architects
POLK STANLEY YEARY ARCHITECTS LM
700 South Schiller Street
Little Rock, Arkansas 72201
501.378.0878

WITSELL EVANS RASCO
501 West Third Street
Little Rock, Arkansas 72201
501.374.6300

WOODS CARADINE ARCHITECTS
2200 South Main Street
Little Rock, Arkansas 72206
501.374.4060

Landscape Architects
HARGREAVES ASSOCIATES
118 Magazine Street
Cambridge, Massachusetts 02139
617.661.0070

LANDSCAPE ARCHITECTURE, Inc.
2300 Cottondale Lane Suite 202
Little Rock, Arkansas 72202
501.374.5610

Structural Engineer
LESLIE E. ROBERTSON ASSOC., RLLP
30 Broad Street, 47th Floor
New York, New York 10004
212.750.9000


MEP Engineers
FLACK + KURTZ Inc.
475 Fifth Avenue
New York, New York 10017
212.532.5600

CROMWELL ARCHITECTS ENGINEERS
101 South Spring Street
Little Rock, Arkansas 72201
501.372.2900

Curtilwall Consultant
R. A. HEINTGES ARCHITECTS
135 5th Avenue, 9th Floor
New York, New York 10011
212.652.2968

Seal



Issue	Date
9 100% CONSTRUCTION DOCS	09/27/02
8 SFS-14	09/12/02
7 90% PROGRESS PRINTING	08/30/02
6 100% STRUCTURAL CD	07/01/02
5 100% STA & CONC CD	05/15/02
4 BUILDING DEPT	03/18/02
3 BID ISSUE	03/01/02
2 75% DESIGN DEVEL.	01/25/02
1 50% DESIGN DEVEL.	12/19/01

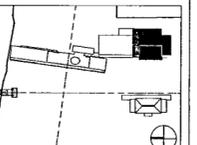

Job No 9908
Scale 1/8"=1'-0"
Date DEC 11, 2001
Title

**FOUNDATION AND
BASEMENT LEVEL
PLAN**

Sheet No **S100d**

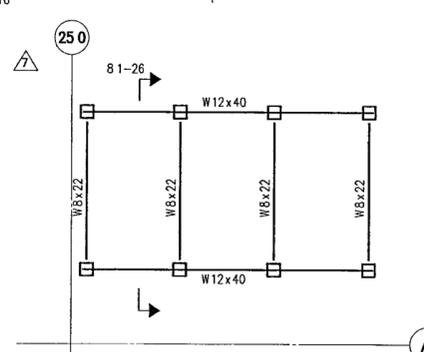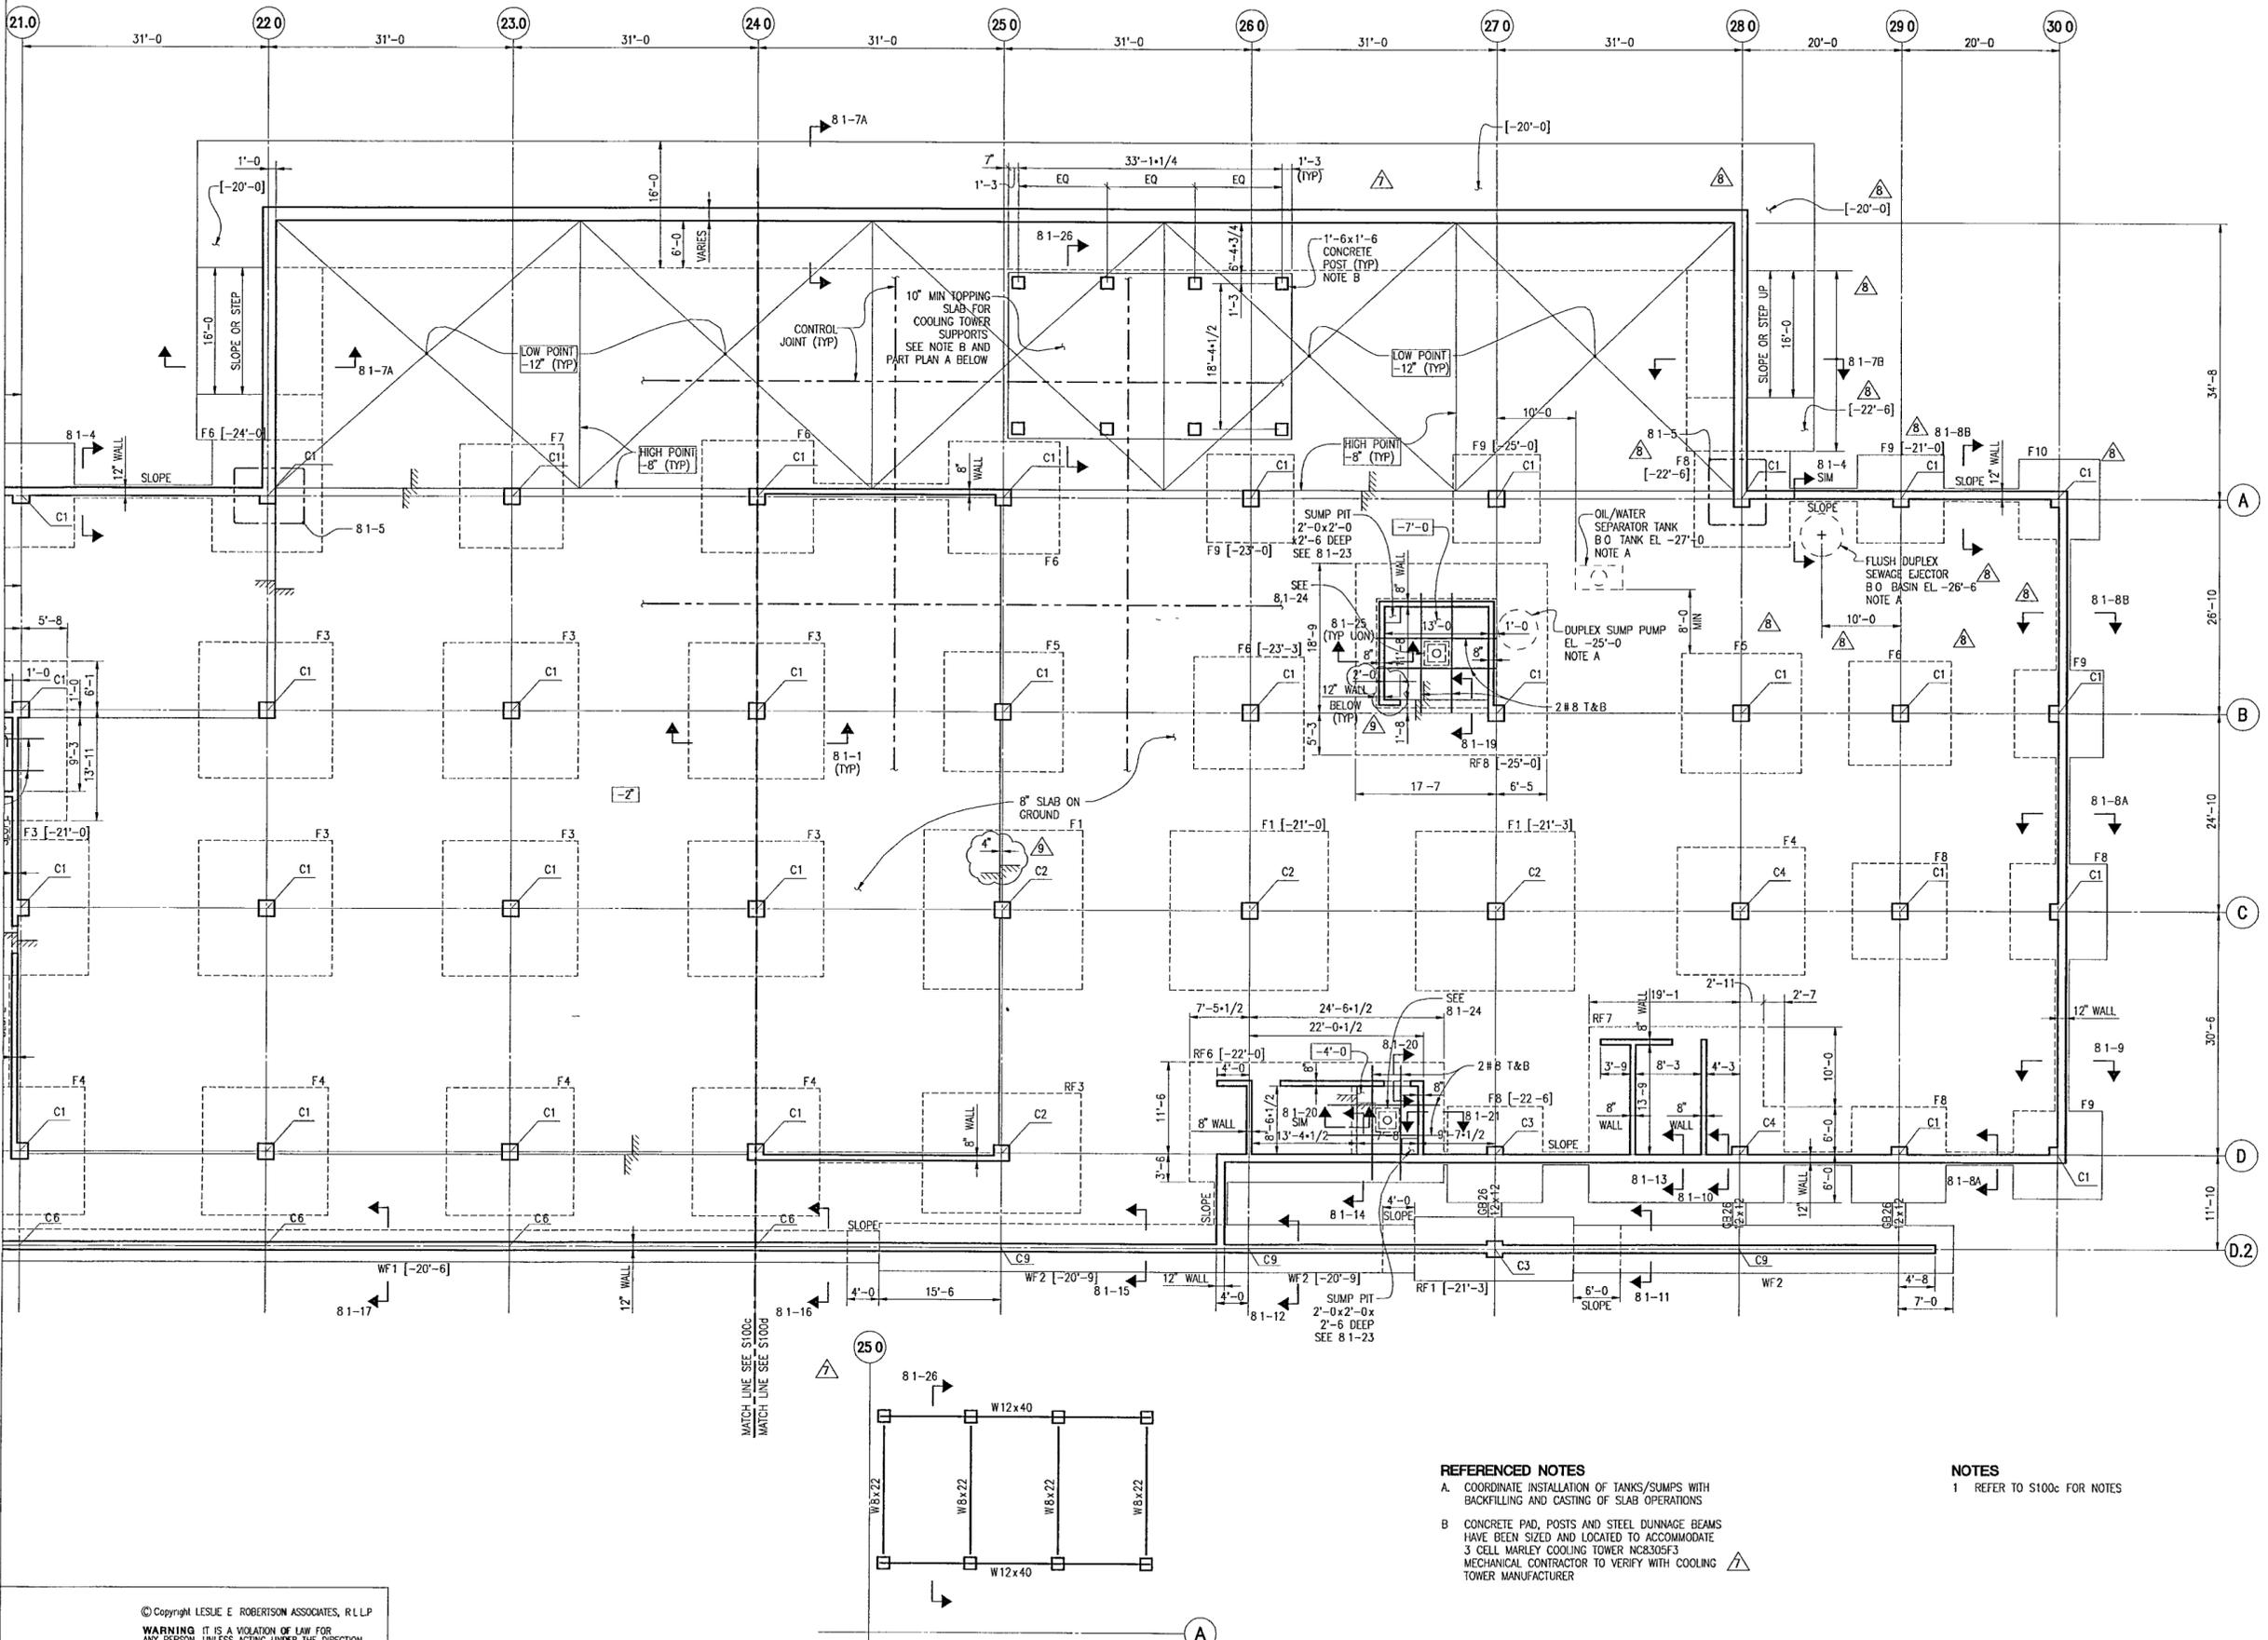

- REFERENCED NOTES**
- A. COORDINATE INSTALLATION OF TANKS/SUMPS WITH BACKFILLING AND CASTING OF SLAB OPERATIONS
 - B. CONCRETE PAD, POSTS AND STEEL DUNNAGE BEAMS HAVE BEEN SIZED AND LOCATED TO ACCOMMODATE 3 CELL MARLEY COOLING TOWER NC8305F3 MECHANICAL CONTRACTOR TO VERIFY WITH COOLING TOWER MANUFACTURER

- NOTES**
- 1 REFER TO S100c FOR NOTES

© Copyright LESLIE E. ROBERTSON ASSOCIATES, R.L.L.P.
WARNING IT IS A VIOLATION OF LAW FOR ANY PERSON UNLESS ACTING UNDER THE DIRECTION OF A PROFESSIONAL LICENSED IN THE STATE OF THIS PROJECT, TO ALTER IN ANY WAY THESE DRAWINGS WHERE ANY ITEM IS ALTERED THE SUPERVISING PROFESSIONAL SHALL AFFIX TO THE ITEM HIS SEAL AND THE INSCRIPTION ALTERED BY FOLLOWED BY HIS SIGNATURE THE DATE AND A SPECIFIC DESCRIPTION OF THE ALTERATION

A PART PLAN - STEEL DUNNAGE BEAMS
FOR COOLING TOWER SUPPORTS (SEE NOTE B)

FOR OFFICIAL USE ONLY