

**WILLIAM J CLINTON
PRESIDENTIAL
CENTER**

LITTLE ROCK, ARKANSAS

Architect
POLSHEK PARTNERSHIP LLP
520 West 13th Street
New York, New York 10014
212.807.7171

Coordinating Architects
POLK & STANLEY YEARY ARCHITECTS LM
700 South Scudder Street
Little Rock, Arkansas 72201
501.378.0878

WITSELL EVANS RASCO
501 West Third Street
Little Rock, Arkansas 72201
501.374.5300

WOODS CARADINE ARCHITECTS
2200 South Main Street
Little Rock, Arkansas 72208
501.374.4060

Landscape Architects
HARGREAVES ASSOCIATES
118 Magazine Street
Cambridge, Massachusetts 02139
617.661.0070

LANDSCAPE ARCHITECTURE, Inc
2300 Cottondale Lane Suite 202
Little Rock, Arkansas 72202
501.374.5610

Structural Engineer
LESLIE E. ROBERTSON ASSOC., RLLP
30 Broad Street, 4th Floor
New York, New York 10004
212.759.5000


MEP Engineers
FLACK + KURTZ, Inc
475 Fifth Avenue
New York, New York 10017
212.532.9600

CROWMELL ARCHITECTS ENGINEERS
101 South Spring Street
Little Rock, Arkansas 72201
501.372.2900

Curtilage Consultant
R. A. HEINTGES ARCHITECTS
126 Fifth Avenue, 9th Floor
New York, New York 10011
212.652.2968

Seal

10	100% CONSTRUCTION DOCS	09/27/02
9	90% PROGRESS PRINTING	08/30/02
8	AS1 05	06/20/02
7	SFS-1 (RFI #5)	07/08/02
6	100% STRUCTURAL CD	07/01/02
5	100% STL & CONC CD	05/15/02
4	BUILDING DEPT	03/18/02
3	BID ISSUE	03/01/02
2	75% DESIGN DEVEL	01/25/02
1	50% DESIGN DEVEL	12/19/01
Issue		Date

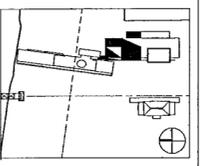


Job No. 9908
Scale 1/8"=1'-0"
Date DEC 11, 2001
Title

**GROUND LEVEL
PLAN**

Sheet No. **S101c**

NOTES

- REFER TO THE STRUCTURAL DRAWING BOOK FOR GENERAL NOTES, TYPICAL DETAILS, SCHEDULES AND ALL REFERENCED DETAILS AND SECTIONS REFER TO S220 SERIES DRAWINGS FOR WALL ELEVATIONS AND REINFORCEMENT REFER TO EDGE OF SLAB DRAWINGS FOR CURBS, SLAB EDGE LOCATIONS AND DIMENSIONS
- TOP OF CONCRETE IS AT REFERENCE ELEVATION +0'-0. (EL 276') UNLESS OTHERWISE NOTED [XXX], WHERE XXX IS MEASURED WITH RESPECT TO REFERENCE ELEVATION
- FLOOR CONSTRUCTION IS WAFFLE SLAB WITH 30"x30"x20" DOMES, 7" JOISTS @ 37" O.C. AND 4-1/2" NORMAL WEIGHT CONCRETE TOP SLAB, UNLESS OTHERWISE NOTED
- TOP OF STRUCTURAL STEEL IS (-0') BELOW REFERENCE ELEVATION UNLESS OTHERWISE NOTED
- CONCRETE STRENGTH AND WEIGHT
SLABS F'C = 4000 PSI, NW
WALLS & COLUMNS F'C = 4000 PSI, NW
- CONCRETE BEAMS ARE DESIGNATED BxD WHERE B IS THE WIDTH IN INCHES AND D IS THE DEPTH (INCLUDING THE SLAB) IN INCHES
- PLACE REINFORCING BARS FOR WAFFLE SLAB IN THE FOLLOWING SEQUENCE UPON
NORTH-SOUTH BOTTOM BARS
EAST-WEST BOTTOM BARS
EAST-WEST TOP BARS
NORTH-SOUTH TOP BARS
- MT=MINIMUM TUBE, TS6x4x5/16 FY 46
MB=MINIMUM BEAM, W12x22 FY 50
- ▽ INDICATES INFORMATION TO BE PROVIDED BY ARCHITECT

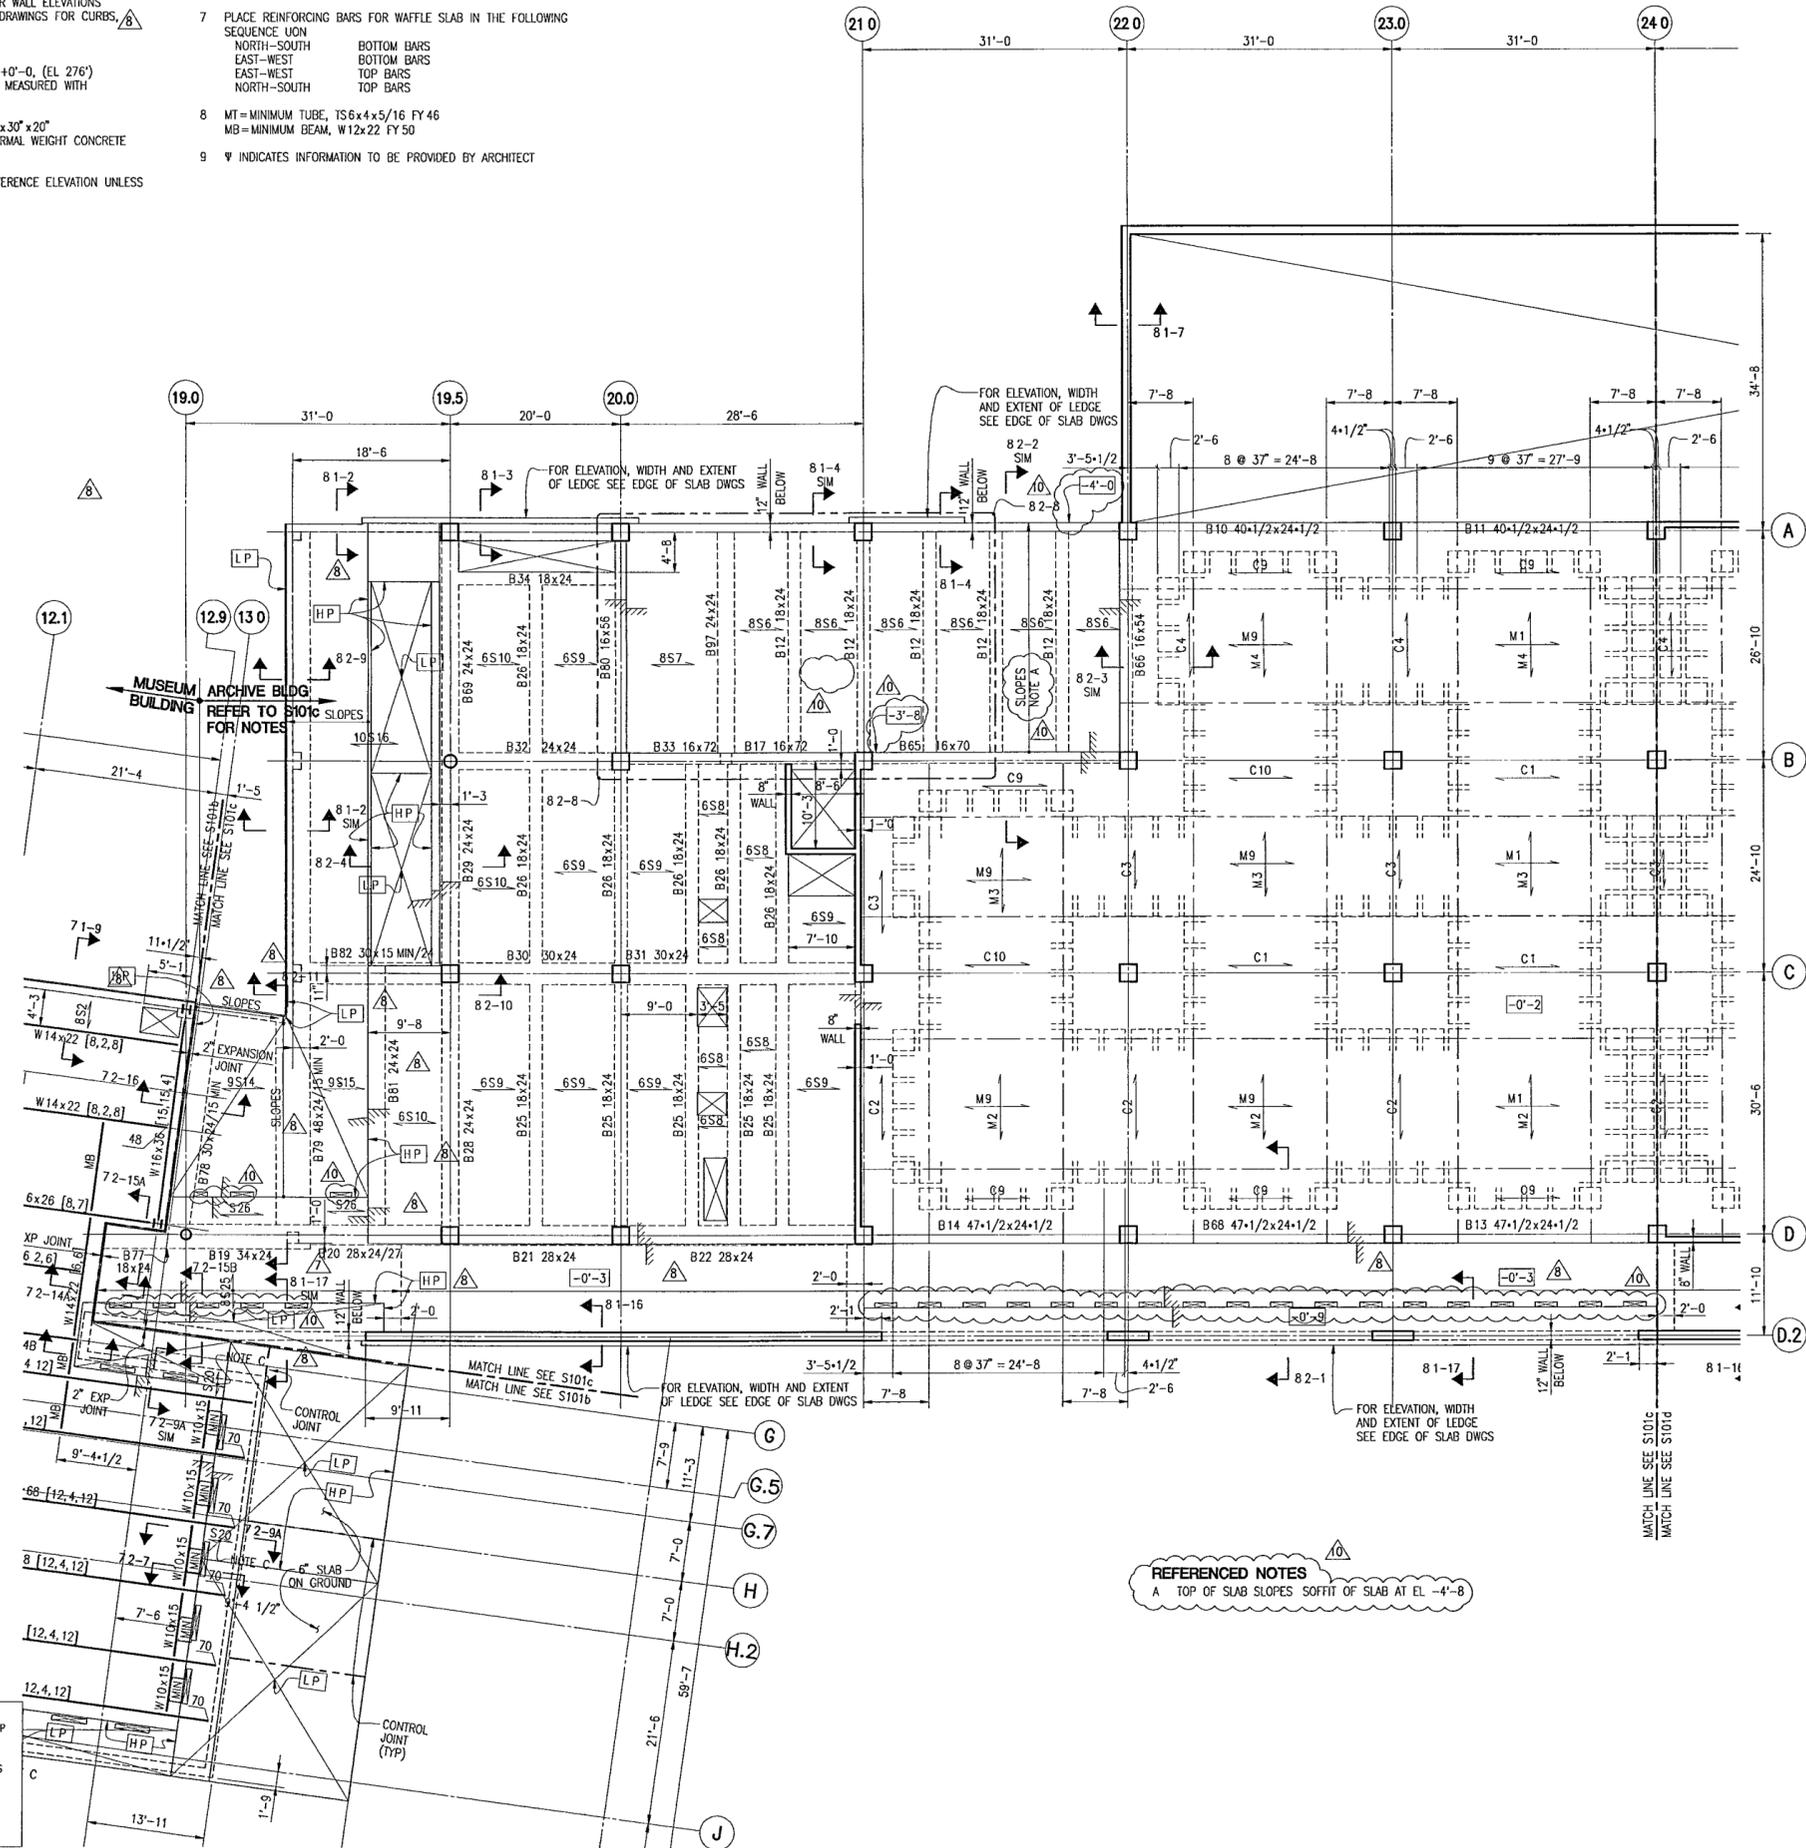

© Copyright LESLIE E. ROBERTSON ASSOCIATES R.L.L.P.
WARNING IT IS A VIOLATION OF LAW FOR ANY PERSON, UNLESS ACTING UNDER THE DIRECTION OF A PROFESSIONAL LICENSED IN THE STATE OF THIS PROJECT TO ALTER IN ANY WAY THESE DRAWINGS WHERE ANY ITEM IS ALTERED, THE SUPERVISING PROFESSIONAL SHALL AFFIX TO THIS ITEM HIS SEAL AND THE DESCRIPTION ALTERED BY FOLLOWED BY HIS SIGNATURE, THE DATE, AND A SPECIFIC DESCRIPTION OF THE ALTERATION