

**WILLIAM J CLINTON
PRESIDENTIAL
CENTER**

LITTLE ROCK, ARKANSAS

Architect
POLSHEK PARTNERSHIP LLP
320 West 13th Street
New York, New York 10014
212.667.7171

Coordinating Architects
POLK STANLEY YEARY ARCHITECTS LM
700 South Schaller Street
Little Rock, Arkansas 72201
501.378.0878

WITSELL EVANS RASCO
501 West Third Street
Little Rock, Arkansas 72201
501.374.5300

WOODS CARADINE ARCHITECTS
2200 South Main Street
Little Rock, Arkansas 72206
501.374.4060

Landscape Architects
HARGREAVES ASSOCIATES
118 Magazine Street
Cambridge, Massachusetts 02139
617.861.0070

LANDSCAPE ARCHITECTURE, Inc.
2300 Cottondale Lane Suite 202
Little Rock, Arkansas 72202
501.374.5610

Structural Engineer
LESLIE E. ROBERTSON ASSOC., RLLP
30 Broad Street, 4th Floor
New York, New York 10004
212.750.9000


MEP Engineers
FLACK + KURTZ Inc
475 Fifth Avenue
New York, New York 10017
212.532.9600

CROWMELL ARCHITECTS ENGINEERS
101 South Spring Street
Little Rock, Arkansas 72201
501.372.2900

Curtainwall Consultant
R. A. HEINTGES ARCHITECTS
125 Fifth Avenue, 9th Floor
New York, New York 10011
212.652-2966

Seal


9	100% CONSTRUCTION DOCS	09/27/02
8	90% PROGRESS PRINTING	08/30/02
7	AS IS	08/20/02
6	100% STRUCTURAL CD	07/01/02
5	100% STL & CONC CD	05/15/02
4	BUILDING DEPT	03/18/02
3	BID ISSUE	03/01/02
2	75% DESIGN LEVEL	01/25/02
1	50% DESIGN LEVEL	12/19/01
Issue		Date

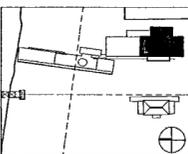

Job No. 9908
Scale 1/8"=1'-0"
Date DEC 11, 2001
Title

**GROUND LEVEL
PLAN**

Sheet No. **S101d**

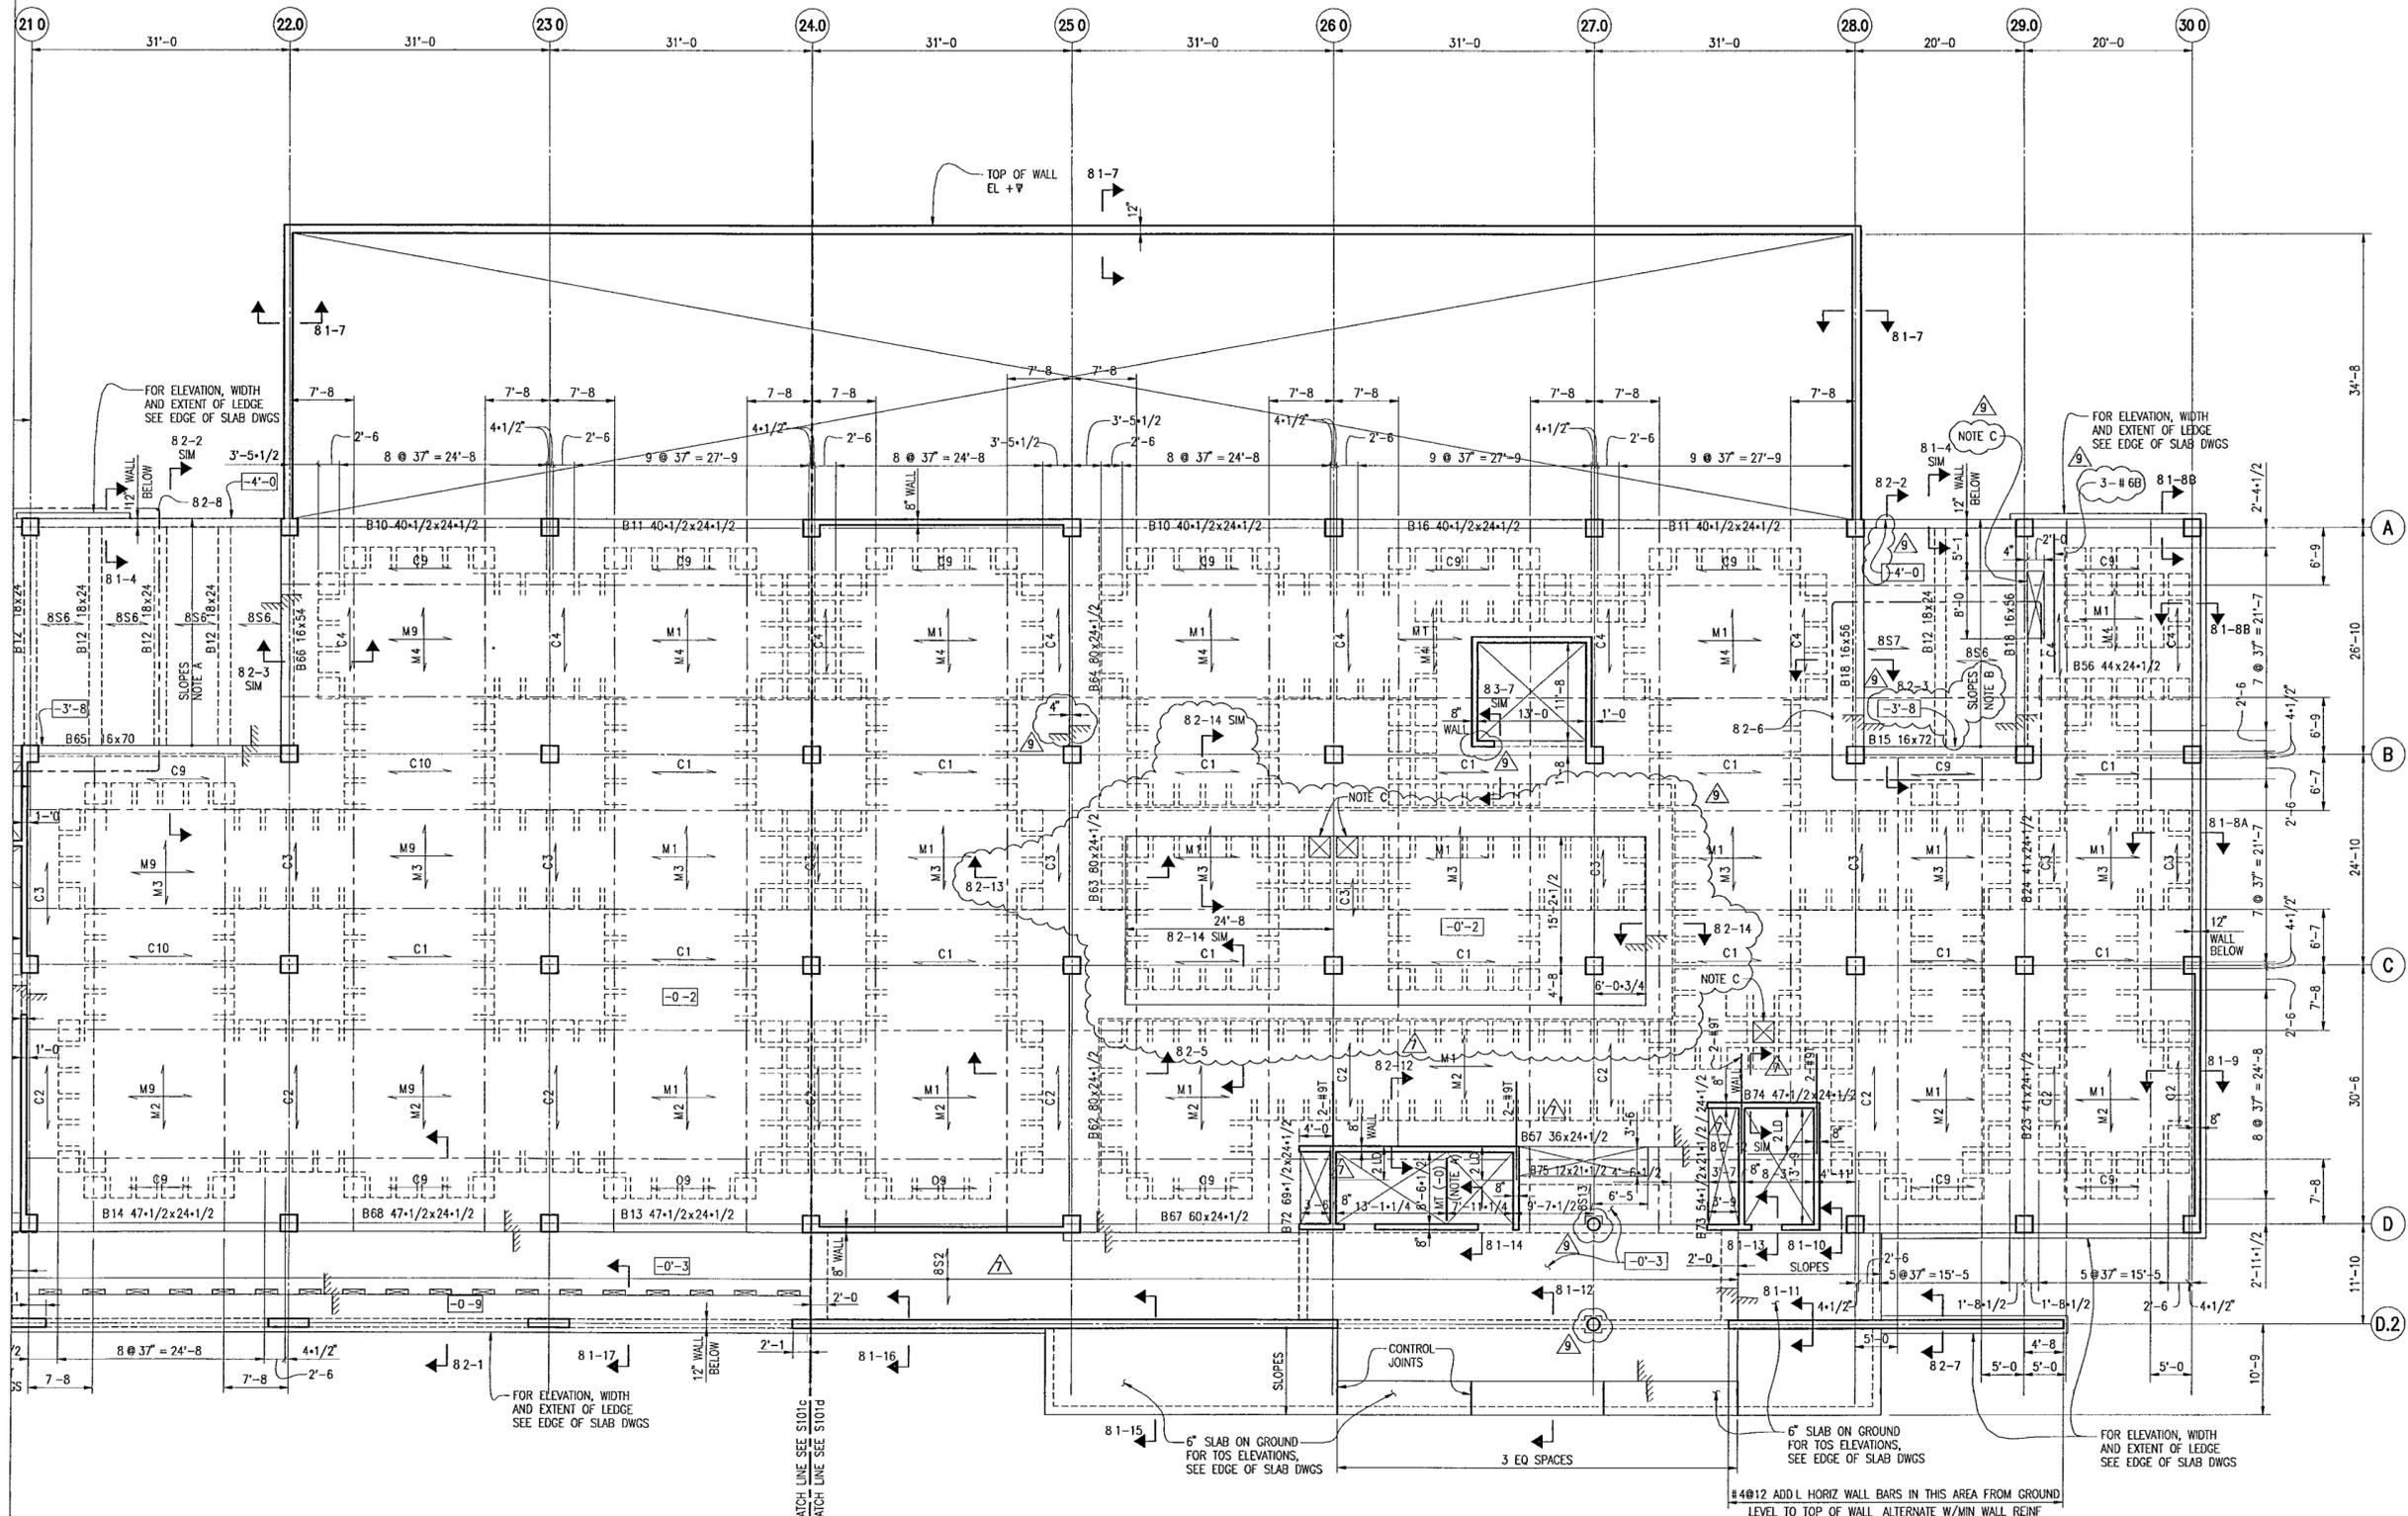

NOTES.
1 REFER TO S101c FOR NOTES

REFERENCED NOTES:
A. PROVIDE ADDITIONAL MT (NOT SHOWN IN PLAN) AT ELEVATIONS -8'-0" AND +8'-0"
B. TOP OF SLAB SLOPES SOFFIT OF SLAB AT EL -4'-8"
C. DETAIL TOP REINFORCEMENT AT OPENING PER TYPICAL DETAIL FOR ONE-WAY SLAB OPENING

© Copyright LESLIE E. ROBERTSON ASSOCIATES, RLLP
WARNING IT IS A VIOLATION OF LAW FOR ANY PERSON, UNLESS ACTING UNDER THE DIRECTION OF A PROFESSIONAL LICENSED IN THE STATE OF THIS PROJECT, TO ALTER IN ANY WAY THESE DRAWINGS WHERE ANY ITEM IS ALTERED, THE SUPERVISING PROFESSIONAL SHALL AFFIX TO THE ITEM HIS SEAL AND THE DESCRIPTION ALTERED BY FOLLOWED BY HIS SIGNATURE, THE DATE, AND A SPECIFIC DESCRIPTION OF THE ALTERATION

FOR OFFICIAL USE ONLY