

**WILLIAM J CLINTON
PRESIDENTIAL
CENTER**

LITTLE ROCK, ARKANSAS

Architect

POLSHEK PARTNERSHIP LLP
320 West 13th Street
New York, New York 10014
212.607.7171

Coordinating Architects

POLK STANLEY YEARY ARCHITECTS LPA
700 South Schiller Street
Little Rock, Arkansas 72201
501.378.0878

WITSELL EVANS RASCO
501 West Third Street
Little Rock, Arkansas 72201
501.374.5300

WOODS CARADINE ARCHITECTS
2200 South Main Street
Little Rock, Arkansas 72206
501.374.4060

Landscape Architects

HARGREAVES ASSOCIATES
118 Magazine Street
Cambridge, Massachusetts 02139
617.661.0070

LANDSCAPE ARCHITECTURE, Inc.
2300 Cottondale Lane Suite 202
Little Rock, Arkansas 72202
501.374.5610

Structural Engineer

LESLIE E. ROBERTSON ASSOC., RLLP
30 Broad Street, 4th Floor
New York, New York 10004
212.750.9000

MEP Engineers

FLACK + KURTZ Inc.
475 Fifth Avenue
New York, New York 10017
212.532.9600


CROMWELL ARCHITECTS ENGINEERS
101 South Spring Street
Little Rock, Arkansas 72201
501.372.2900

Curriculum Consultant

R. A. HENTGES ARCHITECTS
126 Fifth Avenue, 9th Floor
New York, New York 10011
212.652.2968

Seal

8	100% CONSTRUCTION DOCS	09/27/02
7	90% PROGRESS PRINTING	08/30/02
6	100% STRUCTURAL CD	07/01/02
5	100% STL & CONC CD	05/15/02
4	BUILDING DEPT	03/18/02
3	BID ISSUE	03/01/02
2	75% DESIGN DEVEL.	01/25/02
1	50% DESIGN DEVEL.	12/19/01
	Issue	Date

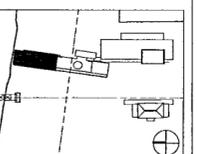

Job No 0908

Scale 1/8"=1'-0"

Date DEC 11, 2001

Title

**SECOND LEVEL
PLAN**

Sheet No

S102a


NOTES:

- REFER TO THE STRUCTURAL DRAWING BOOK FOR GENERAL NOTES, TYPICAL DETAILS, SCHEDULES AND ALL REFERENCED DETAILS AND SECTIONS REFER TO S110 SERIES DRAWINGS FOR ADDITIONAL SLAB REINFORCEMENT AND S220 SERIES DRAWINGS FOR WALL ELEVATIONS AND REINFORCEMENT REFER TO EDGE OF SLAB DRAWINGS FOR SLAB EDGE LOCATIONS AND DIMENSIONS
- TOP OF CONCRETE IS AT REFERENCE ELEVATION +13'-10", UNLESS OTHERWISE NOTED [XXX], WHERE XXX IS MEASURED WITH RESPECT TO REFERENCE ELEVATION
- TOP OF STRUCTURAL STEEL IS (-6'-1/2") BELOW REFERENCE ELEVATION UNLESS OTHERWISE NOTED
- FLOOR CONSTRUCTION IS 3-1/2" LIGHTWEIGHT CONCRETE (F'C=3 KSI) OVER 3" COMPOSITE DECK, TYPE D2, UNLESS OTHERWISE NOTED
- STEEL DECK SPANS IN THE SHORT DIRECTION UNLESS NOTED PROVIDE PERMANENT DECK SUPPORTS AT COLUMNS AND WALLS UNLESS OTHERWISE NOTED
- SOLID CONCRETE SLAB IS INDICATED \rightarrow THIS IS A FORMED SLAB, THERE IS NO STEEL DECK

- CONCRETE STRENGTH AND WEIGHT
SLAB ON DECK F'C=3000 PSI, LW
FORMED SLABS F'C=4000 PSI, NW
WALLS F'C=4000 PSI, NW
COLUMNS F'C=4000 PSI, NW
- STRUCTURAL STEEL SHAPES SHALL BE FY50 UNLESS OTHERWISE NOTED CONNECTION PLATES SHALL BE FY36 U O M
PIPES SHALL BE FY36
TUBES SHALL BE FY46
ANGLES SHALL BE FY36
- INTERIOR WALLS ARE 12" CONCRETE WALLS UNLESS OTHERWISE NOTED
- NUMBER OF 3/4" x 5-1/2" LONG STUD SHEAR CONNECTORS APPLIED TO THE TOP FLANGE OF BEAM IS NOTED THUS []
- SB=ELEVATOR SEPARATOR BEAM, TS6x4x5/16
SC=STAIR HEADER CHANNEL, C12x20 7 FY36
MB=MINIMUM BEAM, W12x22 [MIN]
LA=L-3x3x5/16 DECK SUPPORT ANGLE
- \rightarrow INDICATES MOMENT CONNECTION
- CAMBER IN INCHES IS GIVEN THUS, C
- ∇ INDICATES INFORMATION TO BE PROVIDED BY OTHERS

REFERENCED NOTES.


- WHERE NOTED, NUMBER OF 3/4" x 5-1/2" LONG STUD SHEAR CONNECTORS APPLIED TO THE TOP FLANGE OF BEAM IS NOTED THUS []
- SEE 7-2-18 FOR ADDITIONAL STEEL FRAMING IN CONCRETE CORES
- PROVIDE ELEVATOR RAIL SUPPORT SEE 7-1-32 FOR ELEVATION

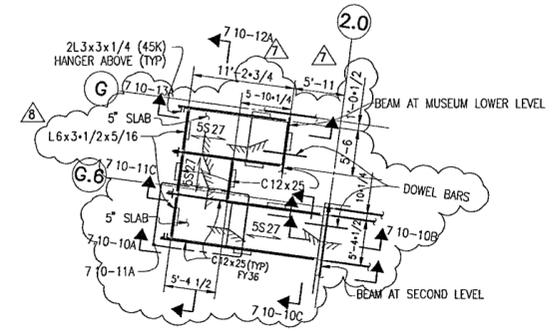

A PART PLAN EGRESS STAIR
FOR INFORMATION NOT SHOWN SEE ARCH DWGS

PART PLAN NOTES

- STAIR SLABS AND CURBS ARE F'C=4000 PSI, NW
- PAINT STEEL OF STAIR WITH ZINC RICH PRIMER

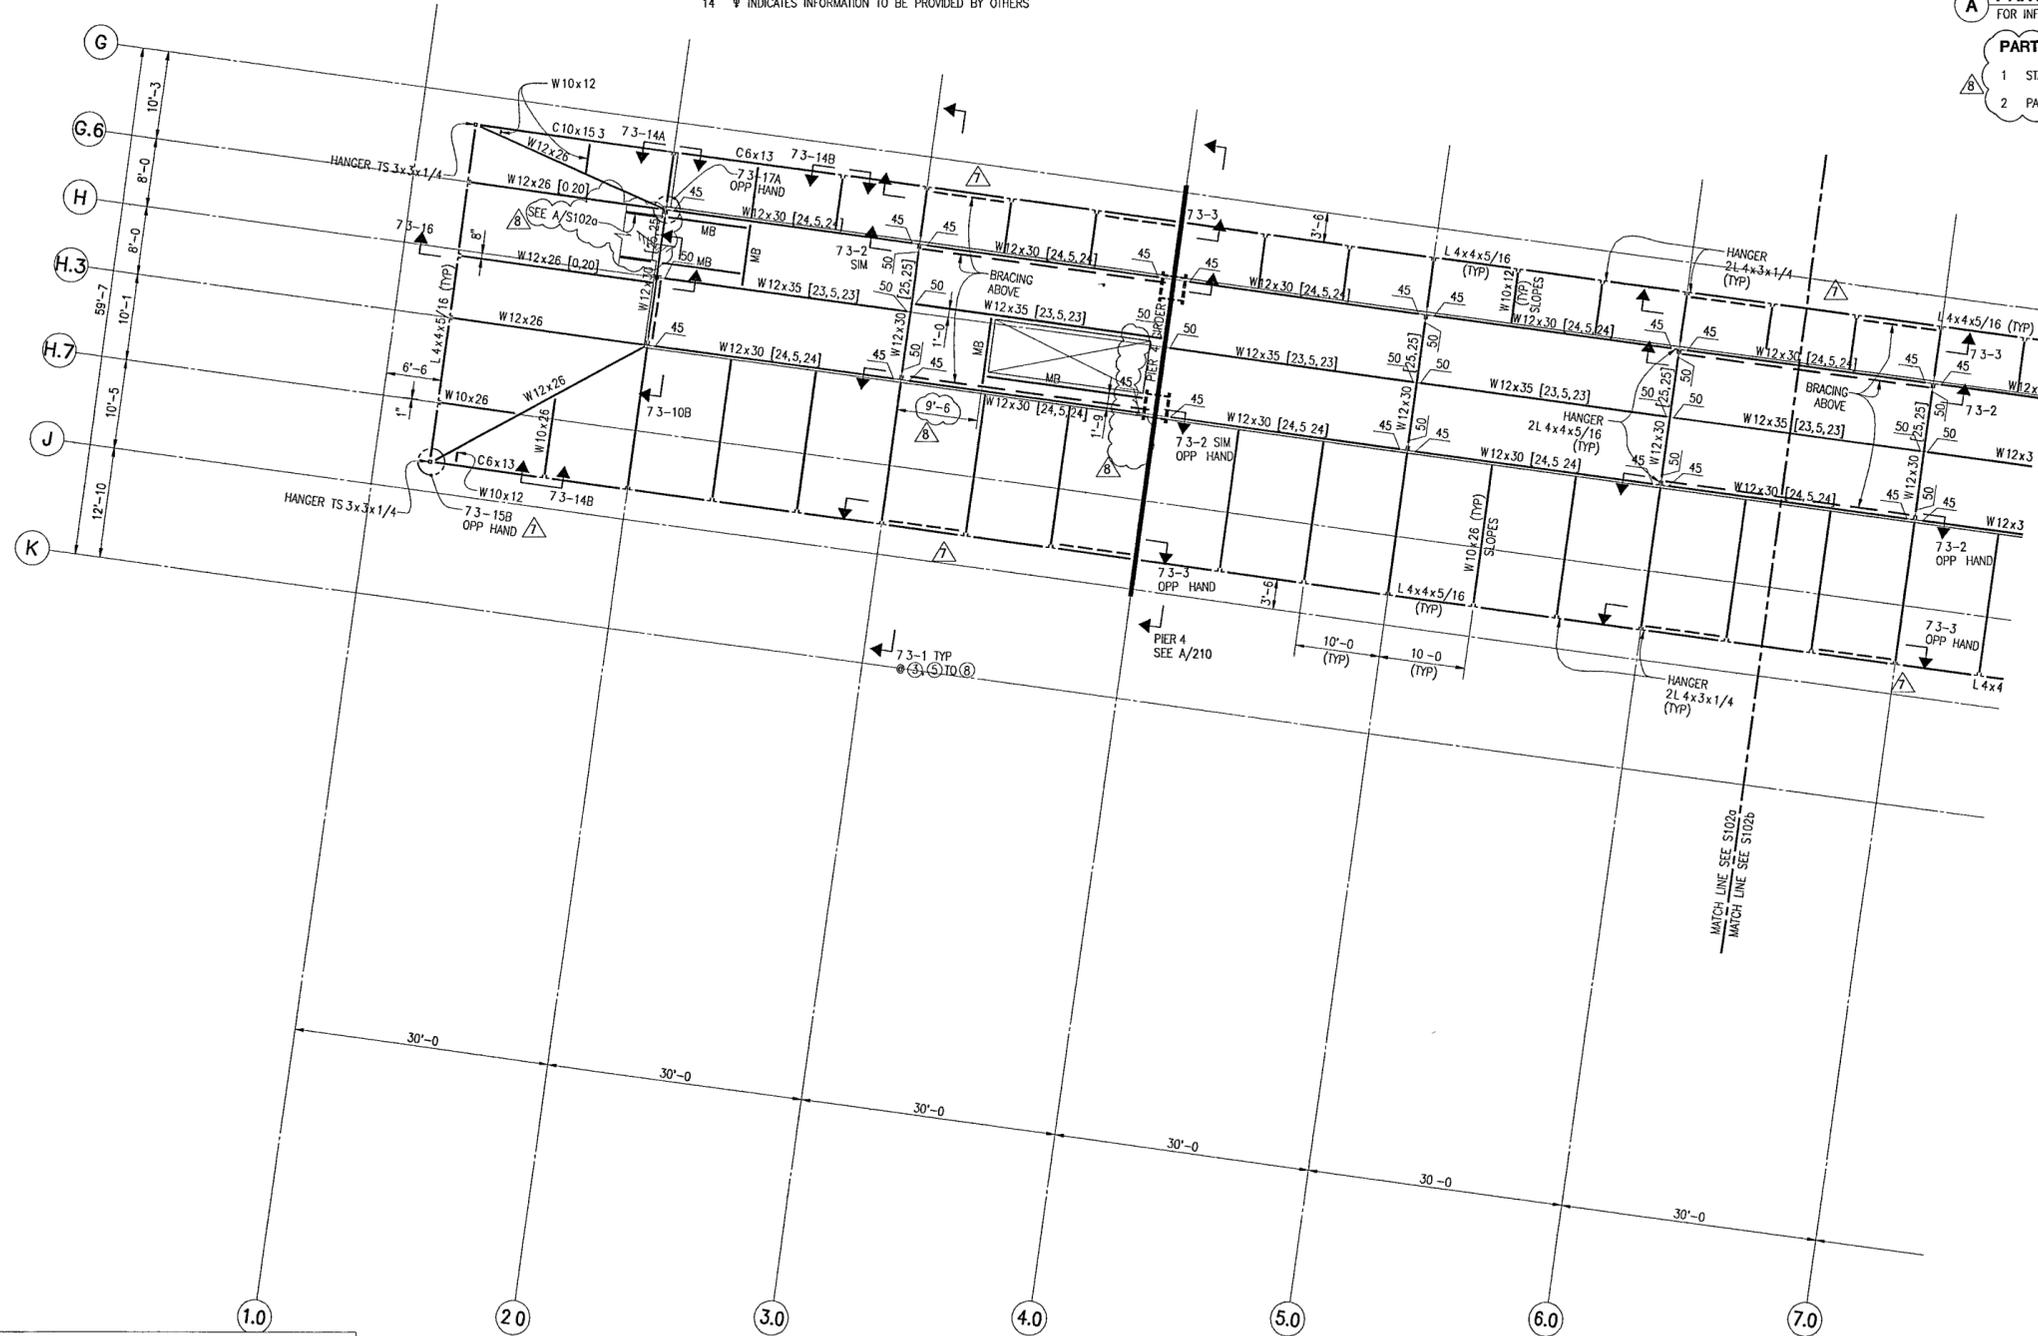

© Copyright LESLIE E. ROBERTSON ASSOCIATES, RLLP
WARNING IT IS A VIOLATION OF LAW FOR ANY PERSON, UNLESS ACTING UNDER THE DIRECTION OF A PROFESSIONAL LICENSED IN THE STATE OF THIS PROJECT, TO ALTER IN ANY WAY THESE DRAWINGS WHERE ANY ITEM IS ALTERED THE SUPERVISING PROFESSIONAL SHALL AFFIX TO THE ITEM HIS SEAL AND THE INSCRIPTION ALTERED BY FOLLOWED BY HIS SIGNATURE, THE DATE AND A SPECIFIC DESCRIPTION OF THE ALTERATION