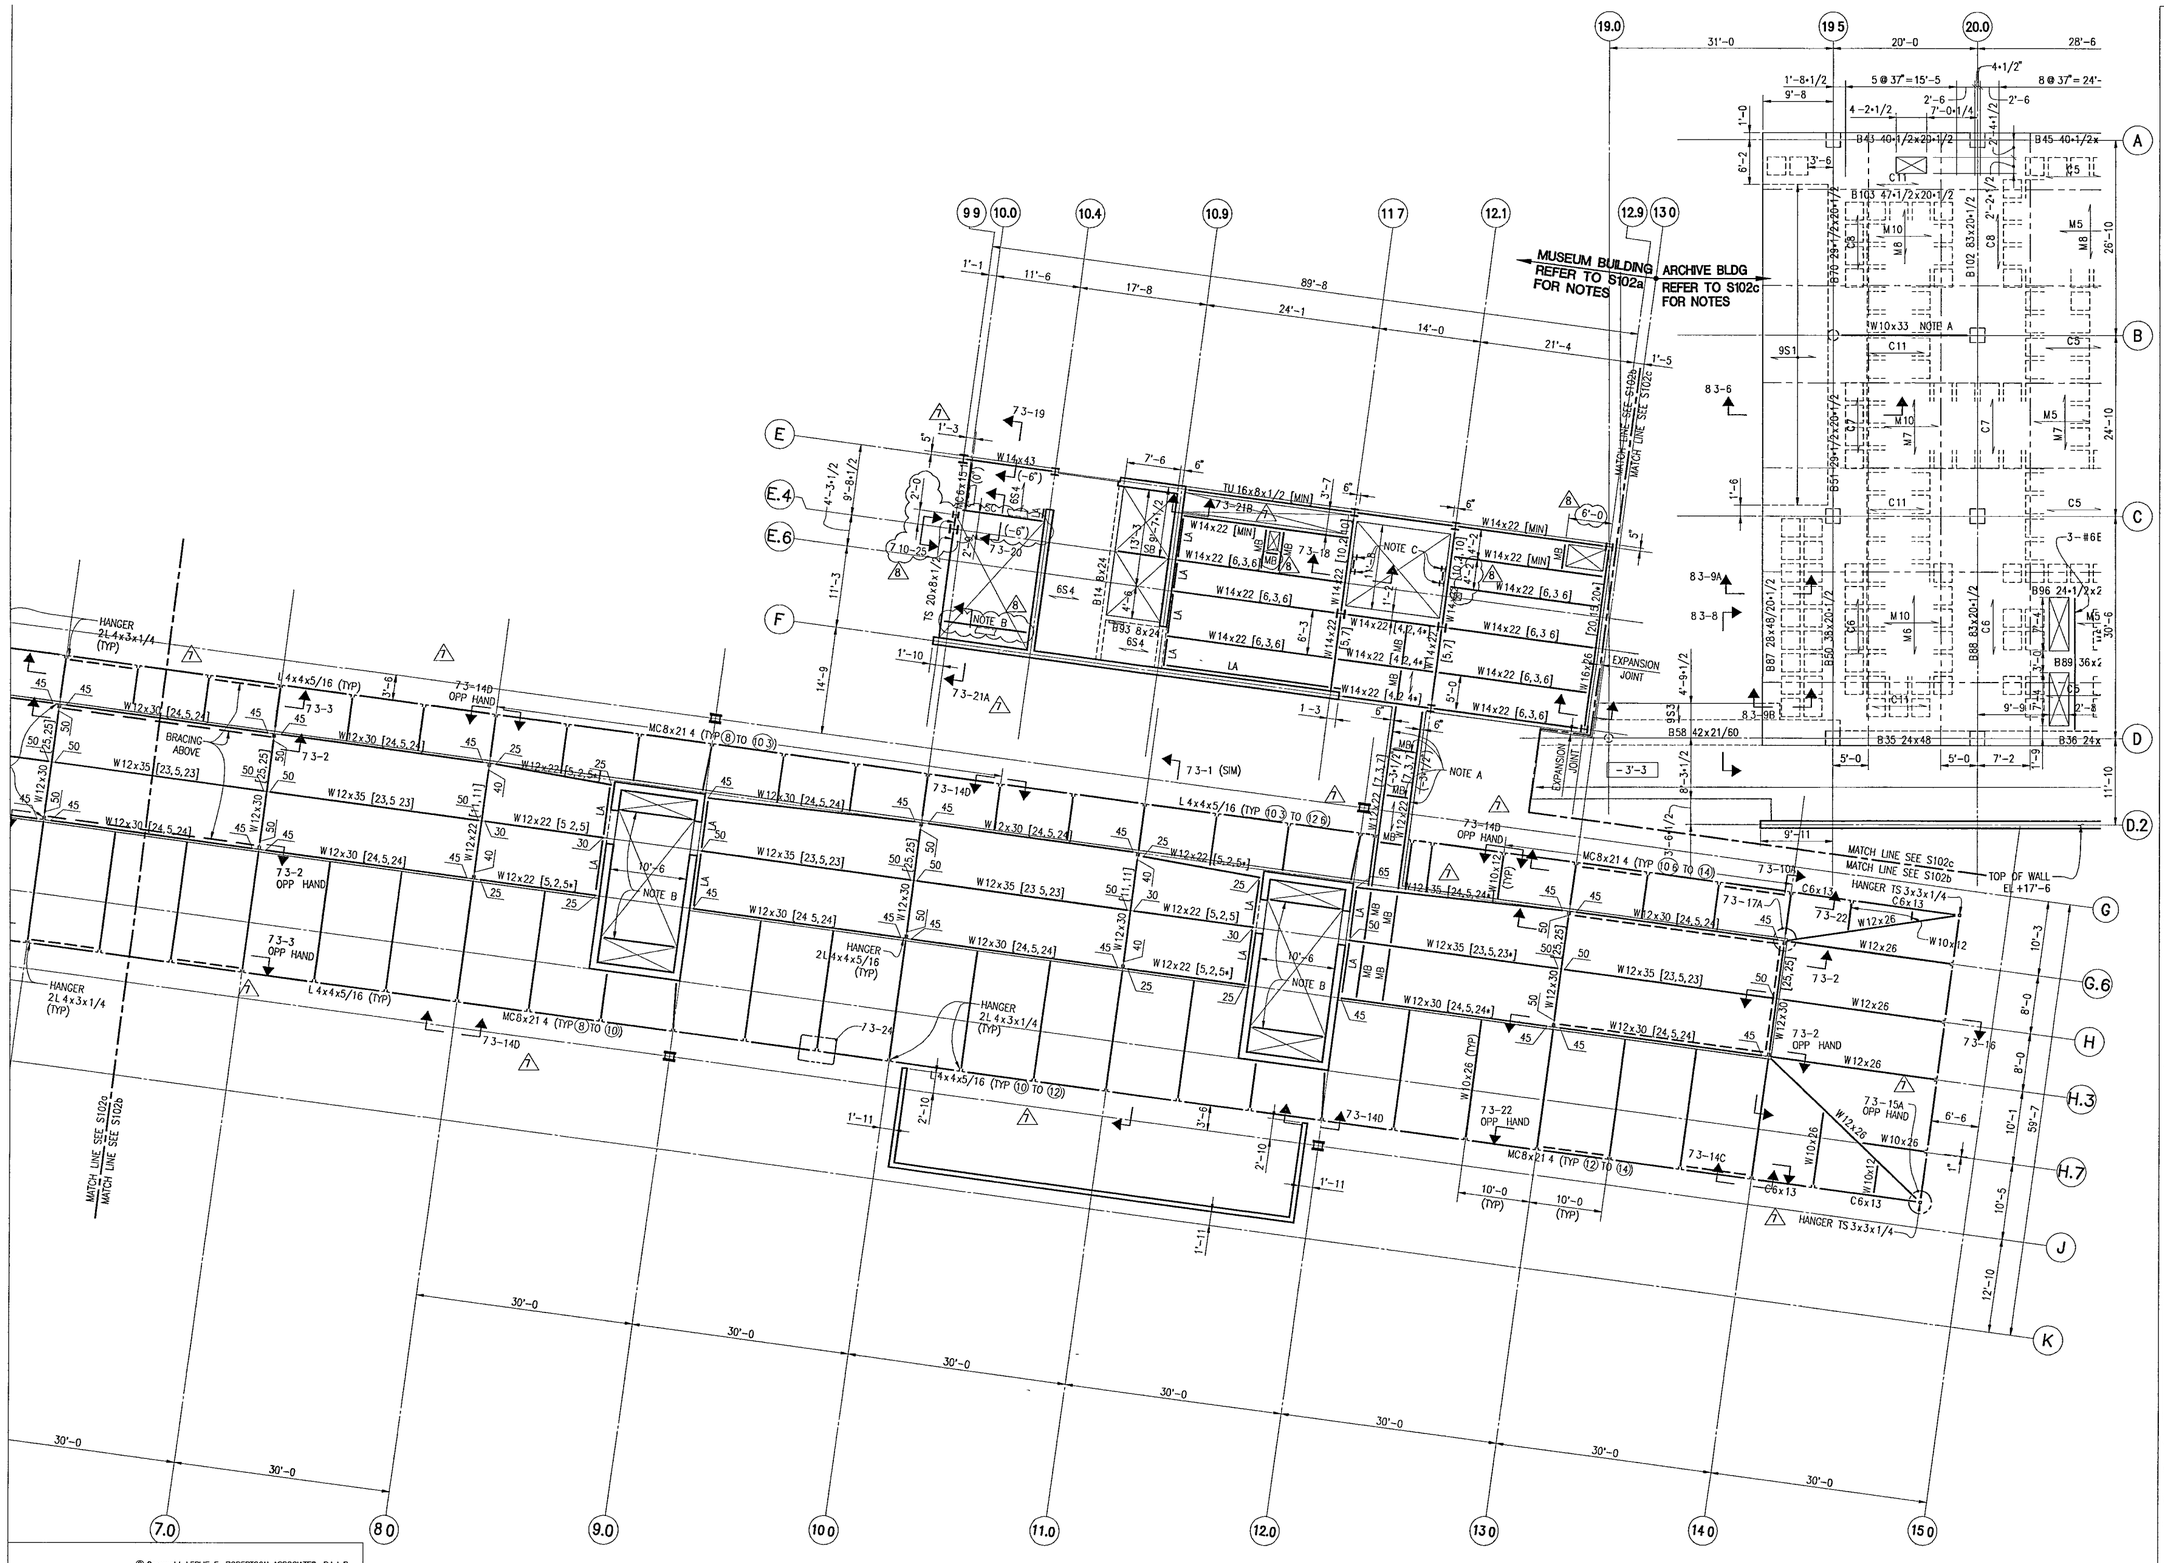

© Copyright LESLIE E ROBERTSON ASSOCIATES, R L L P

WARNING IT IS A VIOLATION OF LAW FOR ANY PERSON UNLESS ACTING UNDER THE DIRECTION OF A PROFESSIONAL, LICENSED IN THE STATE OF THIS PROJECT TO ALTER IN ANY WAY THESE DRAWINGS WHERE ANY ITEM IS ALTERED THE SUPERVISING PROFESSIONAL SHALL AFFIX TO THE ITEM HIS SEAL AND THE INSCRIPTION "ALTERED BY" FOLLOWED BY HIS SIGNATURE THE DATE, AND A SPECIFIC DESCRIPTION OF THE ALTERATION

SAVE Sep 27 2002 3 32pm PRINT Sep 27 2002 4 38pm

WILLIAM J CLINTON PRESIDENTIAL CENTER

LITTLE ROCK, ARKANSAS

Architect

POLSHEK PARTNERSHIP LLP
320 West 13th Street
New York, New York 10014
212.807 7171

Coordinating Architects

POLK STANLEY YEARY ARCHITECTS Ltd
700 South Schiller Street
Little Rock, Arkansas 72201
501 378 0878

WITSELL EVANS RASCO
901 West Third Street
Little Rock, Arkansas 72201
501 374 5300

WOODS CARADINE ARCHITECTS
2200 South Main Street
Little Rock, Arkansas 72206
501.374.4060

Landscape Architects

HARGREAVES ASSOCIATES
118 Magazine Street
Cambridge, Massachusettes 02139
617.661 0070

LANDSCAPE ARCHITECTURE, Inc.
2300 Cottondale Lane Suite 202
Little Rock, Arkansas 72202
501 374 5610

Structural Engineer

LESLIE E. ROBERTSON ASSOC RLLP
30 Broad Street, 47th Floor
New York, New York 10004
212 750 9000

MEP Engineers

FLACK + KURTZ Inc
475 Fifth Avenue
New York, New York 10017
212 532 9600

CROMWELL ARCHITECTS ENGINEERS
101 South Spring Street
Little Rock, Arkansas 72201
501.372.2900

Curtainwall Consultant

R. A. HEINTGES ARCHITECTS
126 Fifth Avenue, 9th Floor
New York, New York 10011
212 652-2966

Seal

Issue		Date
8	100% CONSTRUCTION DOCS	09/27/02
7	90% PROGRESS PRINTING	08/30/02
6	100% STRUCTURAL CD	07/01/02
5	100% STL & CONC CD	05/15/02
4	BUILDING DEPT	03/18/02
3	BID ISSUE	03/01/02
2	75% DESIGN DEVEL.	01/25/02
1	50% DESIGN DEVEL.	12/19/01

Job No 9908

Scale 1/8"=1'-0

Date DEC 11, 2001

Title

SECOND LEVEL PLAN

Sheet No

S102b

FOR OFFICIAL USE ONLY