


NOTES:

- REFER TO THE STRUCTURAL DRAWING BOOK FOR GENERAL NOTES, TYPICAL DETAILS, SCHEDULES AND ALL REFERENCED DETAILS AND SECTIONS REFER TO S220 SERIES DRAWINGS FOR WALL ELEVATIONS AND REINFORCEMENT REFER TO SLAB EDGE DRAWINGS FOR SLAB EDGE LOCATIONS AND DIMENSIONS
- TOP OF CONCRETE IS AT REFERENCE ELEVATION +16'-0", UNLESS OTHERWISE NOTED [XXX], WHERE XXX IS MEASURED WITH RESPECT TO REFERENCE ELEVATION
- ROOF CONSTRUCTION IS WAFFLE SLAB WITH 30" x 30" x 16" DOMES, 7" JOISTS @ 37" O.C. AND 4-1/2" NORMAL WEIGHT CONCRETE TOP SLAB, UNLESS OTHERWISE NOTED
- FLOOR CONSTRUCTION AT OFFICE IS 9" NORMAL WEIGHT CONCRETE FLAT SLAB WITH 8" DROP PANELS UNLESS OTHERWISE NOTED
- TOP OF STRUCTURAL STEEL IS (-0') BELOW REFERENCE ELEVATION UNLESS OTHERWISE NOTED

- CONCRETE STRENGTH AND WEIGHT
SLABS FC = 4000 PSL, NW
WALLS & COLUMNS FC = 4000 PSL, NW
- CONCRETE BEAMS ARE DESIGNATED BxD WHERE B IS THE WIDTH IN INCHES AND D IS THE DEPTH (INCLUDING THE SLAB) IN INCHES
- PLACE REINFORCING BARS FOR WAFFLE SLAB IN THE FOLLOWING SEQUENCE UON
NORTH-SOUTH BOTTOM BARS
EAST-WEST BOTTOM BARS
EAST-WEST TOP BARS
NORTH-SOUTH TOP BARS
- FOR FLAT SLAB REINFORCEMENT AT OFFICE SEE S102e
- MT=MINIMUM TUBE, TS6x4x5/16 FY 46
MB=MINIMUM BEAM, W12x22 FY 50
- ▽ INDICATES INFORMATION TO BE PROVIDED BY ARCHITECT

REFERENCED NOTES

- A. PAINT BEAM
COORDINATE BEAM ELEVATION AND BOTTOM FLANGE BOLT HOLES WITH MOVEABLE PANEL MANUFACTURER LOCATE TOP OF BEAM A MINIMUM OF 2" BELOW SOFFIT OF WAFFLE SLAB

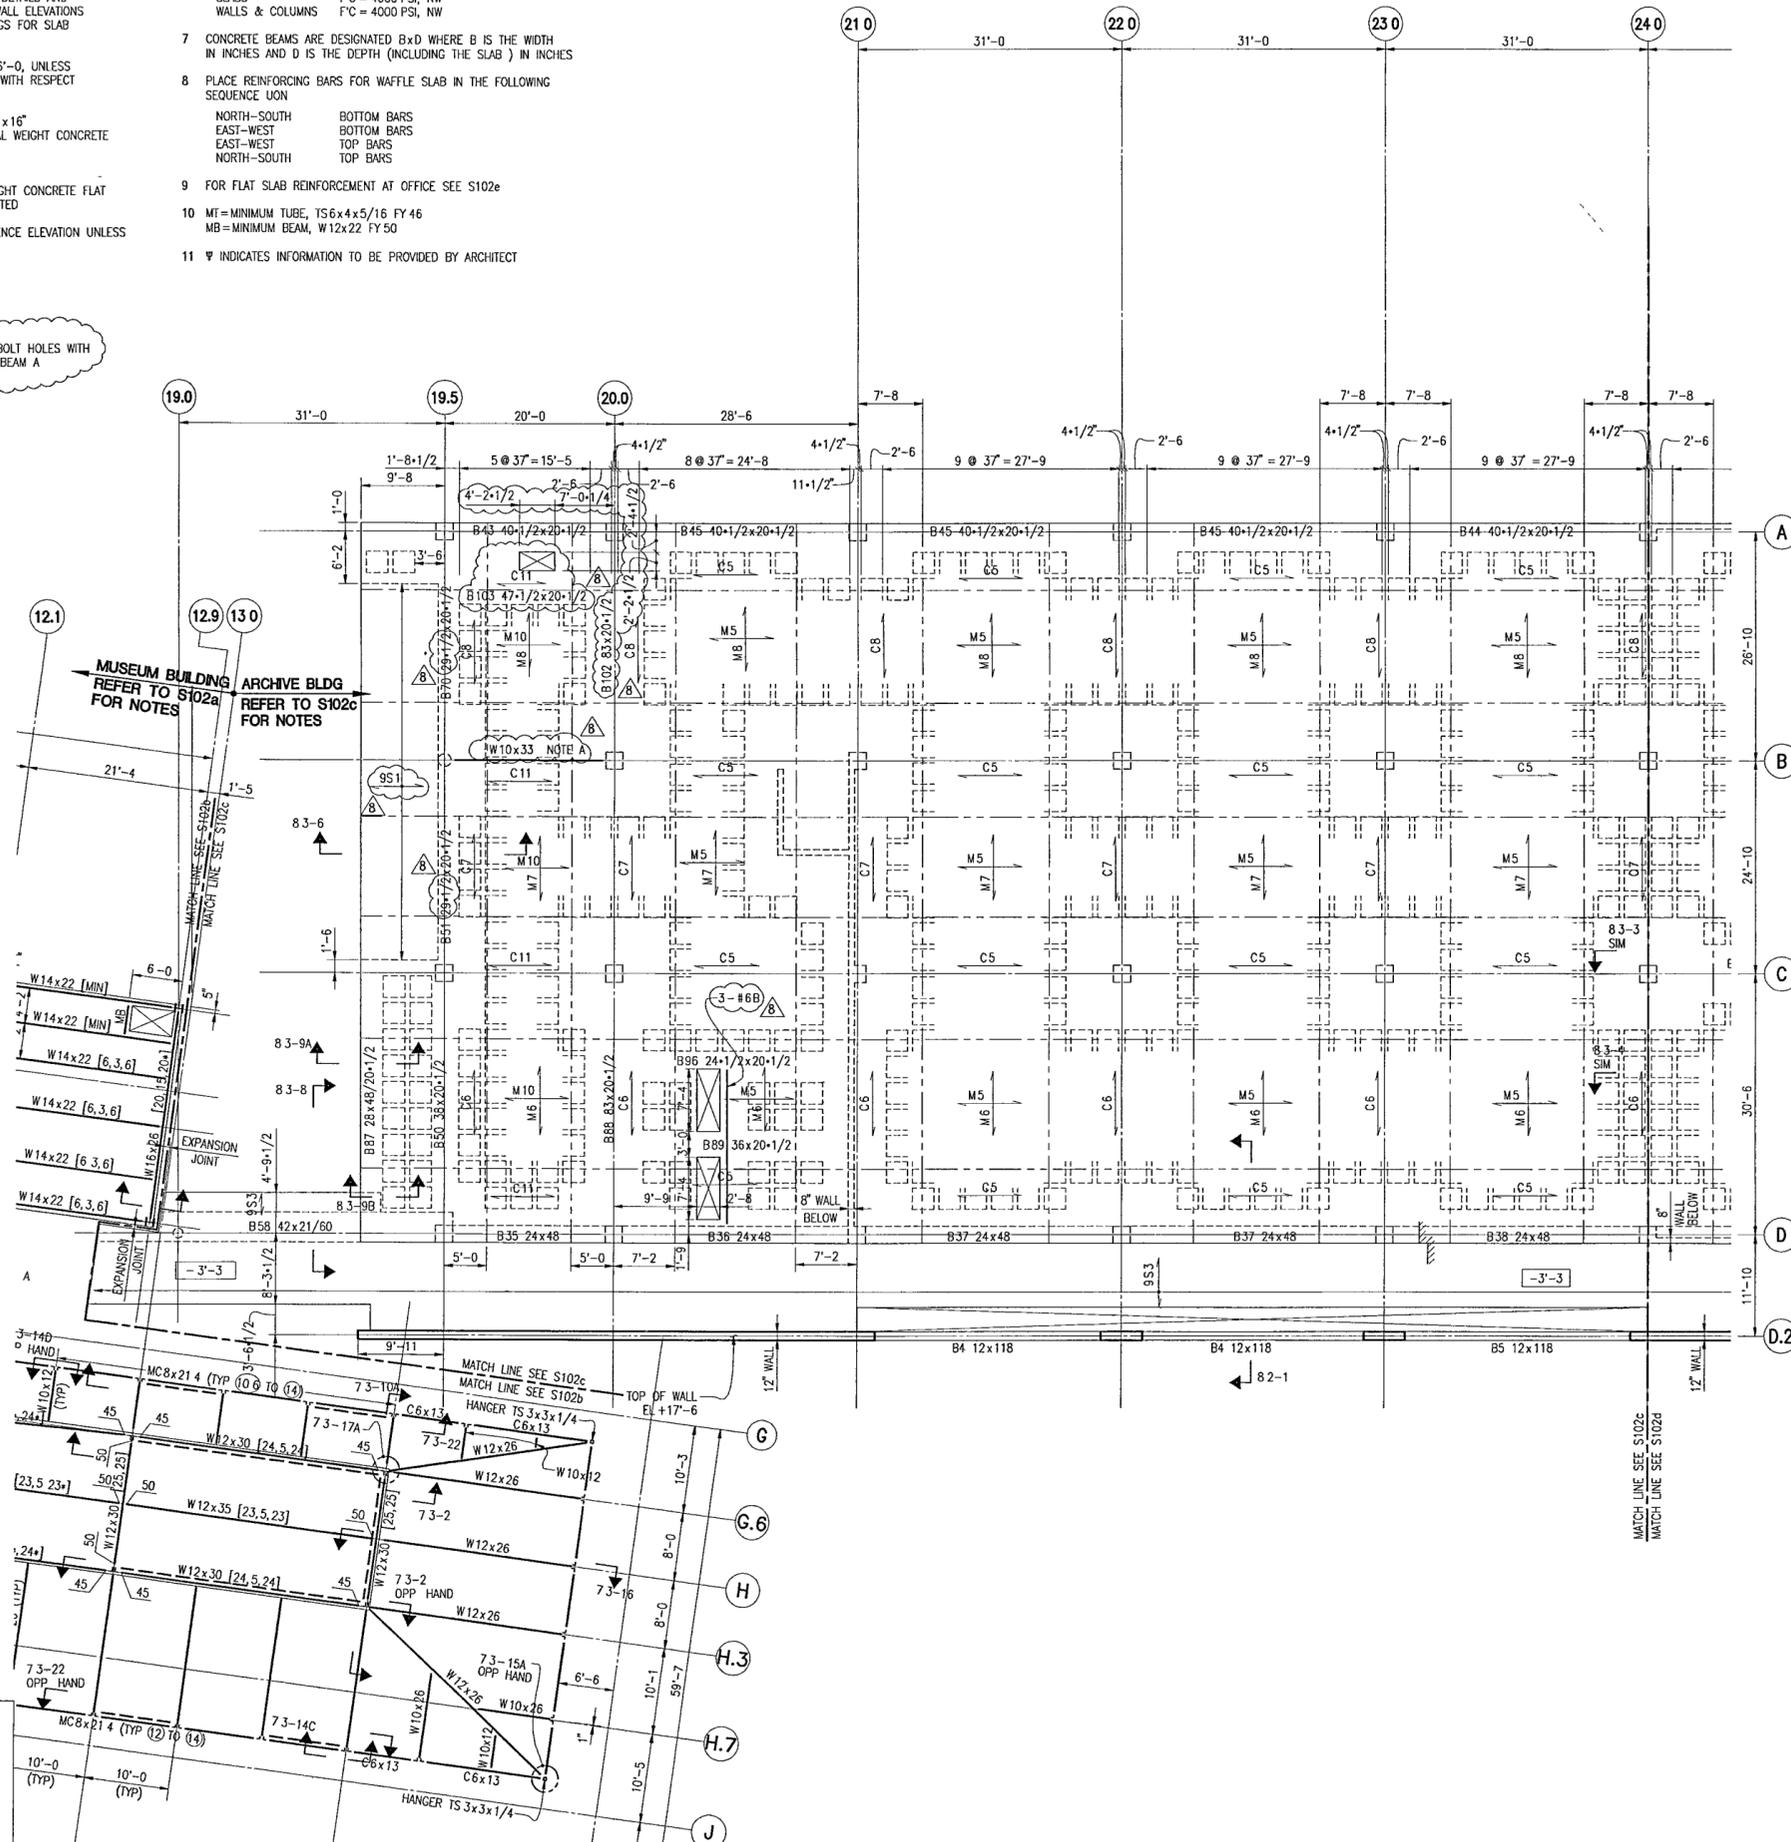

© Copyright LESLIE E. ROBERTSON ASSOCIATES, R.L.L.P.
WARNING IT IS A VIOLATION OF LAW FOR ANY PERSON, UNLESS ACTING UNDER THE DIRECTION OF A PROFESSIONAL LICENSED UNDER THE STATE OF THIS PROJECT, TO ALTER IN ANY WAY THESE DRAWINGS WHERE ANY ITEM IS ALTERED THE SUPERVISING PROFESSIONAL SHALL AFFIX TO THE ITEM HIS SEAL AND THE INSCRIPTION ALTERED BY FOLLOWED BY HIS SIGNATURE, THE DATE, AND A SPECIFIC DESCRIPTION OF THE ALTERATION

**WILLIAM J CLINTON
PRESIDENTIAL
CENTER**

LITTLE ROCK, ARKANSAS

Architect
POLSHAK PARTNERSHIP LLP
 320 West 13th Street
 New York, New York 10014
 212.607.7171

Coordinating Architects
POLK STANLEY YEARY ARCHITECTS Ltd
 700 South Schiller Street
 Little Rock, Arkansas 72201
 501.378.0878

WITSELL EVANS RASCO
 901 West Third Street
 Little Rock, Arkansas 72201
 501.374.5300

WOODS CARADINE ARCHITECTS
 2200 South Main Street
 Little Rock, Arkansas 72206
 501.374.4060

Landscape Architects
HARGREAVES ASSOCIATES
 118 Magazine Street
 Cambridge, Massachusetts 02139
 617.661.0070

LANDSCAPE ARCHITECTURE, Inc.
 2300 Cotontdale Lane Suite 202
 Little Rock, Arkansas 72202
 501.374.5610

Structural Engineer
LESLIE E. ROBERTSON ASSOC., R.L.L.P.
 30 Broad Street, 47th Floor
 New York, New York 10004
 212.750.9000


MEP Engineers
FLACK + KURTZ Inc.
 475 Fifth Avenue
 New York, New York 10017
 212.532.9600

CROMWELL ARCHITECTS ENGINEERS
 101 South Spring Street
 Little Rock, Arkansas 72201
 501.372.2900

Curtainwall Consultant
R.A. HEINTGES ARCHITECTS
 126 Fifth Avenue, 9th Floor
 New York, New York 10011
 212.652.2565

Seal

Issue	Date
8 100% CONSTRUCTION DOCS	09/27/02
7 90% PROGRESS PRINTING	08/30/02
6 100% STRUCTURAL CD	07/01/02
5 100% STL & CONC CD	05/15/02
4 BUILDING DEPT	03/18/02
3 BID ISSUE	03/01/02
2 75% DESIGN DEVEL.	01/25/02
1 50% DESIGN DEVEL.	12/19/01

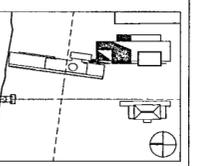

Job No 9908
 Scale 1/8"=1'-0"
 Date DEC 11, 2001
 Title

**SECOND LEVEL
PLAN**

Sheet No
S102c

FOR OFFICIAL USE ONLY