

**WILLIAM J CLINTON  
PRESIDENTIAL  
CENTER**

LITTLE ROCK, ARKANSAS

Architect  
POLSHEK PARTNERSHIP LLP  
320 West 13th Street  
New York, New York 10014  
212.507.7171

Coordinating Architects  
POLK STANLEY YEARY ARCHITECTS Ltd  
700 South Schlar Street  
Little Rock, Arkansas 72201  
501.378.0878

WITSELL EVANS RASCO  
501 West Third Street  
Little Rock, Arkansas 72201  
501.374.5300

WOODS CARADINE ARCHITECTS  
2200 South Main Street  
Little Rock, Arkansas 72208  
501.374.4060

Landscape Architects  
HARGREAVES ASSOCIATES  
118 Magazine Street  
Cambridge, Massachusetts 02139  
617.661.0070

LANDSCAPE ARCHITECTURE, Inc.  
2300 Cottondale Lane Suite 202  
Little Rock, Arkansas 72202  
501.374.5610

Structural Engineer  
LESLIE E. ROBERTSON ASSOC. RLLP  
30 Broad Street, 4th Floor  
New York, New York 10004  
212.750.9000


MEP Engineers  
FLACK + KURTZ Inc.  
475 Fifth Avenue  
New York, New York 10017  
212.532.9600

CRAMWELL ARCHITECTS ENGINEERS  
151 South Spang Street  
Little Rock, Arkansas 72201  
501.372.2900

Curtilwall Consultant  
R. A. HEINTGES ARCHITECTS  
126 Fifth Avenue, 9th Floor  
New York, New York 10011  
212.652.2966

Seal

8	100% CONSTRUCTION DOCS	09/27/02
7	90% PROGRESS PRINTING	08/30/02
6	100% STRUCTURAL CD	07/01/02
5	100% STL & CONC CD	05/15/02
4	BUILDING DEPT	03/18/02
3	BID ISSUE	03/01/02
2	75% DESIGN DEVEL	01/25/02
1	50% DESIGN DEVEL	12/19/01
Issue		Date

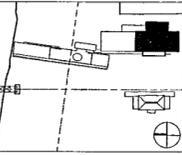


Job No 9908  
Scale 1/8"=1'-0"  
Date DEC 11, 2001  
Title

**SECOND LEVEL PLAN**

Sheet No

**S102d**

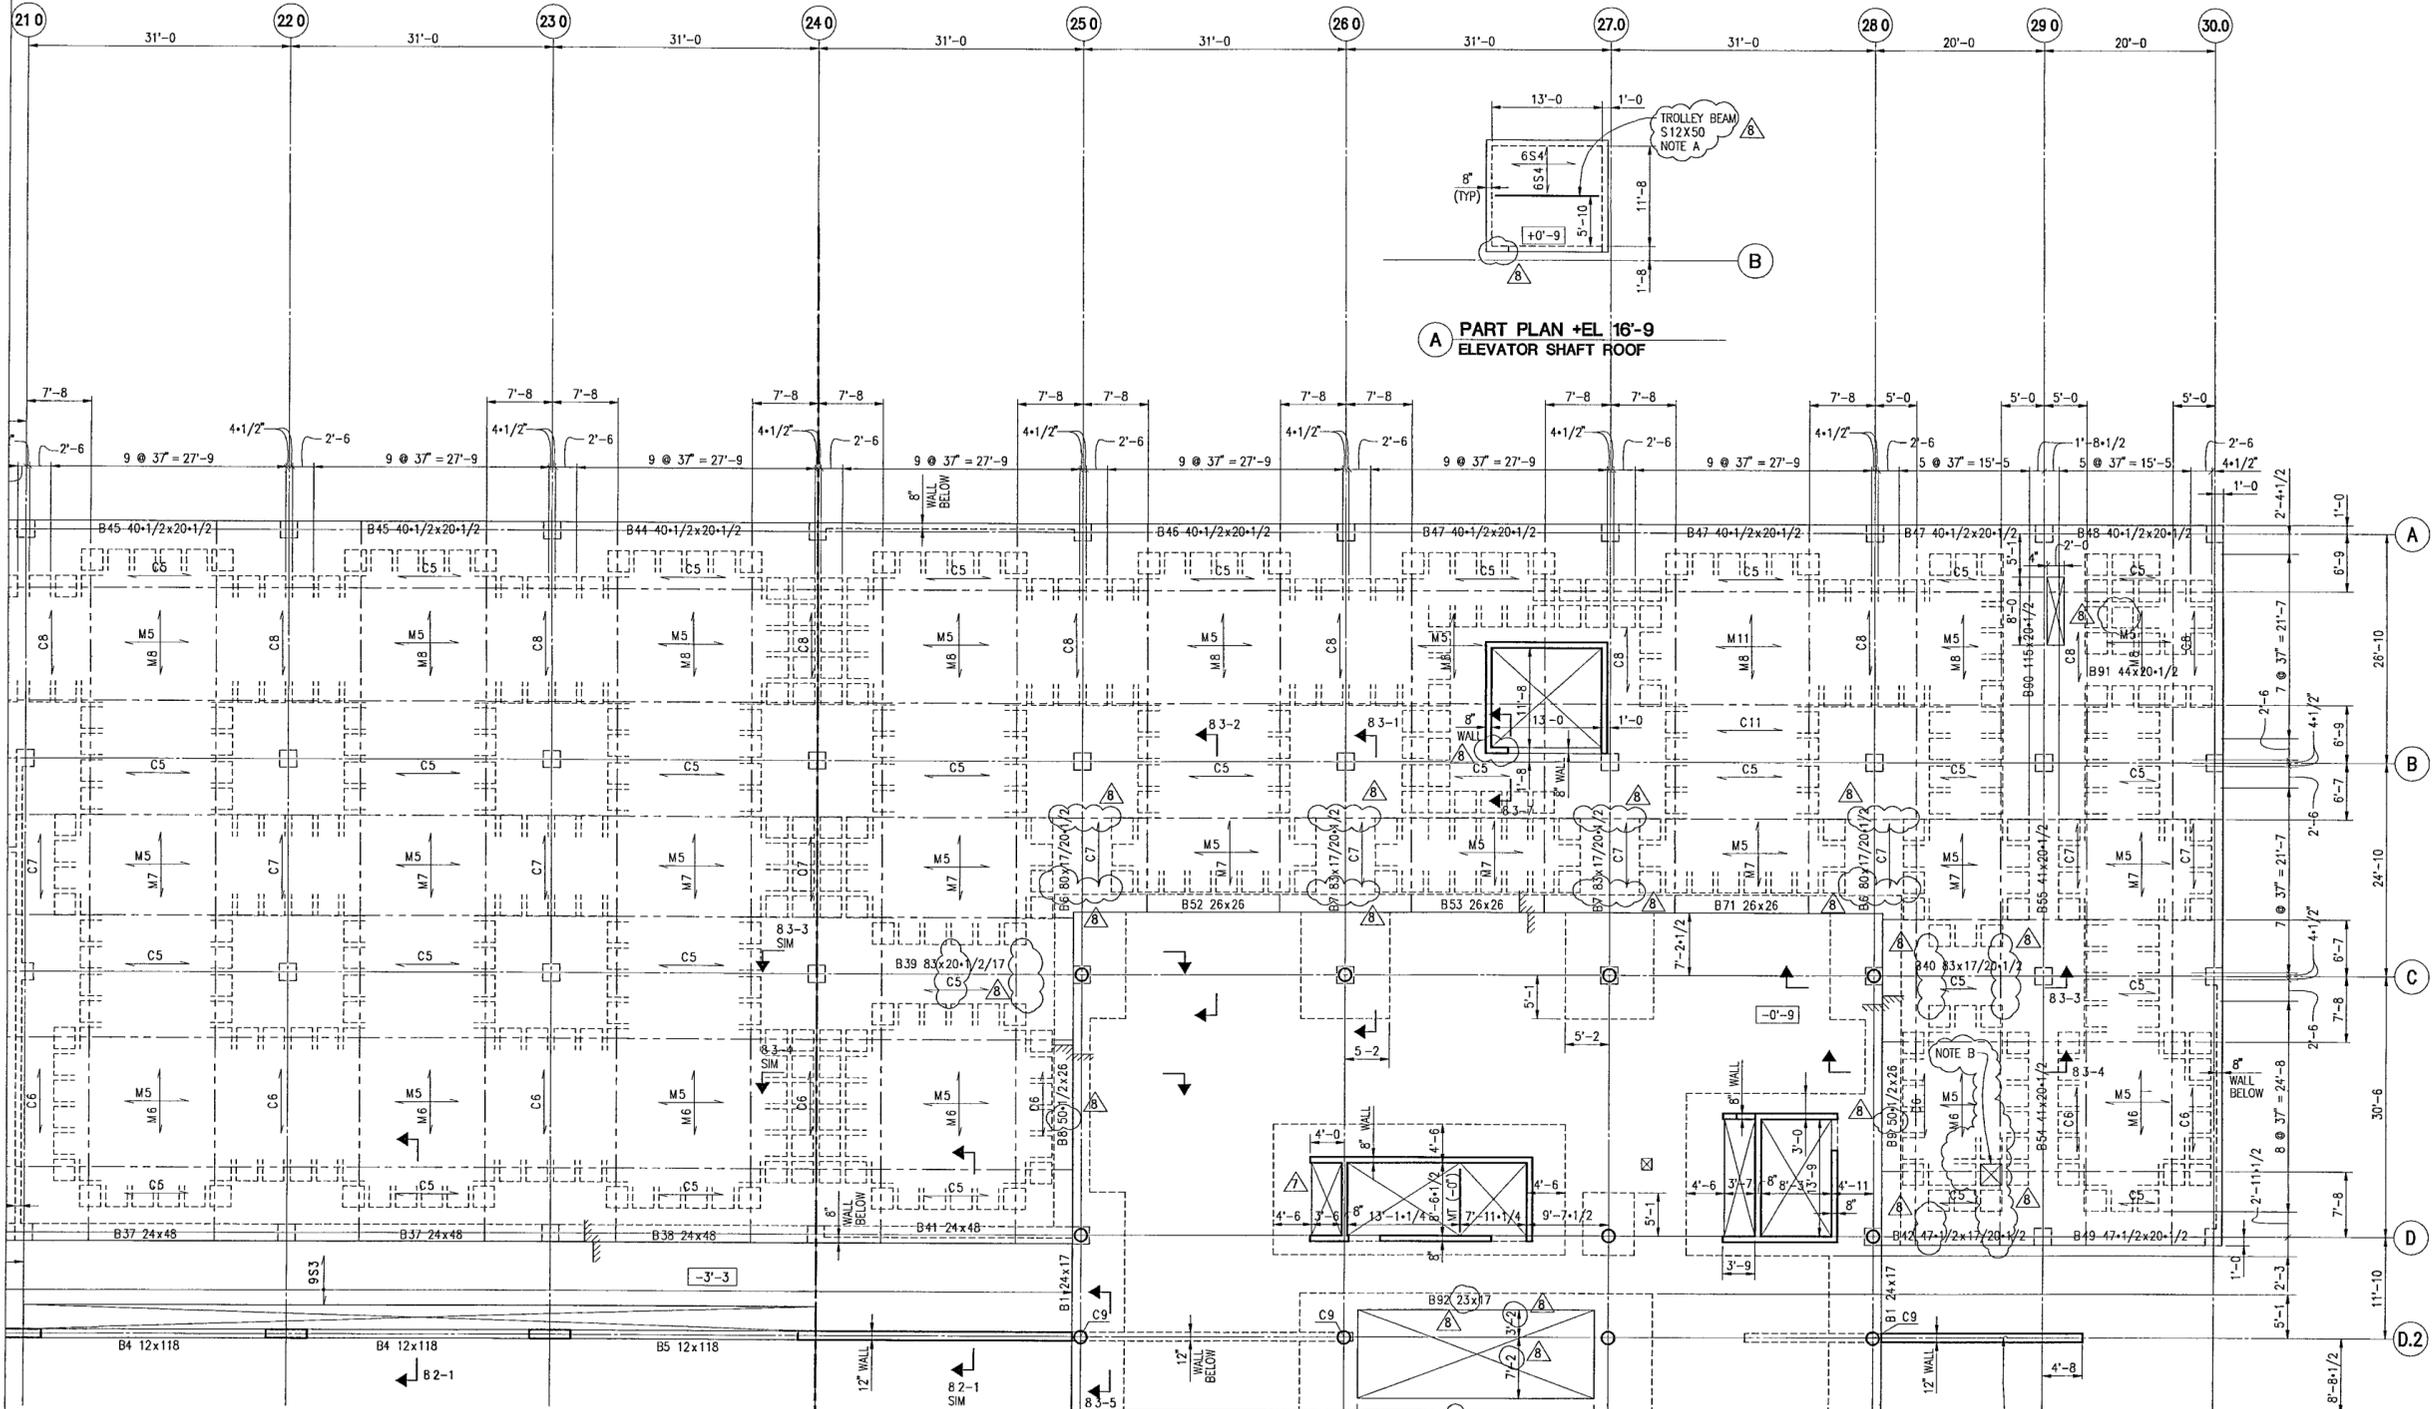

**(A) PART PLAN +EL 16'-9  
ELEVATOR SHAFT ROOF**

**NOTES:**  
1 REFER TO S102C FOR NOTES

**REFERENCED NOTES**

A PAINT BEAM  
LOCATE TOP OF BEAM 2" BELOW SOFFIT OF SLAB

B DETAIL TOP REINFORCEMENT AT OPENING PER TYPICAL DETAIL  
FOR ONE-WAY SLAB OPENING

© Copyright LESLIE E. ROBERTSON ASSOCIATES RLLP  
**WARNING** IT IS A VIOLATION OF LAW FOR ANY PERSON UNLESS ACTING UNDER THE DIRECTION OF A PROFESSIONAL LICENSED IN THE STATE OF THIS PROJECT, TO ALTER IN ANY WAY THESE DRAWINGS WHERE ANY ITEM IS ALTERED THE SUPERVISING PROFESSIONAL SHALL AFFIX TO THE ITEM HIS SEAL AND THE INSCRIPTION "ALTERED BY" FOLLOWED BY HIS SIGNATURE, THE DATE, AND A SPECIFIC DESCRIPTION OF THE ALTERATION