

**WILLIAM J. CLINTON
PRESIDENTIAL
CENTER**

LITTLE ROCK, ARKANSAS

Architect
POLSHEK PARTNERSHIP LLP
320 West 13th Street
New York, New York 10014
212.607.7171

Coordinating Architects
POLK STANLEY YEARY ARCHITECTS LTD
700 South Schiller Street
Little Rock, Arkansas 72201
501.378.0878

WITSELL EVANS RASCO
901 West Third Street
Little Rock, Arkansas 72201
501.374.5300

WOODS CARADINE ARCHITECTS
2200 South Main Street
Little Rock, Arkansas 72206
501.374.4060

Landscape Architects
HARGREAVES ASSOCIATES
118 Magazine Street
Cambridge, Massachusetts 02139
617.661.0070

LANDSCAPE ARCHITECTURE, Inc.
2300 Cottondale Lane Suite 202
Little Rock, Arkansas 72202
501.374.5610

Structural Engineer
LESLIE E. ROBERTSON ASSOC, RLLP
30 Broad Street, 4th Floor
New York, New York 10004
212.750.9000


MEP Engineers
FLACK + KURTZ Inc.
475 Fifth Avenue
New York, New York 10017
212.532.9600

CROWHILL ARCHITECTS ENGINEERS
101 South Spring Street
Little Rock, Arkansas 72201
501.372.2900

Curtainwall Consultant
R. A. HEINTGES ARCHITECTS
126 Fifth Avenue 9th Floor
New York, New York 10011
212.652.2966

Seal

Issue	Date
8	10% CONSTRUCTION DOCS 09/27/02
7	90% PROGRESS PRINTING 08/30/02
6	100% STRUCTURAL CD 07/01/02
5	100% STL & CONC CD 06/15/02
4	BUILDING DEPT 03/18/02
3	BID ISSUE 03/01/02
2	75% DESIGN DEVEL 01/25/02
1	50% DESIGN DEVEL 12/19/01

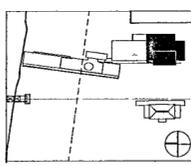


Job No 9908
Scale 1/8"=1'-0"
Date DEC 11, 2001
Title

**SECOND LEVEL
PLAN**

Sheet No.

S102e


FOR OFFICIAL USE ONLY

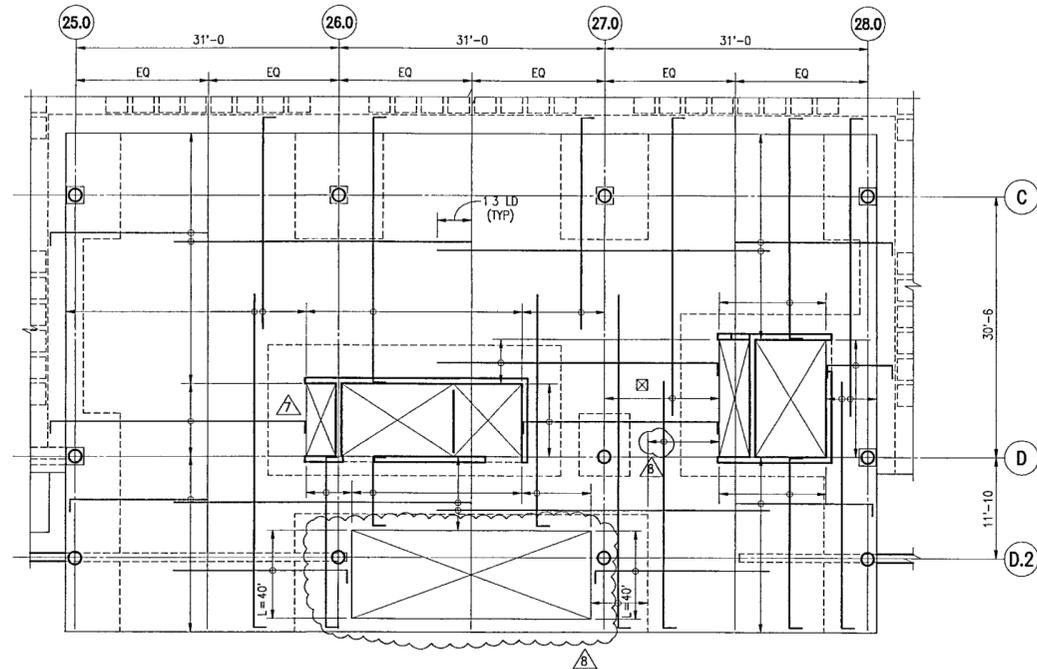

NOTES

- 1 PROVIDE #6@12 EACH WAY PLACE BARS PER LAYOUT SHOWN


B BASIC TOP REINFORCEMENT

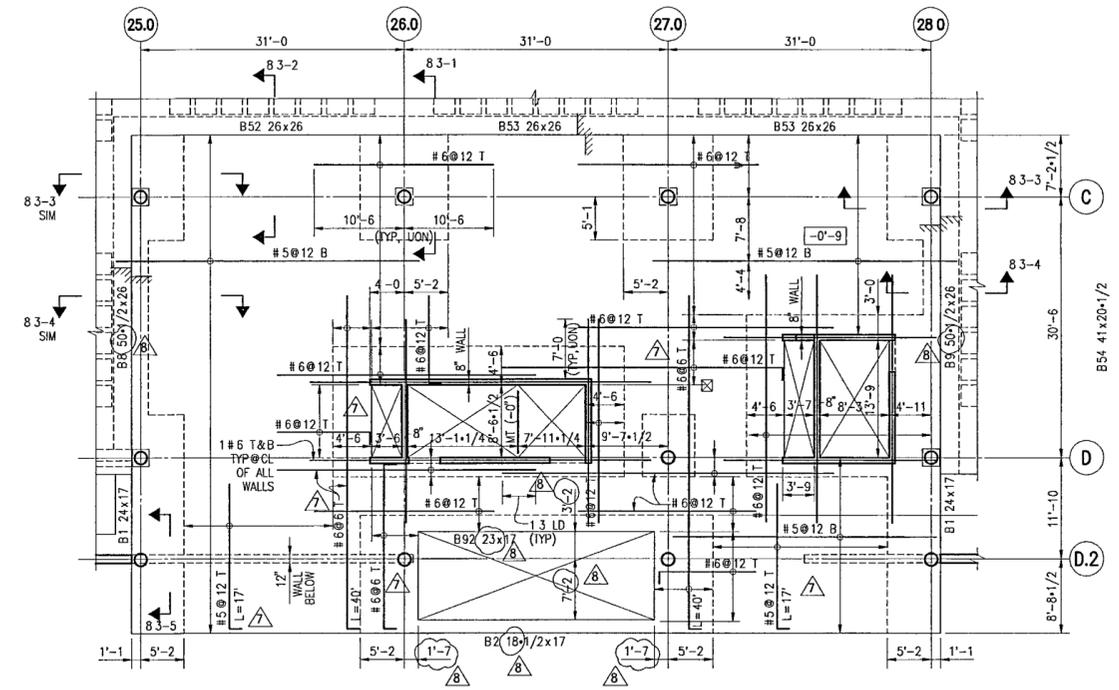

NOTES

- 1 PROVIDE ADDITIONAL TOP AND BOTTOM BARS SHOWN IN PLAN SEE B AND C FOR BASIC TOP AND BOTTOM REINFORCEMENT

A PLAN

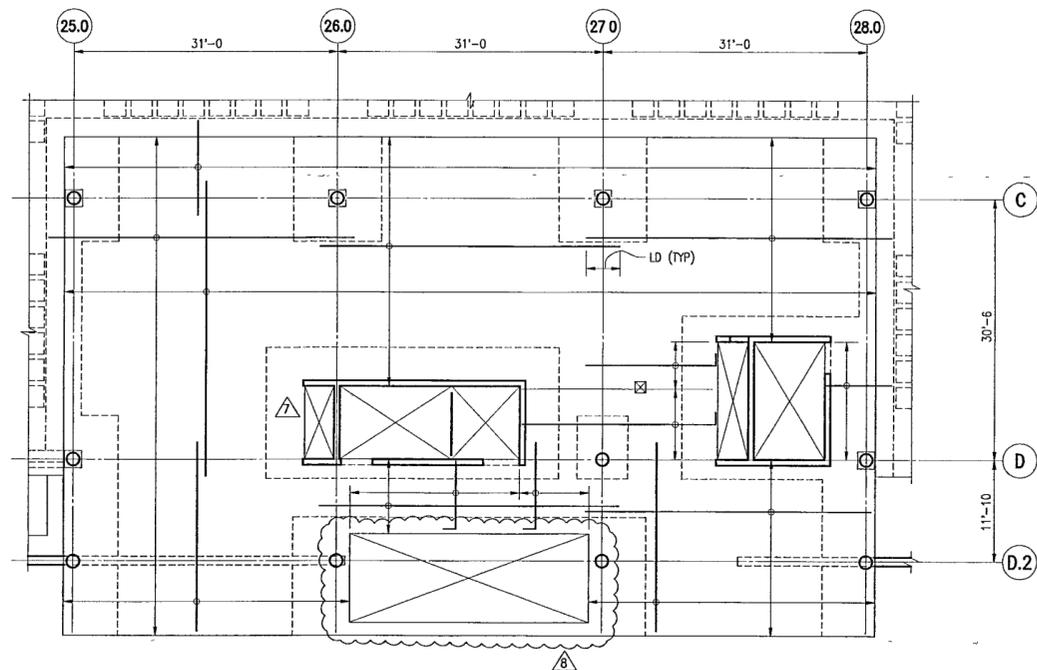

NOTES

- 1 PROVIDE #5@12 EACH WAY PLACE BARS PER LAYOUT SHOWN
- 2 EXTEND ALL BOTTOM BARS TO FAR FACE OF SUPPORT WHERE EXTENSION IS NOT 6" OR MORE, PROVIDE STANDARD HOOKS (EXTENSION NEED NOT EXCEED LDC UNLESS OTHERWISE NOTED)
- 3 AT LEAST TWO OF THE BOTTOM BARS AT SUPPORTS IN EACH DIRECTION SHALL PASS WITHIN THE COLUMN/WALL CORE AND SHALL BE ANCHORED AT EXTERIOR SUPPORTS

C BASIC BOTTOM REINFORCEMENT

NOTES

- 1 FOR NOTES SEE S102c
- 2 FLAT SLAB REINFORCEMENT IS AS SHOWN IN PLANS A, B AND C ABOVE. PROVIDE REINFORCEMENT SHOWN IN PLAN A IN ADDITION TO BASIC REINFORCEMENT SHOWN IN B AND C
- 3 PLACE REINFORCING BARS FOR FLAT SLAB IN THE FOLLOWING SEQUENCE UON

NORTH-SOUTH	BOTTOM BARS
EAST-WEST	BOTTOM BARS
EAST-WEST	TOP BARS
NORTH-SOUTH	TOP BARS

© Copyright LESLIE E. ROBERTSON ASSOCIATES R.L.L.P.
WARNING IT IS A VIOLATION OF LAW FOR ANY PERSON, UNLESS ACTING UNDER THE DIRECTION OF A PROFESSIONAL LICENSED IN THE STATE OF THIS PROJECT TO ALTER IN ANY WAY THESE DRAWINGS WHERE ANY ITEM IS ALTERED THE SUPERVISING PROFESSIONAL SHALL AFFIX TO THE ITEM HIS SEAL AND THE INSCRIPTION ALTERED BY FOLLOWED BY HIS SIGNATURE THE DATE AND A SPECIFIC DESCRIPTION OF THE ALTERATION

217