NOTES·

1 REFER TO THE STRUCTURAL DRAWING BOOK FOR GENERAL NOTES, TYPICAL DETAILS, SCHEDULES AND ALL REFERENCED DETAILS AND SECTIONS REFER TO S110 SERIES DRAWINGS FOR ADDITIONAL SLAB REINFORCEMENT AND S220 SERIES DRAWINGS FOR WALL ELEVATIONS AND REINFORCEMENT REFER TO EDGE OF SLAB DRAWINGS FOR SLAB EDGE LOCATIONS AND DIMENSIONS

2 TOP OF CONCRETE IS 3" BELOW REFERENCE ELEVATION +42'-9•3/4, UNLESS OTHERWISE NOTED XXX, WHERE XXX IS MEASURED WITH RESPECT TO REFERENCE ELEVATION

3 TOP OF STRUCTURAL STEEL IS (-9•1/2") BELOW REFERENCE ELEVATION UNLESS OTHERWISE NOTED

4 FLOOR CONSTRUCTION IS 3•1/2" LIGHTWEIGHT CONCRETE (F'C=3 KSI) OVER 3" COMPOSITE DECK, TYPE D4, UNLESS OTHERWISE NOTED

5 STEEL DECK SPANS THE SHORT SPAN DIRECTION UNLESS NOTED PROVIDE PERMANENT DECK SUPPORTS AT COLUMNS AND WALLS UNLESS OTHERWISE NOTED

6 SOLID CONCRETE SLAB IS INDICATED SL THIS IS A FORMED SLAB, THERE IS NO STEEL DECK

7 CONCRETE STRENGTH AND WEIGHT
SLAB ON DECK F'C = 3000 PSI, LW
WALLS F'C = 4000 PSI, NW
COLUMNS F'C = 4000 PSI, NW

8 STRUCTURAL STEEL SHAPES SHALL BE FY50 UNLESS OTHERWISE NOTED CONNECTION PLATES SHALL BE FY36 U O N
PIPES SHALL BE FY36
TUBES SHALL BE FY46

9 INTERIOR WALLS ARE 12" CONCRETE WALLS UNLESS OTHERWISE NOTED

10 NUMBER OF 3/4"ø x 5•1/2" LONG STUD SHEAR CONNECTORS APPLIED TO THE TOP FLANGE OF BEAM IS NOTED THUS [MIN]

11 SB=ELEVATOR SEPARATOR BEAM, TS6x4x5/16
SC=STAIR HEADER CHANNEL, C12x20 7 FY36
MB=MINIMUM BEAM, W12x22 [MIN]
LA=L 3x3x5/16 DECK SUPPORT ANGLE
LB=L 8x8x1/2

12 INDICATES MOMENT CONNECTION

13 CAMBER IN INCHES IS GIVEN THUS, C

14 Ψ INDICATES INFORMATION TO BE PROVIDED BY ARCHITECT

REFERENCED NOTES

A. SEE 7 2-18 FOR ADDITIONAL STEEL FRAMING IN CONCRETE CORES

B PROVIDE ELEVATOR RAIL SUPPORT SEE 7 1-32 FOR ELEVATION

C FOR STAIR DIMENSIONS, REFER TO ARCHITECTURAL DRAWINGS

D EXPOSED STEEL IS ARCHITECTURALLY EXPOSED STRUCTURAL STEEL (AESS)

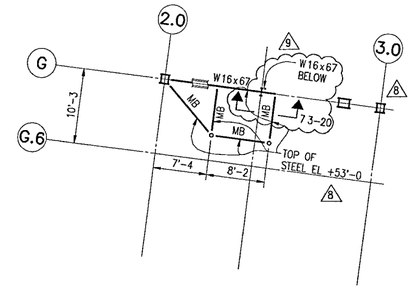

A PART PLAN
ELEVATOR SHAFTWAY ROOF

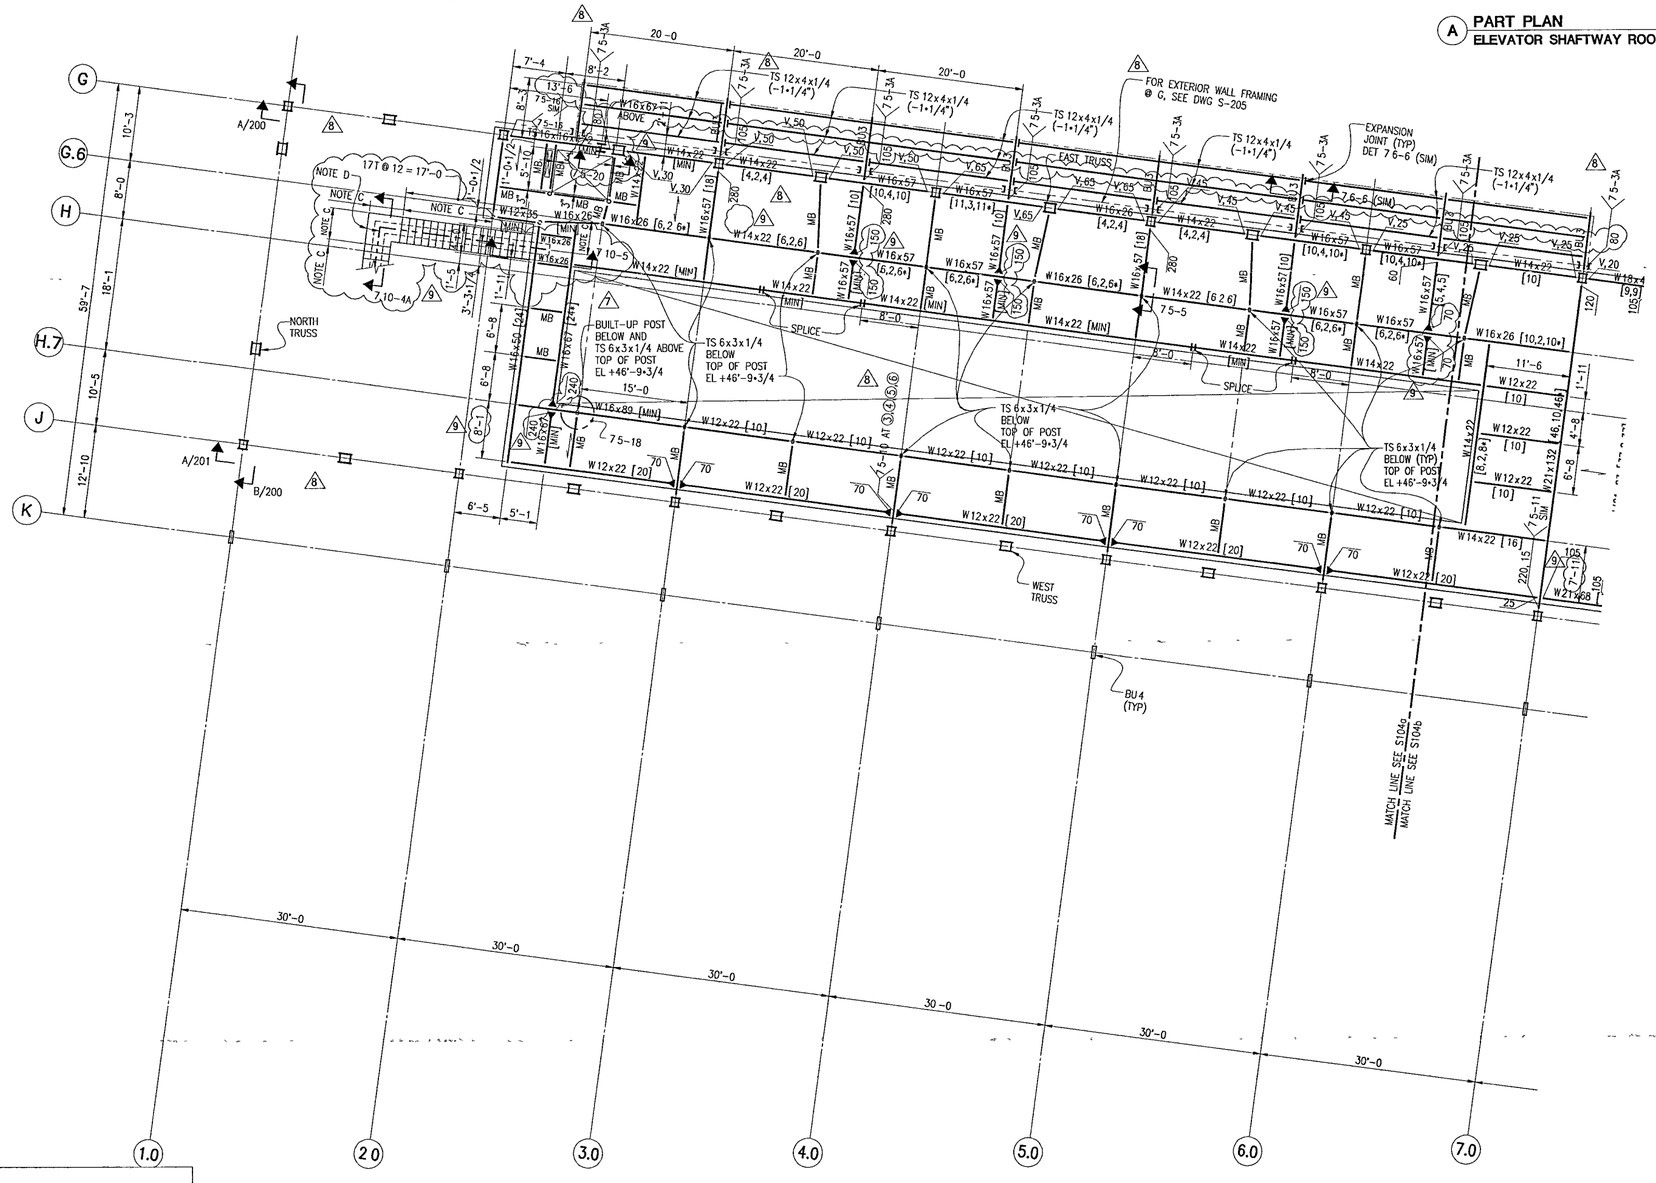

© Copyright LESLIE E ROBERTSON ASSOCIATES, R L L P

WARNING IT IS A VIOLATION OF LAW FOR ANY PERSON, UNLESS ACTING UNDER THE DIRECTION OF A PROFESSIONAL LICENSED IN THE STATE OF THIS PROJECT TO ALTER IN ANY WAY THESE DRAWINGS WHERE ANY ITEM IS ALTERED, THE SUPERVISING PROFESSIONAL SHALL AFFIX TO THE ITEM HIS SEAL AND THE INSCRIPTION "ALTERED BY" FOLLOWED BY HIS SIGNATURE THE DATE AND A SPECIFIC DESCRIPTION OF THE ALTERATION

SAVE. Sep 27 2002 3 50pm PRINT Sep 27, 2002 4 40pm

WILLIAM J. CLINTON PRESIDENTIAL CENTER

LITTLE ROCK, ARKANSAS

Architect
POLSHEK PARTNERSHIP LLP
320 West 13th Street
New York, New York 10014
212.807 7171

Coordinating Architects
POLK STANLEY YEARY ARCHITECTS Ltd
700 South Schaller Street
Little Rock, Arkansas 72201
501 378 0878

WITSELL EVANS RASCO
901 West Third Street
Little Rock, Arkansas 72201
501.374 5300

WOODS CARADINE ARCHITECTS
2200 South Main Street
Little Rock, Arkansas 72206
501.374 4060

Landscape Architects
HARGREAVES ASSOCIATES
118 Magazine Street
Cambridge, Massachusetts 02139
617 661 0070

LANDSCAPE ARCHITECTURE, Inc.
2300 Cottondale Lane Suite 202
Little Rock, Arkansas 72202
501 374 5610

Structural Engineer
LESLIE E. ROBERTSON ASSOC , RLLP
30 Broad Street, 47th Floor
New York, New York 10004
212.750 9000

MEP Engineers
FLACK + KURTZ Inc
475 Fifth Avenue
New York, New York 10017
212 532.9600

CROMWELL ARCHITECTS ENGINEERS
101 South Spring Street
Little Rock, Arkansas 72201
501.372.2900

Curtainwall Consultant
R. A. HEINTGES ARCHITECTS
126 Fifth Avenue 9th Floor
New York, New York 10011
212.652-2966

Seal

Issue		Date
9	100% CONSTRUCTION DOCS	09/27/02
8	90% PROGRESS PRINTING	08/30/02
7	SFS-3	07/19/02
6	100% STRUCTURAL CD	07/01/02
5	100% STL & CONC CD	05/15/02
4	BUILDING DEPT	03/18/02
3	BID ISSUE	03/01/02
2	75% DESIGN DEVEL.	01/25/02
1	50% DESIGN DEVEL.	12/19/01

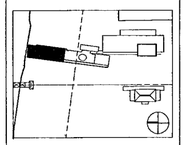

Job No 9908

Scale 1/8"=1'-0

Date DEC 11, 2001

Title
MUSEUM UPPER LEVEL PLAN

Sheet No
S104a

FOR OFFICIAL USE ONLY