

**WILLIAM J. CLINTON
PRESIDENTIAL
CENTER**

LITTLE ROCK, ARKANSAS

Architect
POLSHAK PARTNERSHIP LLP
320 West 13th Street
New York, New York 10014
212.607.7171

Coordinating Architects
POLK STANLEY YEARY ARCHITECTS LTD
700 South Schiller Street
Little Rock, Arkansas 72201
501.378.0878

WITSELL EVANS RASCO
901 West Third Street
Little Rock, Arkansas 72201
501.374.5300

WOODS CARADINE ARCHITECTS
2200 South Main Street
Little Rock, Arkansas 72206
501.374.4060

Landscape Architects
HARGREAVES ASSOCIATES
118 Magazine Street
Cambridge, Massachusetts 02139
617.661.0070

LANDSCAPE ARCHITECTURE, Inc.
2300 Cottontail Lane Suite 202
Little Rock, Arkansas 72202
501.374.5610

Structural Engineer
LESLIE E. ROBERTSON ASSOC, RLLP
30 Broad Street, 4th Floor
New York, New York 10004
212.750.9000

MEP Engineers
FLACK + KURTZ Inc.
475 Fifth Avenue
New York, New York 10017
212.532.9600


CROWMELL ARCHITECTS ENGINEERS
101 South Spring Street
Little Rock, Arkansas 72201
501.372.2900

Curtainwall Consultant
R.A. HEINTGES ARCHITECTS
126 Fifth Avenue 9th Floor
New York, New York 10011
212.652.2966

Seal


| | | |
|---|------------------------|----------|
| 9 | 100% CONSTRUCTION DOCS | 09/22/02 |
| 8 | SFS-15 | 09/18/02 |
| 7 | 90% PROGRESS PRINTING | 08/30/02 |
| 6 | 100% STRUCTURAL CD | 07/01/02 |
| 5 | 100% STL & CONC CD | 05/15/02 |
| 4 | BUILDING DEPT | 03/18/02 |
| 3 | BID ISSUE | 03/01/02 |
| 2 | 75% DESIGN DEVEL. | 01/25/02 |
| 1 | 50% DESIGN DEVEL. | 12/19/01 |

| | |
|---------|--------------|
| Job No. | 9908 |
| Scale | 1/8"=1'-0" |
| Date | DEC 11, 2001 |
| Title | |

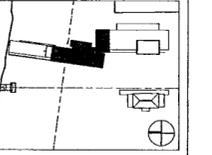

EXECUTIVE
LEVEL PLAN

Sheet No
S105b

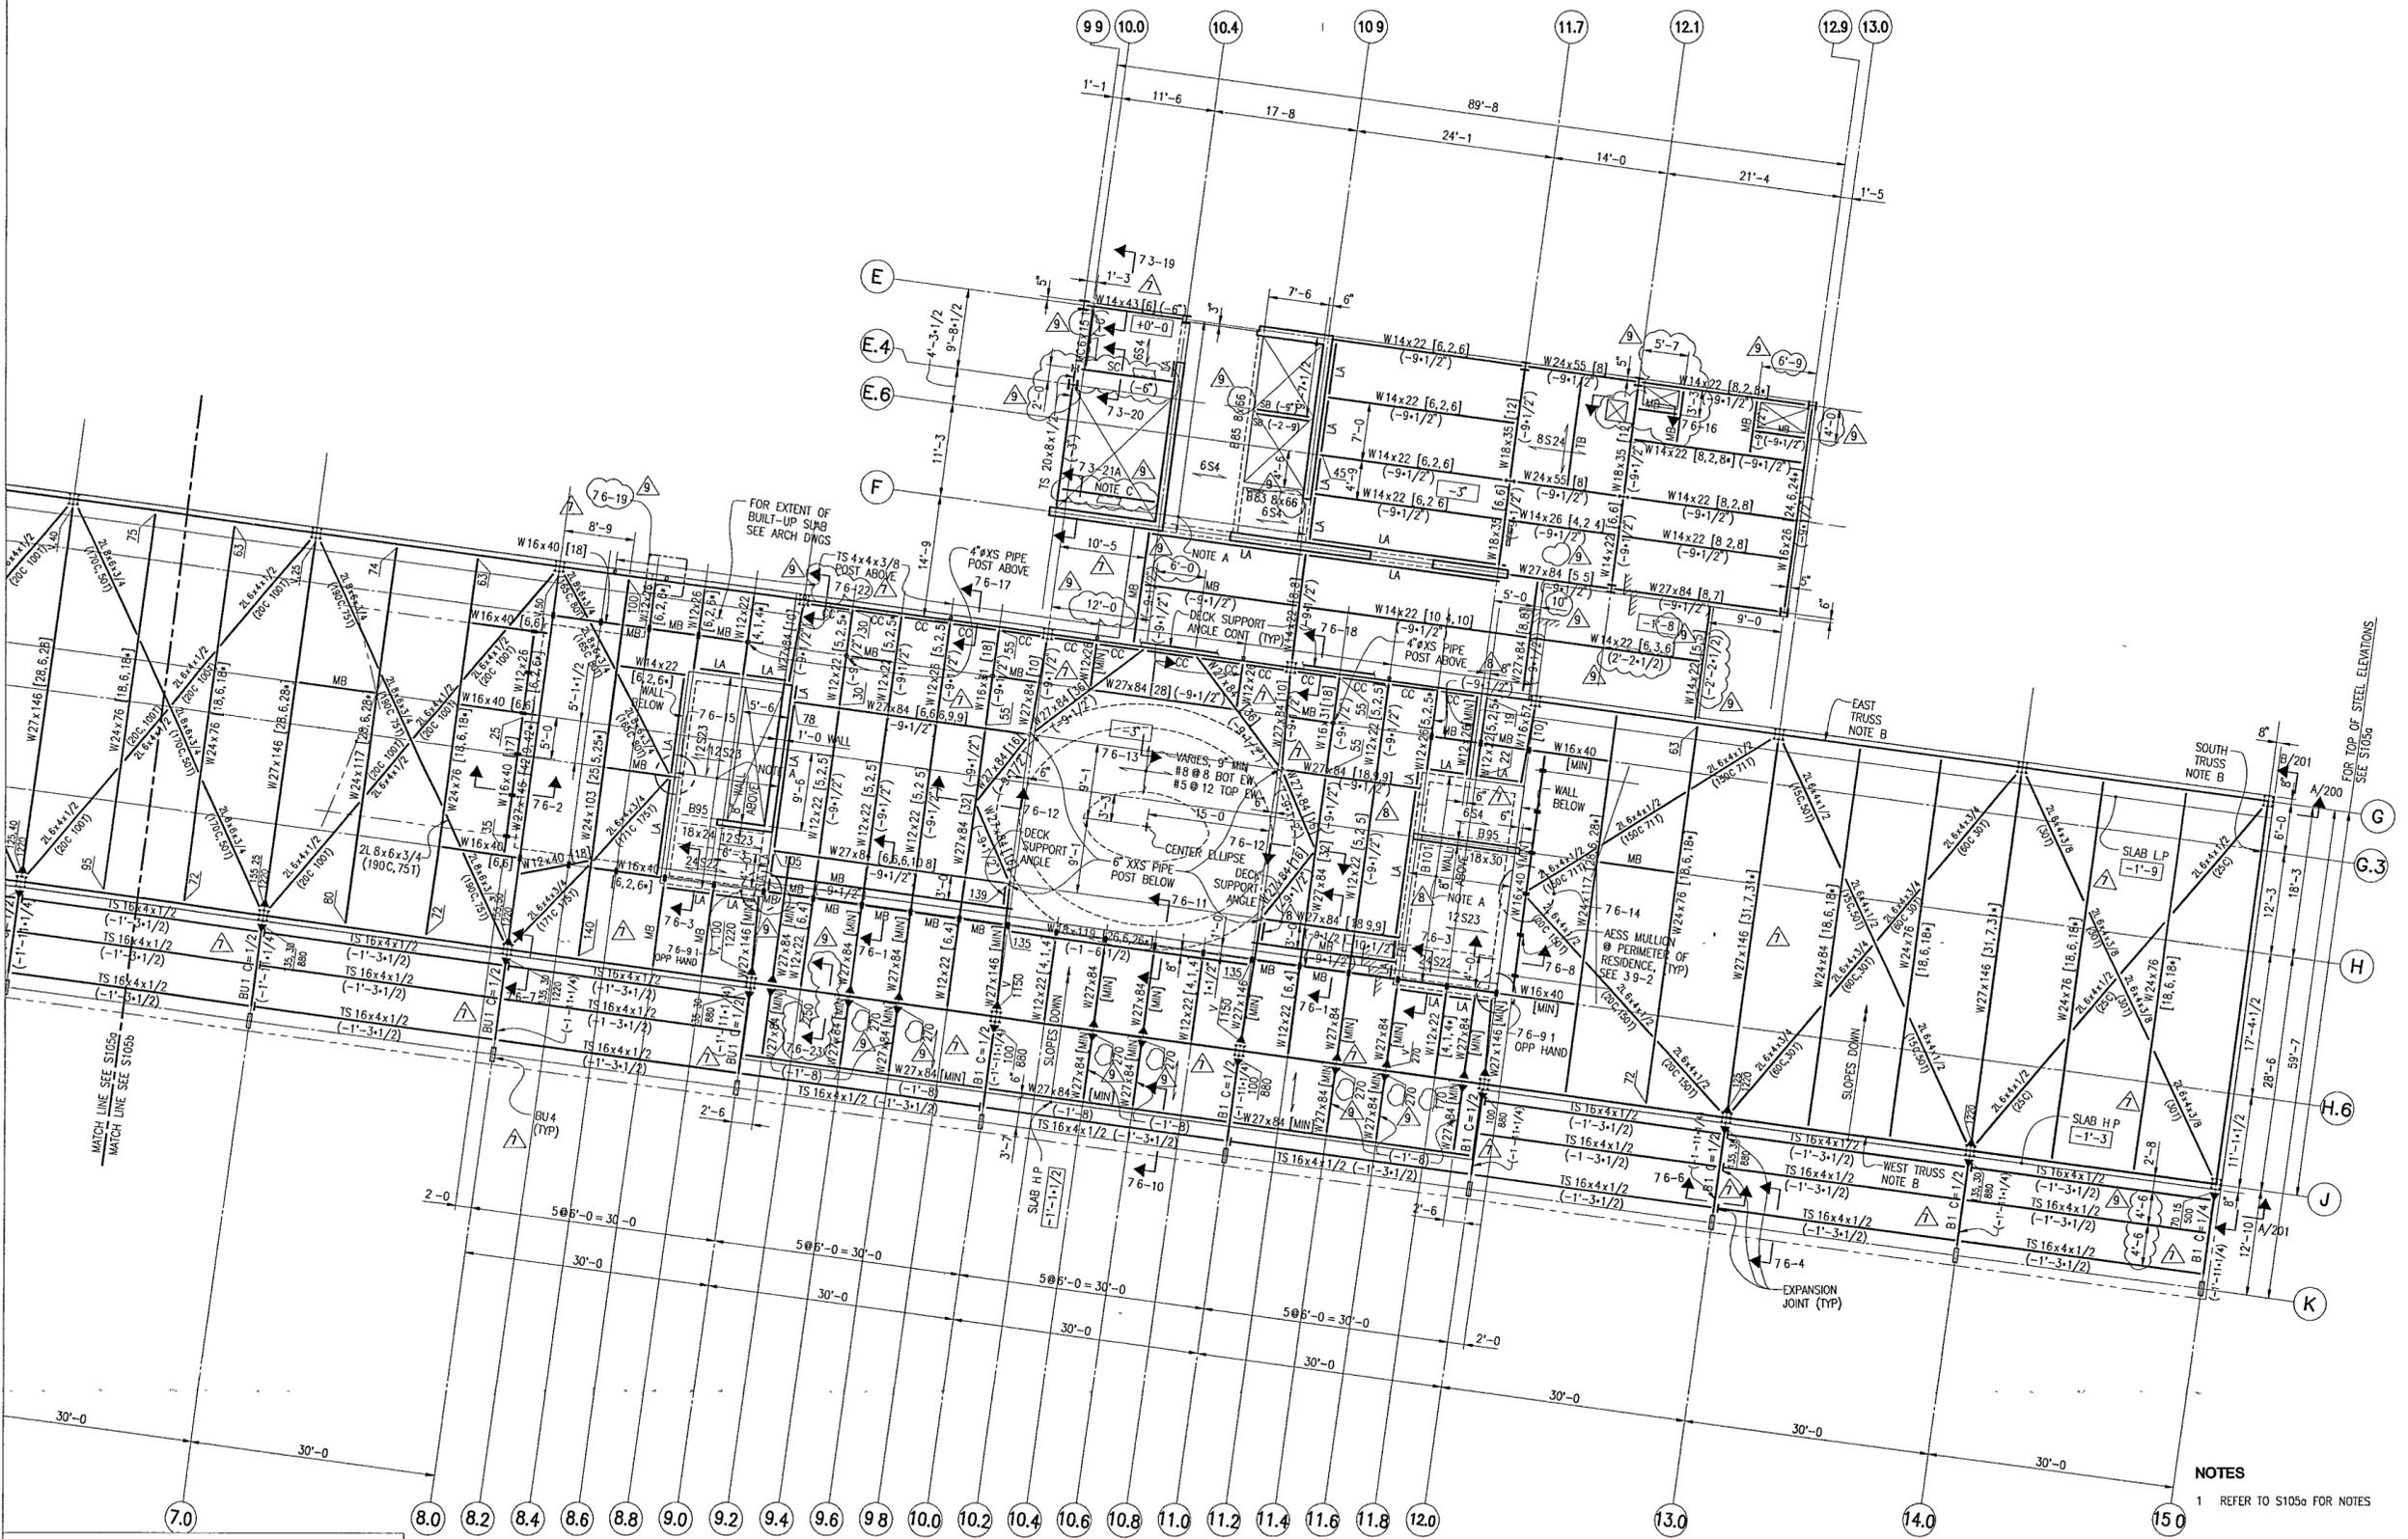

NOTES
1 REFER TO S105a FOR NOTES

© Copyright LESLIE E. ROBERTSON ASSOCIATES, RLLP
WARNING IT IS A VIOLATION OF LAW FOR ANY PERSON, UNLESS ACTING UNDER THE DIRECTION OF A PROFESSIONAL LICENSED UNDER THE STATE OF THIS PROJECT, TO ALTER IN ANY WAY THESE DRAWINGS WHERE ANY ITEM IS ALTERED THE SUPERVISING PROFESSIONAL SHALL AFFIX TO THE ITEM HIS SEAL AND THE INSCRIPTION "ALTERED BY" FOLLOWED BY HIS SIGNATURE, THE DATE AND A SPECIFIC DESCRIPTION OF THE ALTERATION

FOR OFFICIAL USE ONLY