

**WILLIAM J CLINTON  
PRESIDENTIAL  
CENTER**

LITTLE ROCK, ARKANSAS

Architect  
POLSHKE PARTNERSHIP LLP  
320 West 13th Street  
New York, New York 10014  
212.507.7171

Coordinating Architects  
POLK STANLEY YEARY ARCHITECTS Ltd  
700 South Schiller Street  
Little Rock, Arkansas 72201  
501.378.0878

WITSELL EVANS RASCO  
901 West Third Street  
Little Rock, Arkansas 72201  
501.374.6300

WOODS GARADINE ARCHITECTS  
2300 South Main Street  
Little Rock, Arkansas 72206  
501.374.4060

Landscape Architects  
HARGREAVES ASSOCIATES  
118 Magazine Street  
Cambridge, Massachusetts 02139  
617.661.0070

LANDSCAPE ARCHITECTURE, Inc.  
2300 Cottondale Lane Suite 202  
Little Rock, Arkansas 72202  
501.374.5610

Structural Engineer  
LESLIE E. ROBERTSON ASSOC., RLLP  
30 Broad Street, 47th Floor  
New York, New York 10004  
212.750.9000


MEP Engineers  
FLACK + KURTZ Inc.  
475 Fifth Avenue  
New York, New York 10017  
212.532.9600

CRUMWELL ARCHITECTS ENGINEERS  
101 South Spring Street  
Little Rock, Arkansas 72201  
501.372.2900

Curtainwall Consultant  
R. A. HENTGES ARCHITECTS  
126 Fifth Avenue 9th Floor  
New York, New York 10011  
212.652.2966

Seal

Issue	Date
3	100% CONSTRUCTION DOCS 09/27/02
2	90% PROGRESS PRINTING 08/30/02
1	100% STRUCTURAL CD 07/01/02

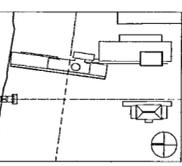

Job No. 9908

Scale 1/8"=1'-0"

Date JUN 15, 2002

Title


EXECUTIVE  
ROOF CANOPY

Sheet No.

**S106d**

**NOTES**


- REFER TO THE STRUCTURAL DRAWING BOOK FOR GENERAL NOTES, TYPICAL DETAILS, SCHEDULES AND ALL REFERENCED DETAILS AND SECTIONS
- MEMBERS SHOWN IN THIS DRAWING ARE ARCHITECTURALLY EXPOSED STEEL, UON
- MEMBERS SHOWN IN THIS DRAWING ARE FY50 STEEL THERMAL SPRAYED FOR CORROSION PROTECTION AND PAINTED PER ARCHITECTURAL REQUIREMENTS, UNLESS OTHERWISE NOTED

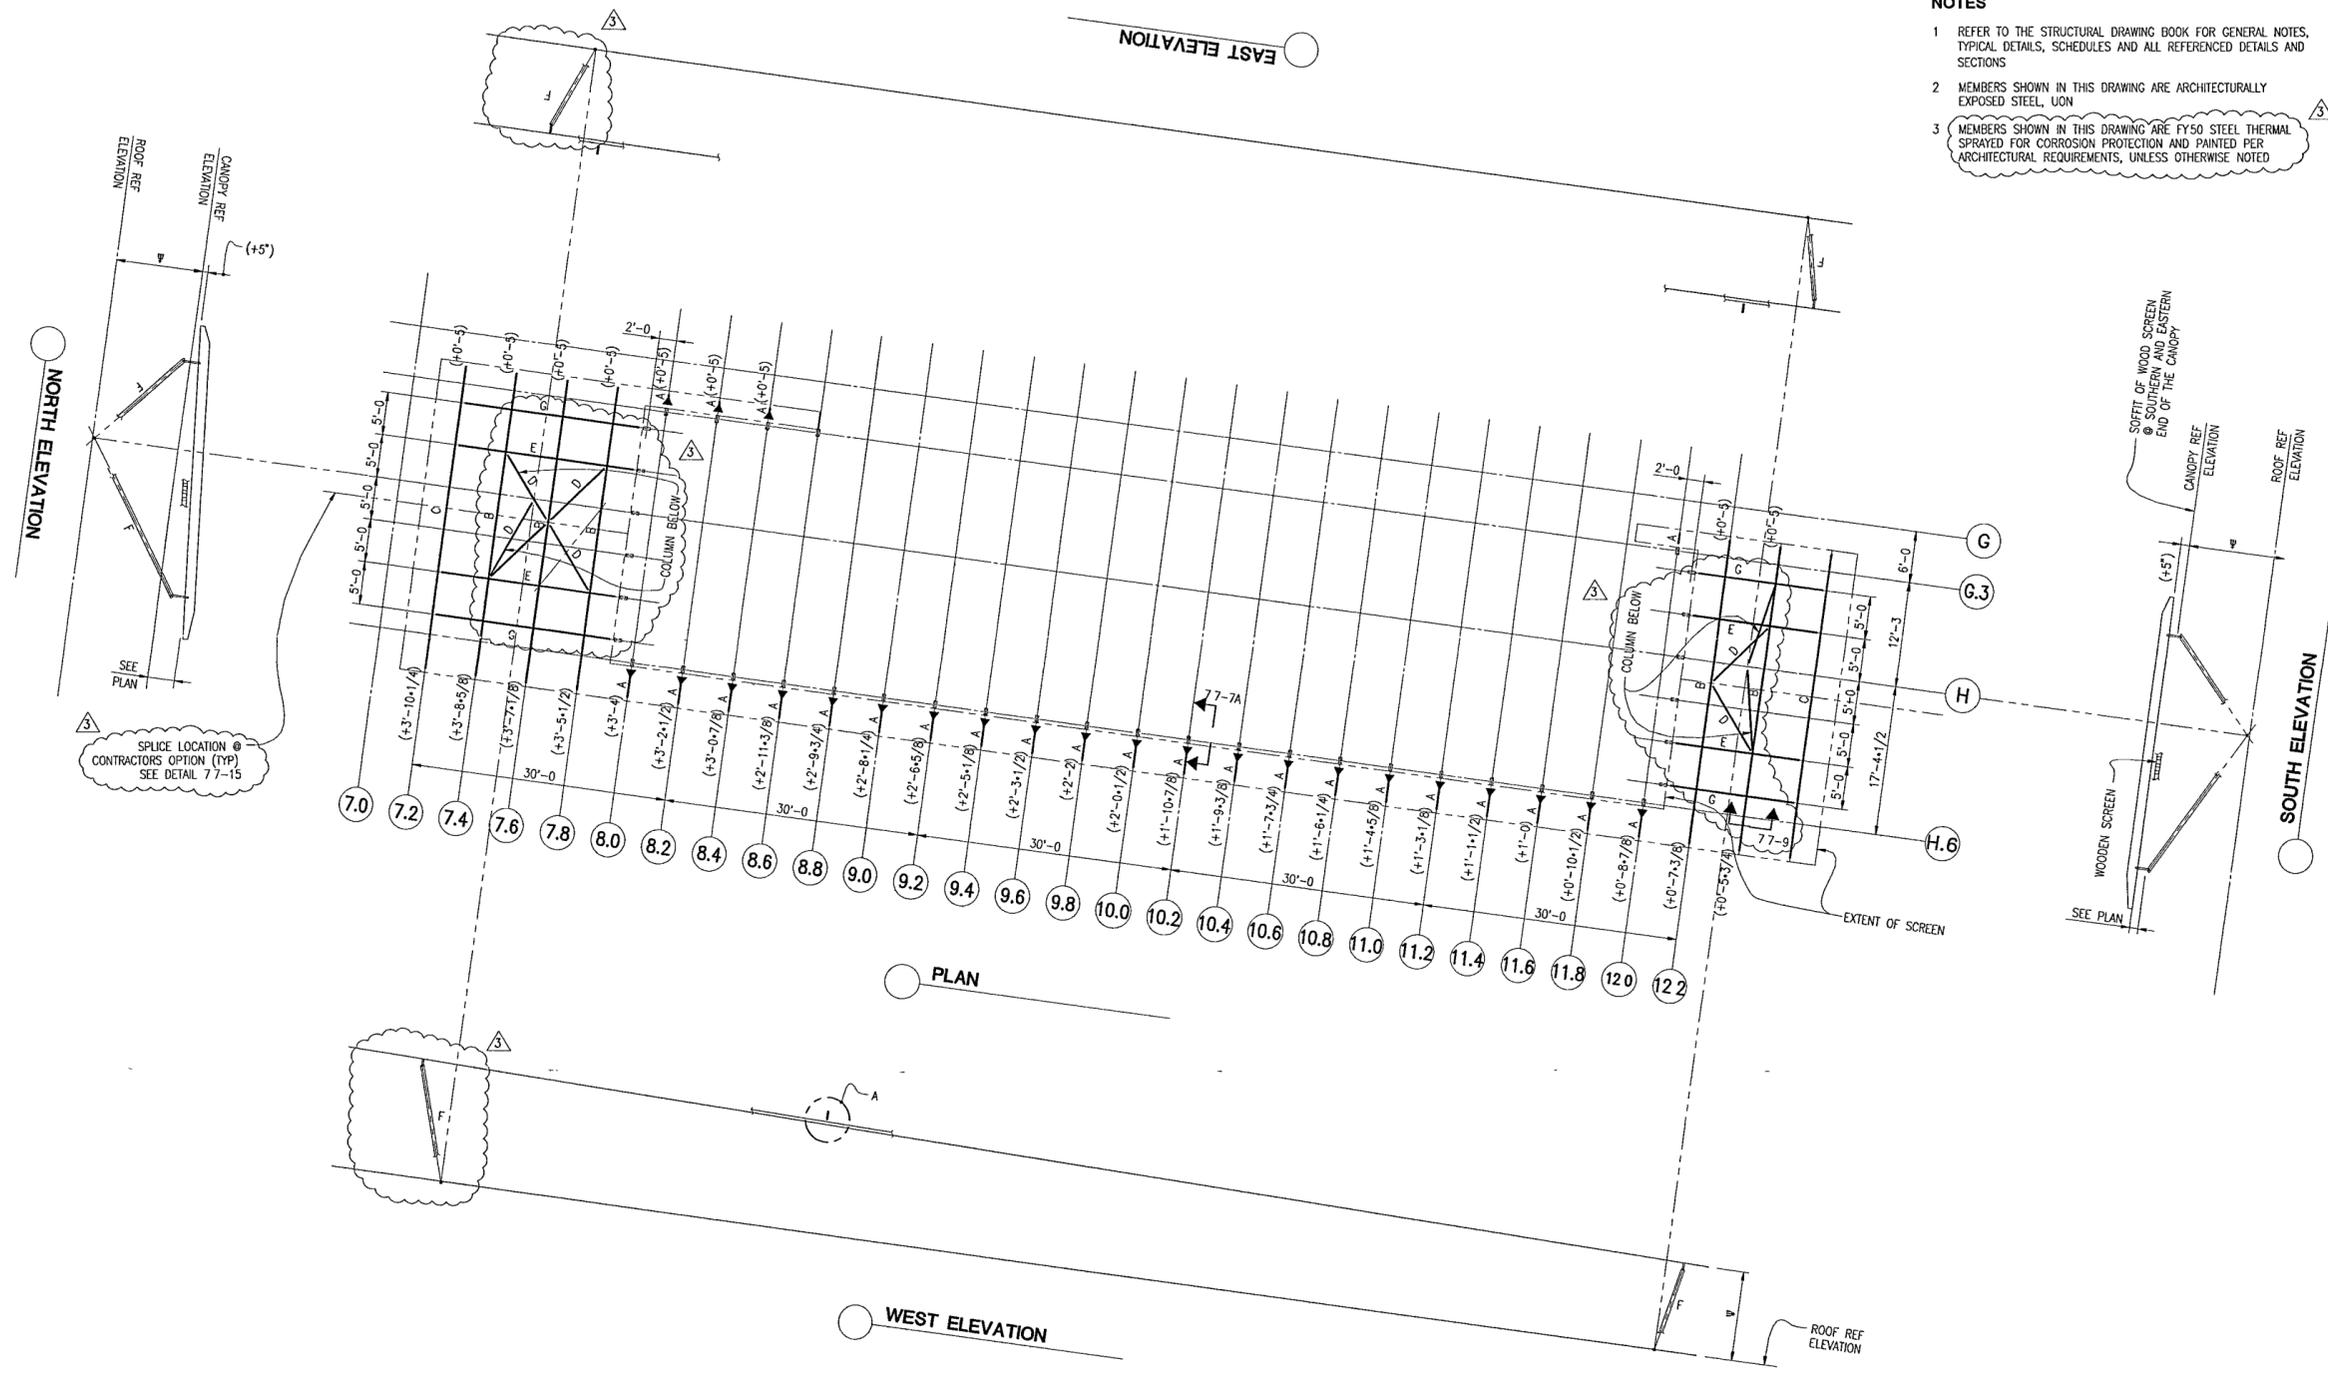

SPLICE LOCATION @ CONTRACTOR'S OPTION (TYP) SEE DETAIL 77-15

**KEY:**

- MEMBER SIZES ARE AS FOLLOWS
- A = PL 1, TAPERED - SEE DETAIL
  - B = PL 1x12, W/ TAPERED ENDS - SEE DETAIL
  - C = PL 2x12, W/ TAPERED ENDS - SEE DETAIL
  - D = 1" DIAMETER SOLID BAR - STAINLESS STEEL
  - E = PL 1-1/2x9, SLOTTED THROUGH TYPE B MEMBERS
  - F = INCLINED COLUMNS, BUILT-UP FROM STAINLESS STEEL PLATE
  - G = 2x9, SLOTTED THROUGH TYPE B AND TYPE C MEMBERS

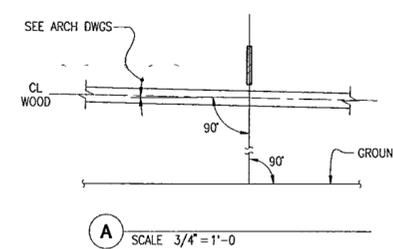

© Copyright LESLIE E. ROBERTSON ASSOCIATES, RLLP  
**WARNING** IT IS A VIOLATION OF LAW FOR ANY PERSON, UNLESS ACTING UNDER THE DIRECTION OF A PROFESSIONAL, LICENSED IN THE STATE OF THIS PROJECT, TO ALTER IN ANY WAY THESE DRAWINGS WHERE ANY ITEM IS ALTERED. THE SUPERVISING PROFESSIONAL SHALL AFFIX TO THE ITEM HIS SEAL AND THE INSCRIPTION "ALTERED BY" FOLLOWED BY HIS SIGNATURE, THE DATE, AND A SPECIFIC DESCRIPTION OF THE ALTERATION.

FOR OFFICIAL USE ONLY