

**WILLIAM J CLINTON
PRESIDENTIAL
CENTER**

LITTLE ROCK, ARKANSAS

Architect
POLSHEK PARTNERSHIP LLP
320 West 13th Street
New York, New York 10014
212.807.7171

Coordinating Architects
POLK STANLEY YEARY ARCHITECTS Ltd
700 South Schuler Street
Little Rock, Arkansas 72201
501.378.6878

WITSELL EVANS RASCO
901 West Third Street
Little Rock, Arkansas 72201
501.374.5300

WOODS CARADINE ARCHITECTS
2200 South Main Street
Little Rock, Arkansas 72206
501.374.4060

Landscape Architects
HARGREAVES ASSOCIATES
118 Magazine Street
Cambridge, Massachusetts 02139
617.661.0070

LANDSCAPE ARCHITECTURE, Inc.
2300 Cottondale Lane Suite 202
Little Rock, Arkansas 72202
501.374.5810

Structural Engineer
LESLIE E. ROBERTSON ASSOC., RLLP
30 Broad Street, 47th Floor
New York, New York 10004
212.750.9000

MEP Engineers
FLACK + KURTZ Inc.
475 Fifth Avenue
New York, New York 10017
212.532.9600


CROMWELL ARCHITECTS ENGINEERS
101 South Spring Street
Little Rock, Arkansas 72201
501.372.2300

Curtainwall Consultant
R. A. HEINTGES ARCHITECTS
128 Fifth Avenue, 9th Floor
New York, New York 10011
212.652.2966

Seal



100% Construction Documents	06/27/02
90% Progress Printing	06/30/02
ASI #05 (Issued as Sk-183)	06/20/02
100% Struct./ CD Progress	07/01/02
Bridge Bldg Substructure	06/14/02
100% Steel & Concrete CD	05/15/02
& Architectural CD Progress	
Issue	Date
*Issued originally as A700a	

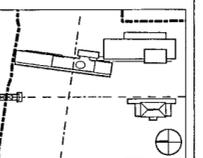

Job No. 9908

Scale 1/8" = 1'-0"


Date September 27, 2002

Title

**BASEMENT LEVEL
PARTIAL SLAB PLAN**

Sheet No.

S100a.1

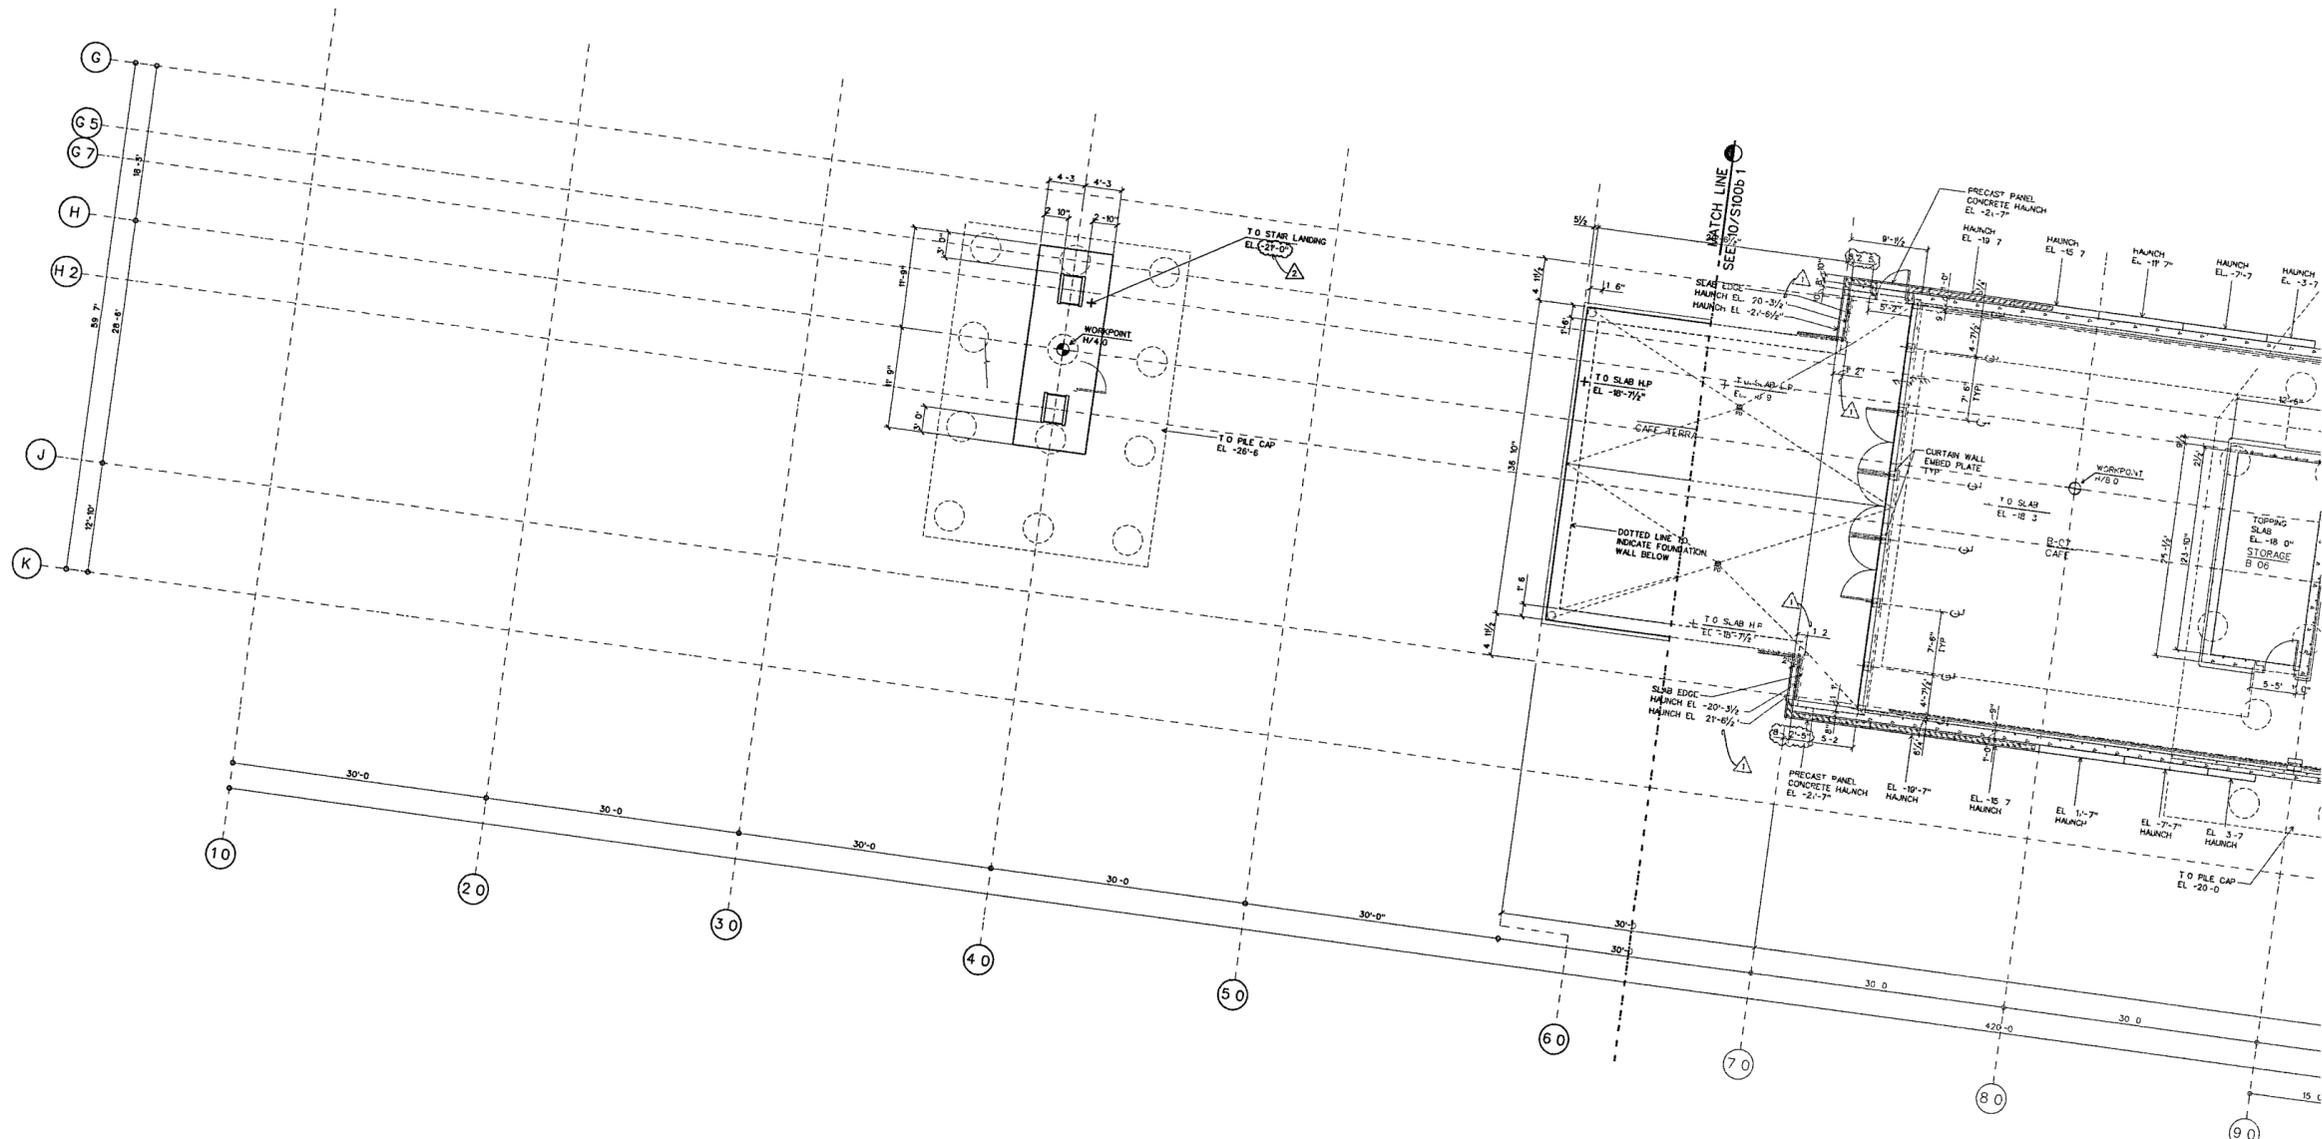

WORKPOINT	NORTHING (Y)	EASTING (X)
H/4 0	150,627.127270	1,234,743.833746
H/8 0	150,508.948833	1,234,723.007298
H/12 0	150,390.770381	1,234,702.182841
C/20 0	150,301.414924	1,234,756.87845
C/25 0	150,149.032475	1,234,750.845291
C/30 0	150,076.134955	1,234,745.836439

BASEMENT LEVEL SLAB PLAN A

SCALE 1/8" = 1'-0"

SLAB-00B DGN 10