

**WILLIAM J CLINTON  
PRESIDENTIAL  
CENTER**

LITTLE ROCK, ARKANSAS

Architect  
POLSHEK PARTNERSHIP LLP  
320 West 15th Street  
New York, New York 10014  
212 807 7171

Coordinating Architects  
POLK STANLEY YEARY ARCHITECTS Ltd  
700 South Schiller Street  
Little Rock, Arkansas 72201  
501 378 0878

WITSELL EVANS RASCO  
901 West Third Street  
Little Rock, Arkansas 72201  
501 374 5300

WOODS CARADINE ARCHITECTS  
2200 South Main Street  
Little Rock, Arkansas 72206  
501 374 4060

Landscape Architects  
HARGREAVES ASSOCIATES  
118 Magazine Street  
Cambridge, Massachusetts 02139  
617 561 0070


LANDSCAPE ARCHITECTURE Inc  
2300 Cottondale Lane Suite 202  
Little Rock, Arkansas 72202  
501 374 5610

Structural Engineer  
LESLIE E. ROBERTSON ASSOC RLLP  
30 Broad Street, 47th Floor  
New York, New York 10004  
212 750 9000


MEP Engineers  
FLACK + KURTZ Inc.  
475 Fifth Avenue  
New York, New York 10017  
212 532 9600

CROMWELL ARCHITECTS ENGINEERS  
101 South Spring Street  
Little Rock, Arkansas 72201  
501 372 2900

Curtainwall Consultant  
R. A. HEINTGES ARCHITECTS  
126 Fifth Avenue, 9th Floor  
New York, New York 10011  
212 652 2965

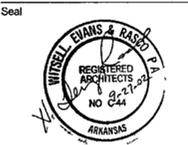


Issue	Date
100% Construction Documents	09/27/02
90% Progress Printing	08/30/02
100% Struct ICD Progress	07/01/02
Bridge Bldg Substructure	06/14/02
100% Steel & Concrete CD & Architectural CD Progress	05/15/02
100% Design Development	03/01/02

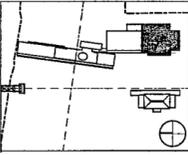

Job No 9908  
Scale 1/8" = 1'-0"  
Date September 27 2002  
Title

**BASEMENT LEVEL  
PARTIAL SLAB PLAN**

Sheet No  
**S100d.1**

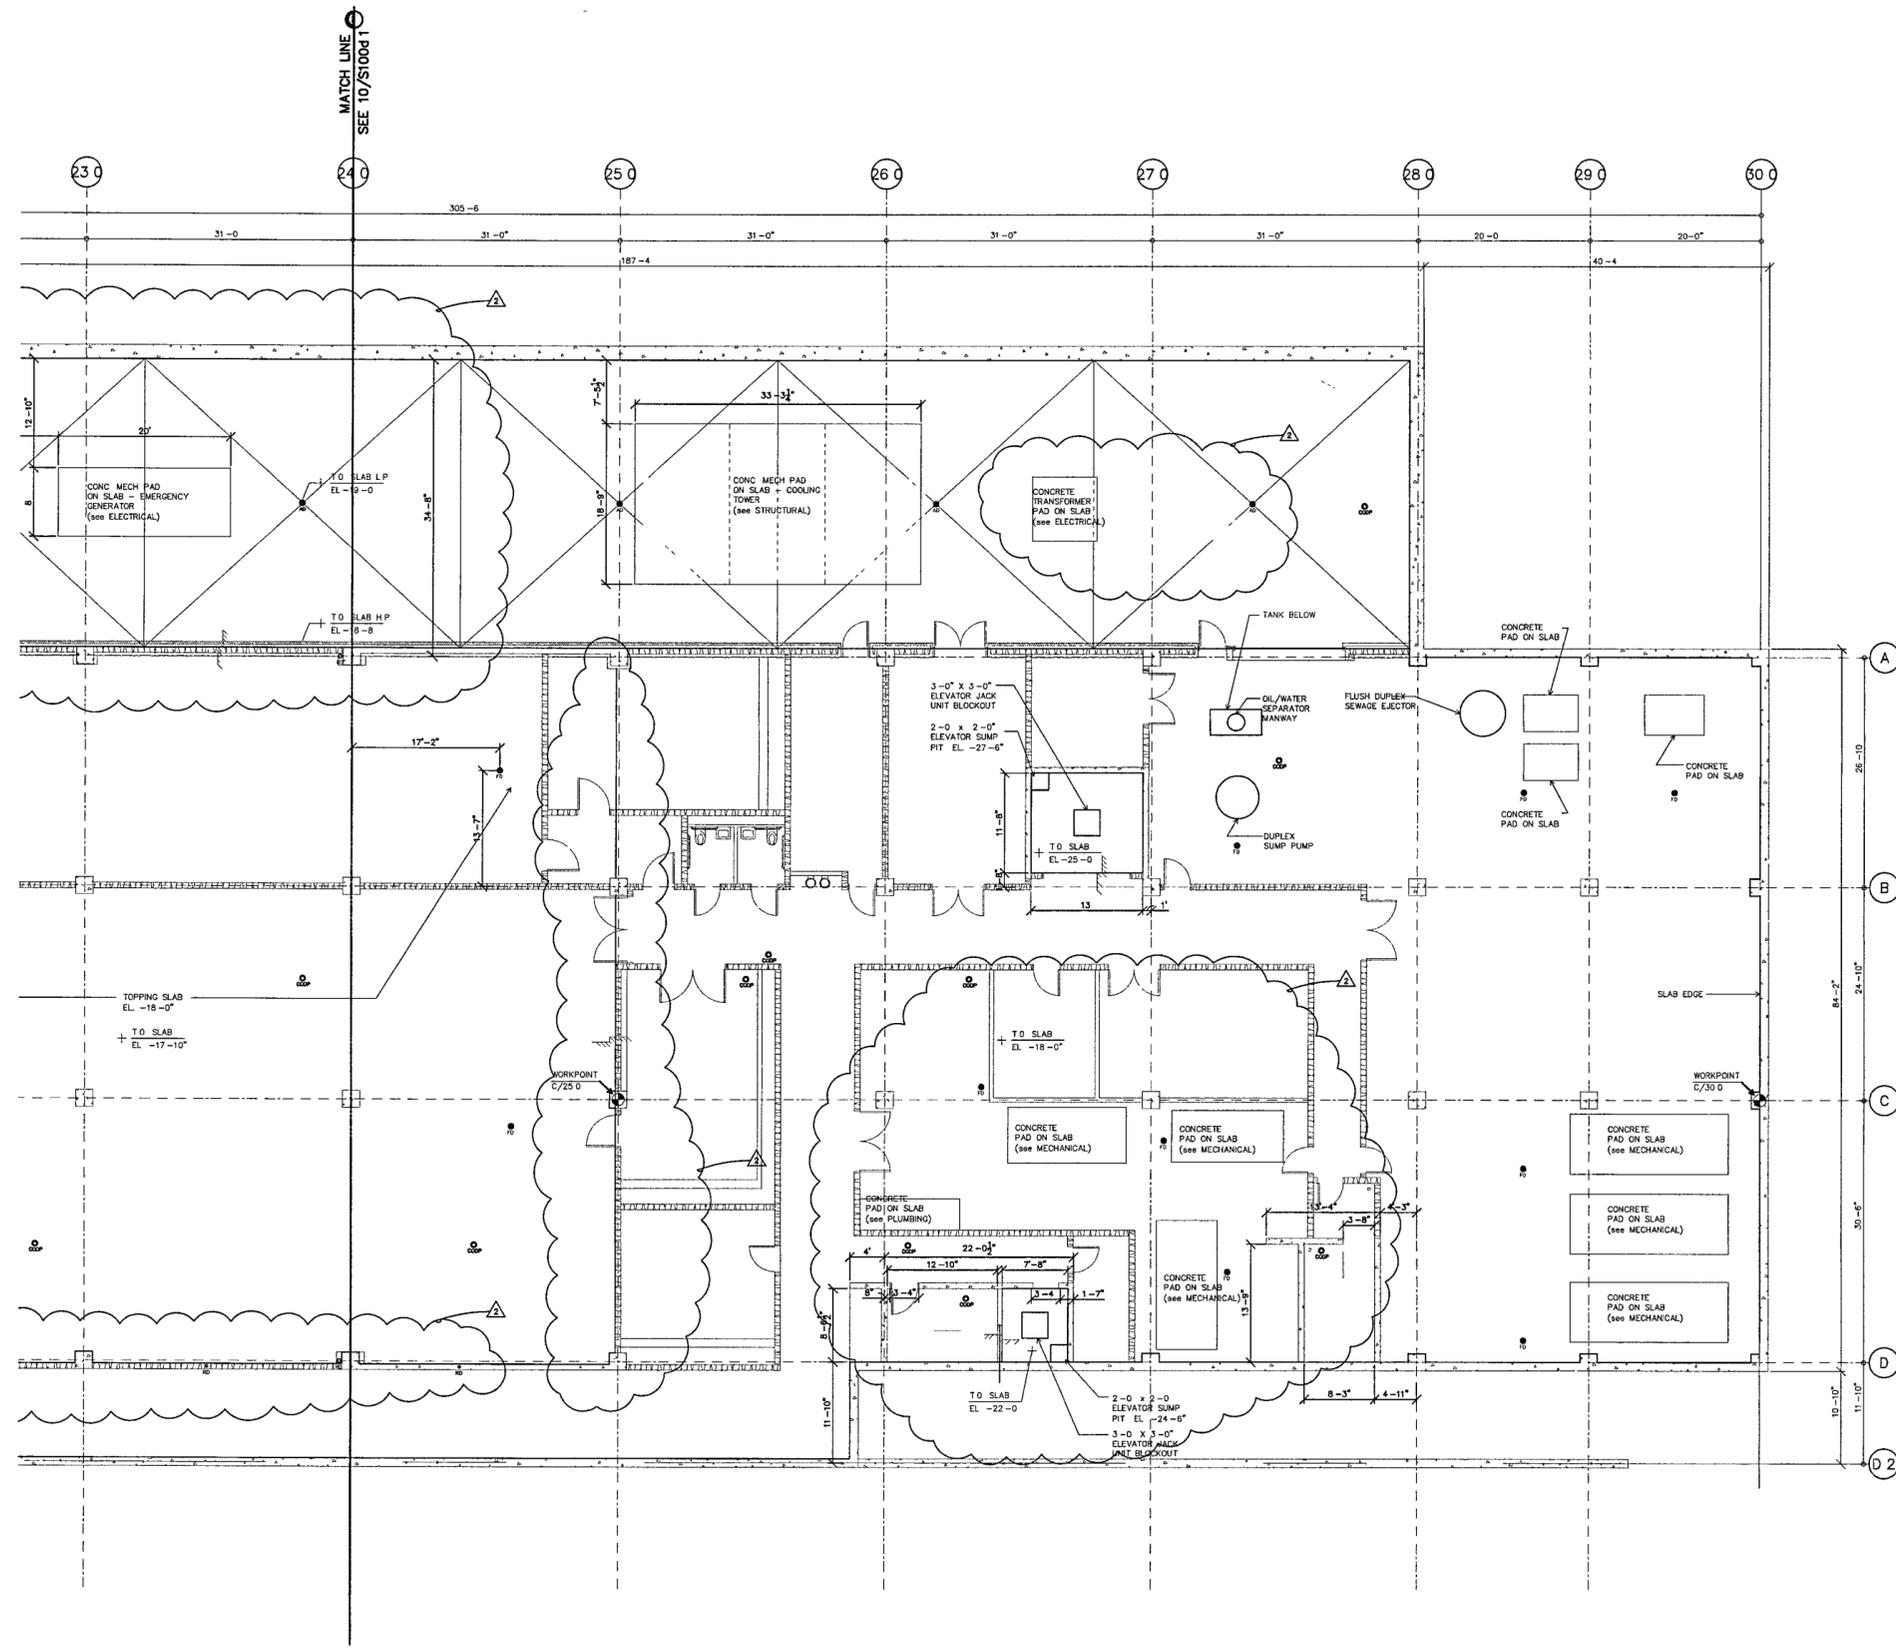

WORKPOINT	NORTHING (Y)	EASTING (X)
H/4 0	150,627 127270	1,234,743.833746
H/8 0	150,508 946830	1,234,723.007298
H/12 0	150,390 770381	1,234,702.180841
C/20 0	150,301 414924	1,234,756.817845
C/25 0	150,149 032475	1,234,750.845291
C/30 0	150 016 134955	1,234,745.636439

BASEMENT SLAB PLAN D  
SCALE 1/8" = 1'-0"