

**WILLIAM J CLINTON  
PRESIDENTIAL  
CENTER**

LITTLE ROCK, ARKANSAS

Architect  
POLSHEK PARTNERSHIP LLP  
320 West 13th Street  
New York, New York 10014  
212 807 7171

Coordinating Architects  
POLK STANLEY YEARY ARCHITECTS Ltd  
700 South Schiller Street  
Little Rock, Arkansas 72201  
501 378 0878

WITSELL EVANS RASCO  
901 West Third Street  
Little Rock, Arkansas 72201  
501 374 5300

WOODS CARADINE ARCHITECTS  
2200 South Main Street  
Little Rock, Arkansas 72208  
501 374 4060

Landscape Architects  
HARGREAVES ASSOCIATES  
118 Magazine Street  
Cambridge, Massachusetts 02139  
617 681 0070


LANDSCAPE ARCHITECTURE, Inc.  
2300 Cottondale Lane Suite 202  
Little Rock, Arkansas 72202  
501 374 8510

Structural Engineer  
LESLIE E ROBERTSON ASSOC, RLLP  
30 Broad Street, 47th Floor  
New York, New York 10004  
212 550 9000


MEP Engineers  
FLACK + KURTZ Inc.  
475 Fifth Avenue  
New York, New York 10017  
212 532 9600

CROMMELL ARCHITECTS ENGINEERS  
101 South Spring Street  
Little Rock, Arkansas 72201  
501 372 2900

Curtainwall Consultant  
R. A. HEINTGES ARCHITECTS  
126 Fifth Avenue, 9th Floor  
New York, New York 10011  
212 552-2965

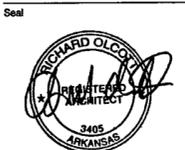

100% Construction Documents	09/27/02
90% Progress Printing	09/30/02
AS1 #05	08/20/02
100% Struct/CD Progress	07/01/02
Bridge Bldg Substructure	09/14/02
100% Steel & Concrete CD	05/15/02
Architectural CD Progress	
Issue	Date
*Issued originally as A701b	

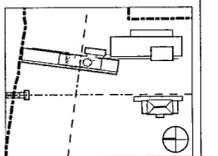

Job No 9908


Scale 1/8" = 1'-0"

Date September 27, 2002

Title **GROUND LEVEL  
PARTIAL SLAB PLAN**

Sheet No **S101b.1**

WORKPOINT	NORTHING (Y)	EASTING (X)
H/4 0	150 627 127270	1234 743 833746
H/8 0	150,508 948830	1234 723 007298
H/12 0	150,390 770381	1234 702 80841
C/20 0	150 301 414924	1234 756 87845
C/25 0	150 148 032475	1234 750 845591
C/30 0	150,06 154955	1234 745 836439

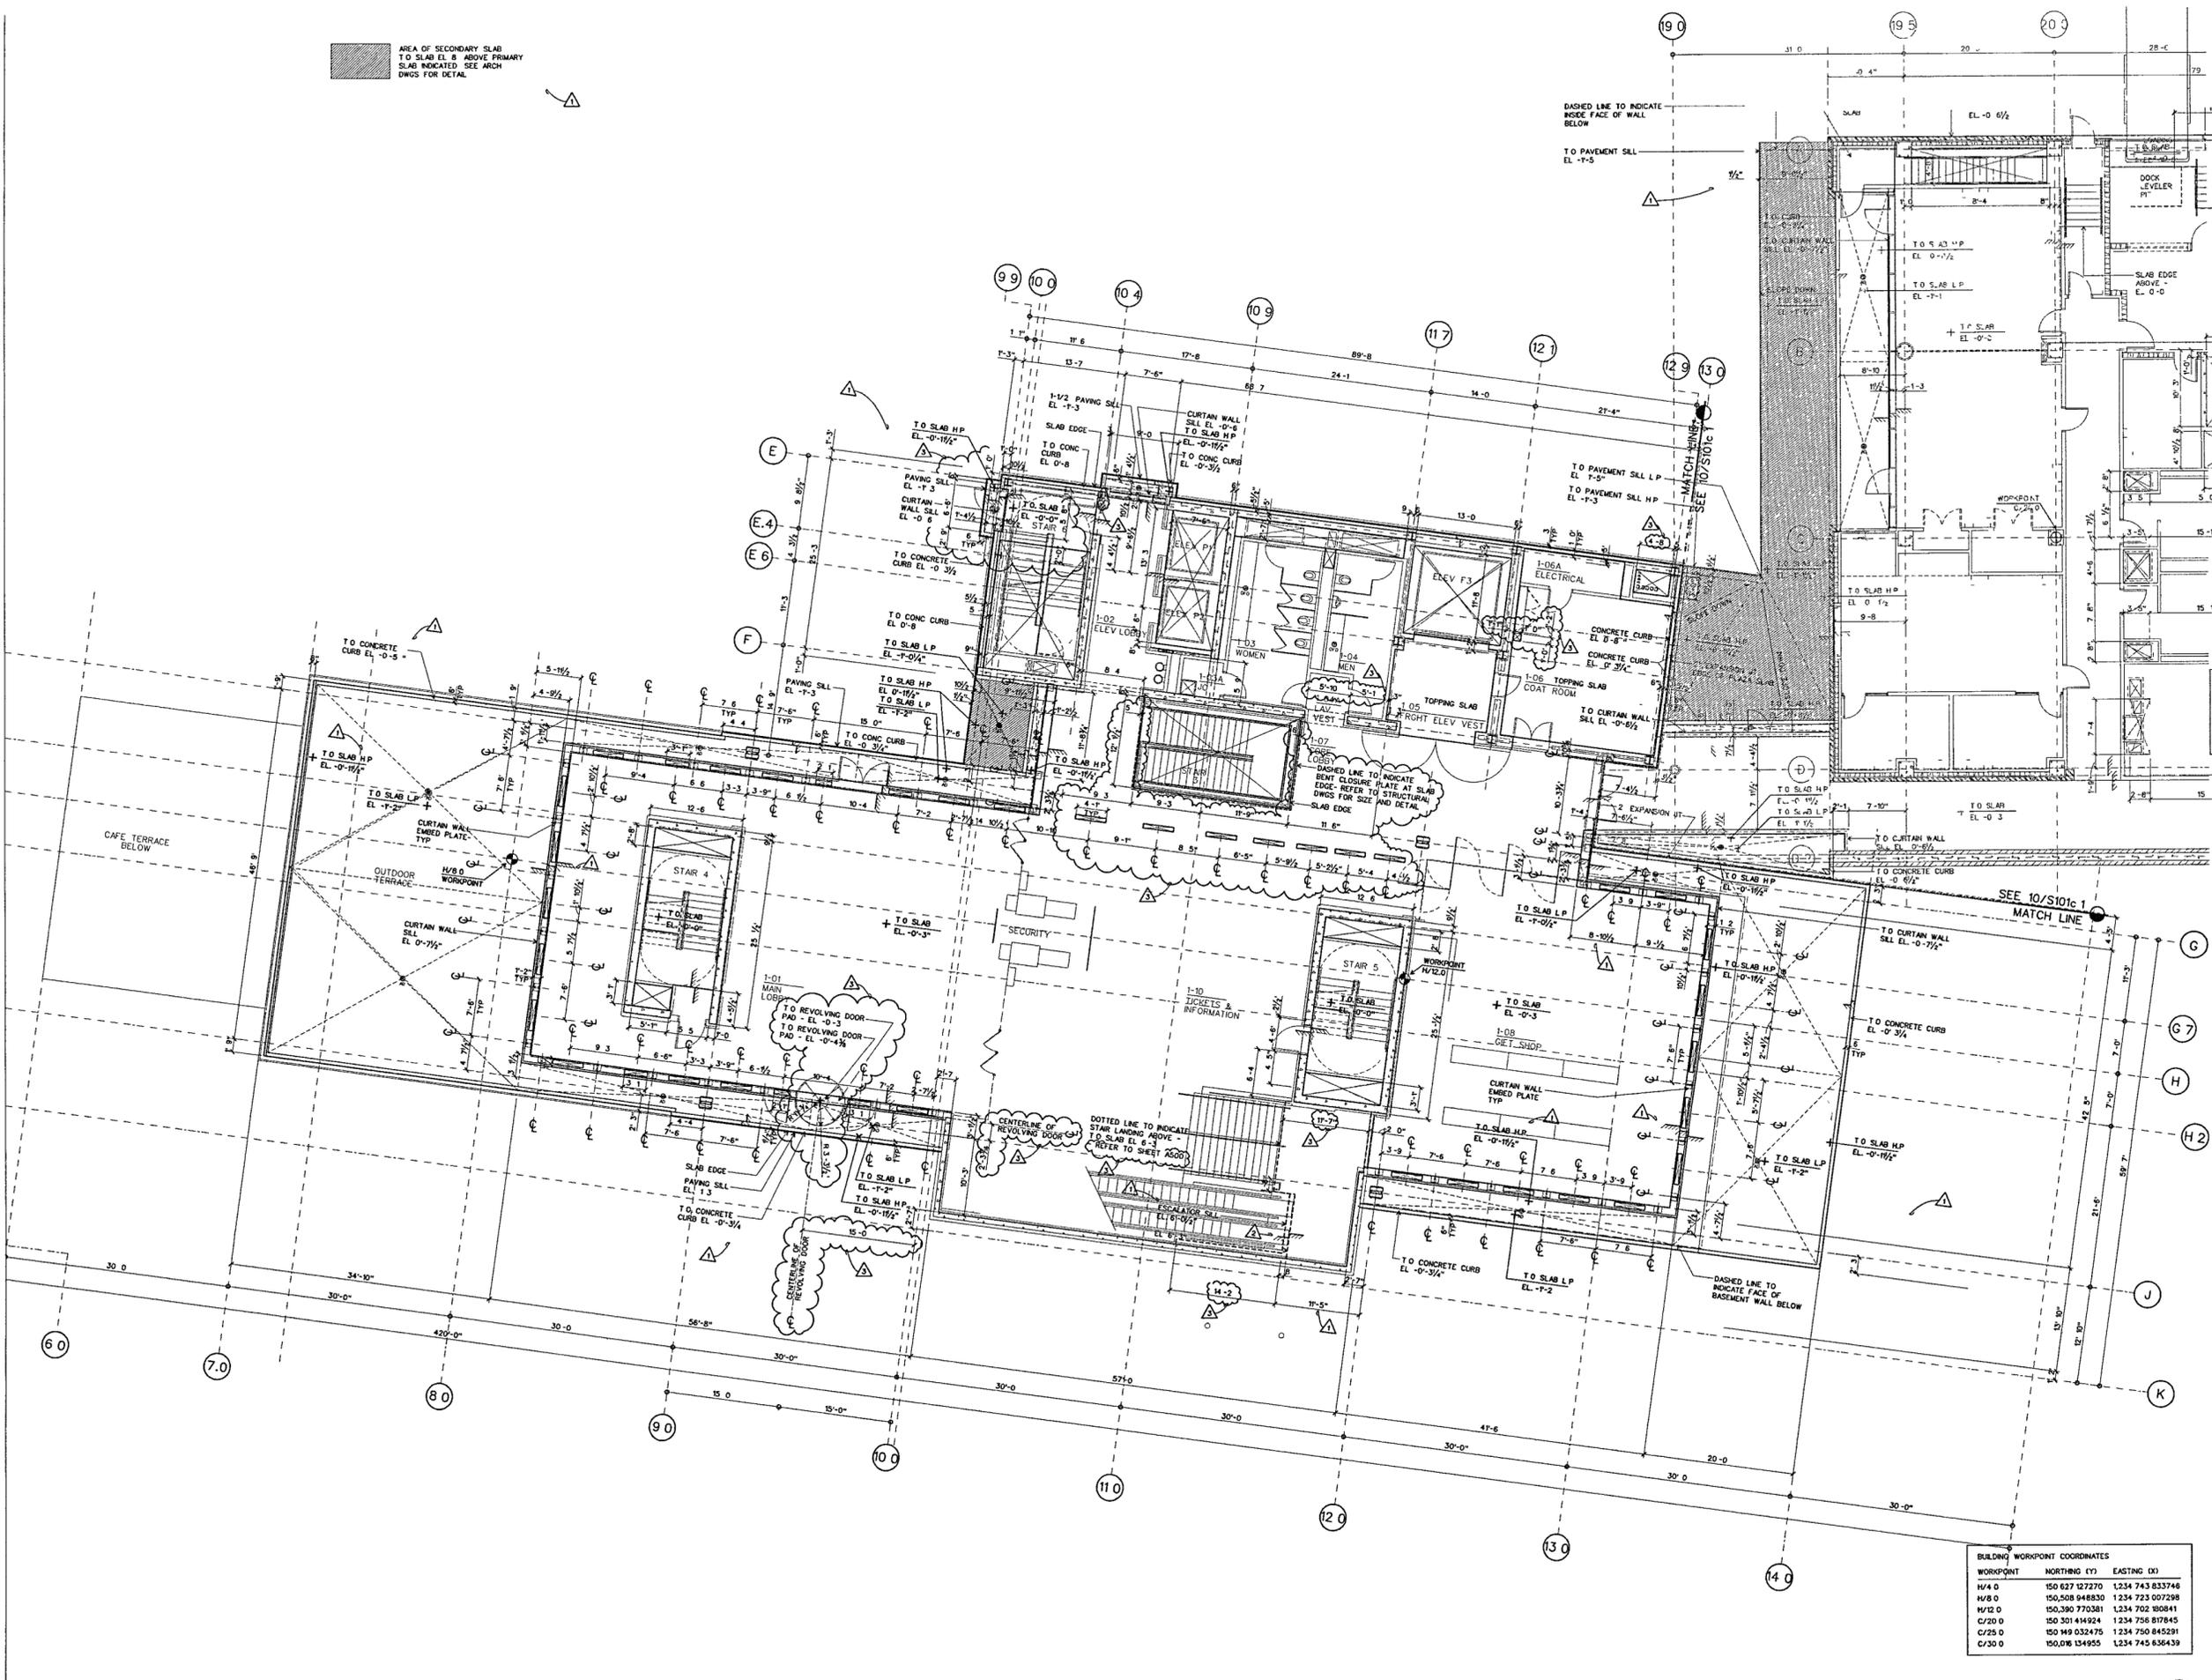

**GROUND LEVEL SLAB PLAN B**  
SCALE 1/4" = 1'-0"