

**WILLIAM J CLINTON
PRESIDENTIAL
CENTER**

LITTLE ROCK, ARKANSAS

Architect
FOLSHEK PARTNERSHIP LLP
320 West 13th Street
New York New York 10014
212 807 7171

Coordinating Architects
POLK STANLEY YEARY ARCHITECTS Ltd
700 South Schiller Street
Little Rock, Arkansas 72201
501 378.0878

WITSELL EVANS RASCO
901 West Third Street
Little Rock, Arkansas 72201
501 374 5300

WOODS CARADINE ARCHITECTS
2200 South Main Street
Little Rock Arkansas 72206
501 374 4960

Landscape Architects
HARGREAVES ASSOCIATES
118 Magazine Street
Cambridge, Massachusetts 02139
617 661 0070


LANDSCAPE ARCHITECTURE, Inc
2300 Cottondale Lane Suite 202
Little Rock, Arkansas 72202
501 374 5610

Structural Engineer
LESLIE E. ROBERTSON ASSOC. RLLP
33 Broad Street, 47th Floor
New York, New York 10004
212 750 9000


MEP Engineers
FLACK + KURTZ Inc
475 Fifth Avenue
New York, New York 10017
212 532 9600

CROMWELL ARCHITECTS ENGINEERS
101 South Spring Street
Little Rock Arkansas 72201
501 372 2900

Curtainwall Consultant
R. A. HEINTGES ARCHITECTS
126 Fifth Avenue, 9th Floor
New York, New York 10011
212 652-2566

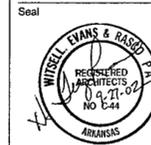


100% Construction Documents	05/27/02
90% Progress Printing	08/30/02
ASI #05	08/20/02
100% Struct./CD Progress	07/01/02
100% Steel & Concrete CD	05/15/02
& Architectural CD Progress	
100% Design Development	03/01/02
Issue	Date

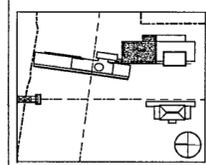

Job No 9908
Scale 1/8" = 1'-0"
Date September 27, 2002
Title

**GROUND LEVEL
PARTIAL SLAB PLAN**

Sheet No
S101c.1

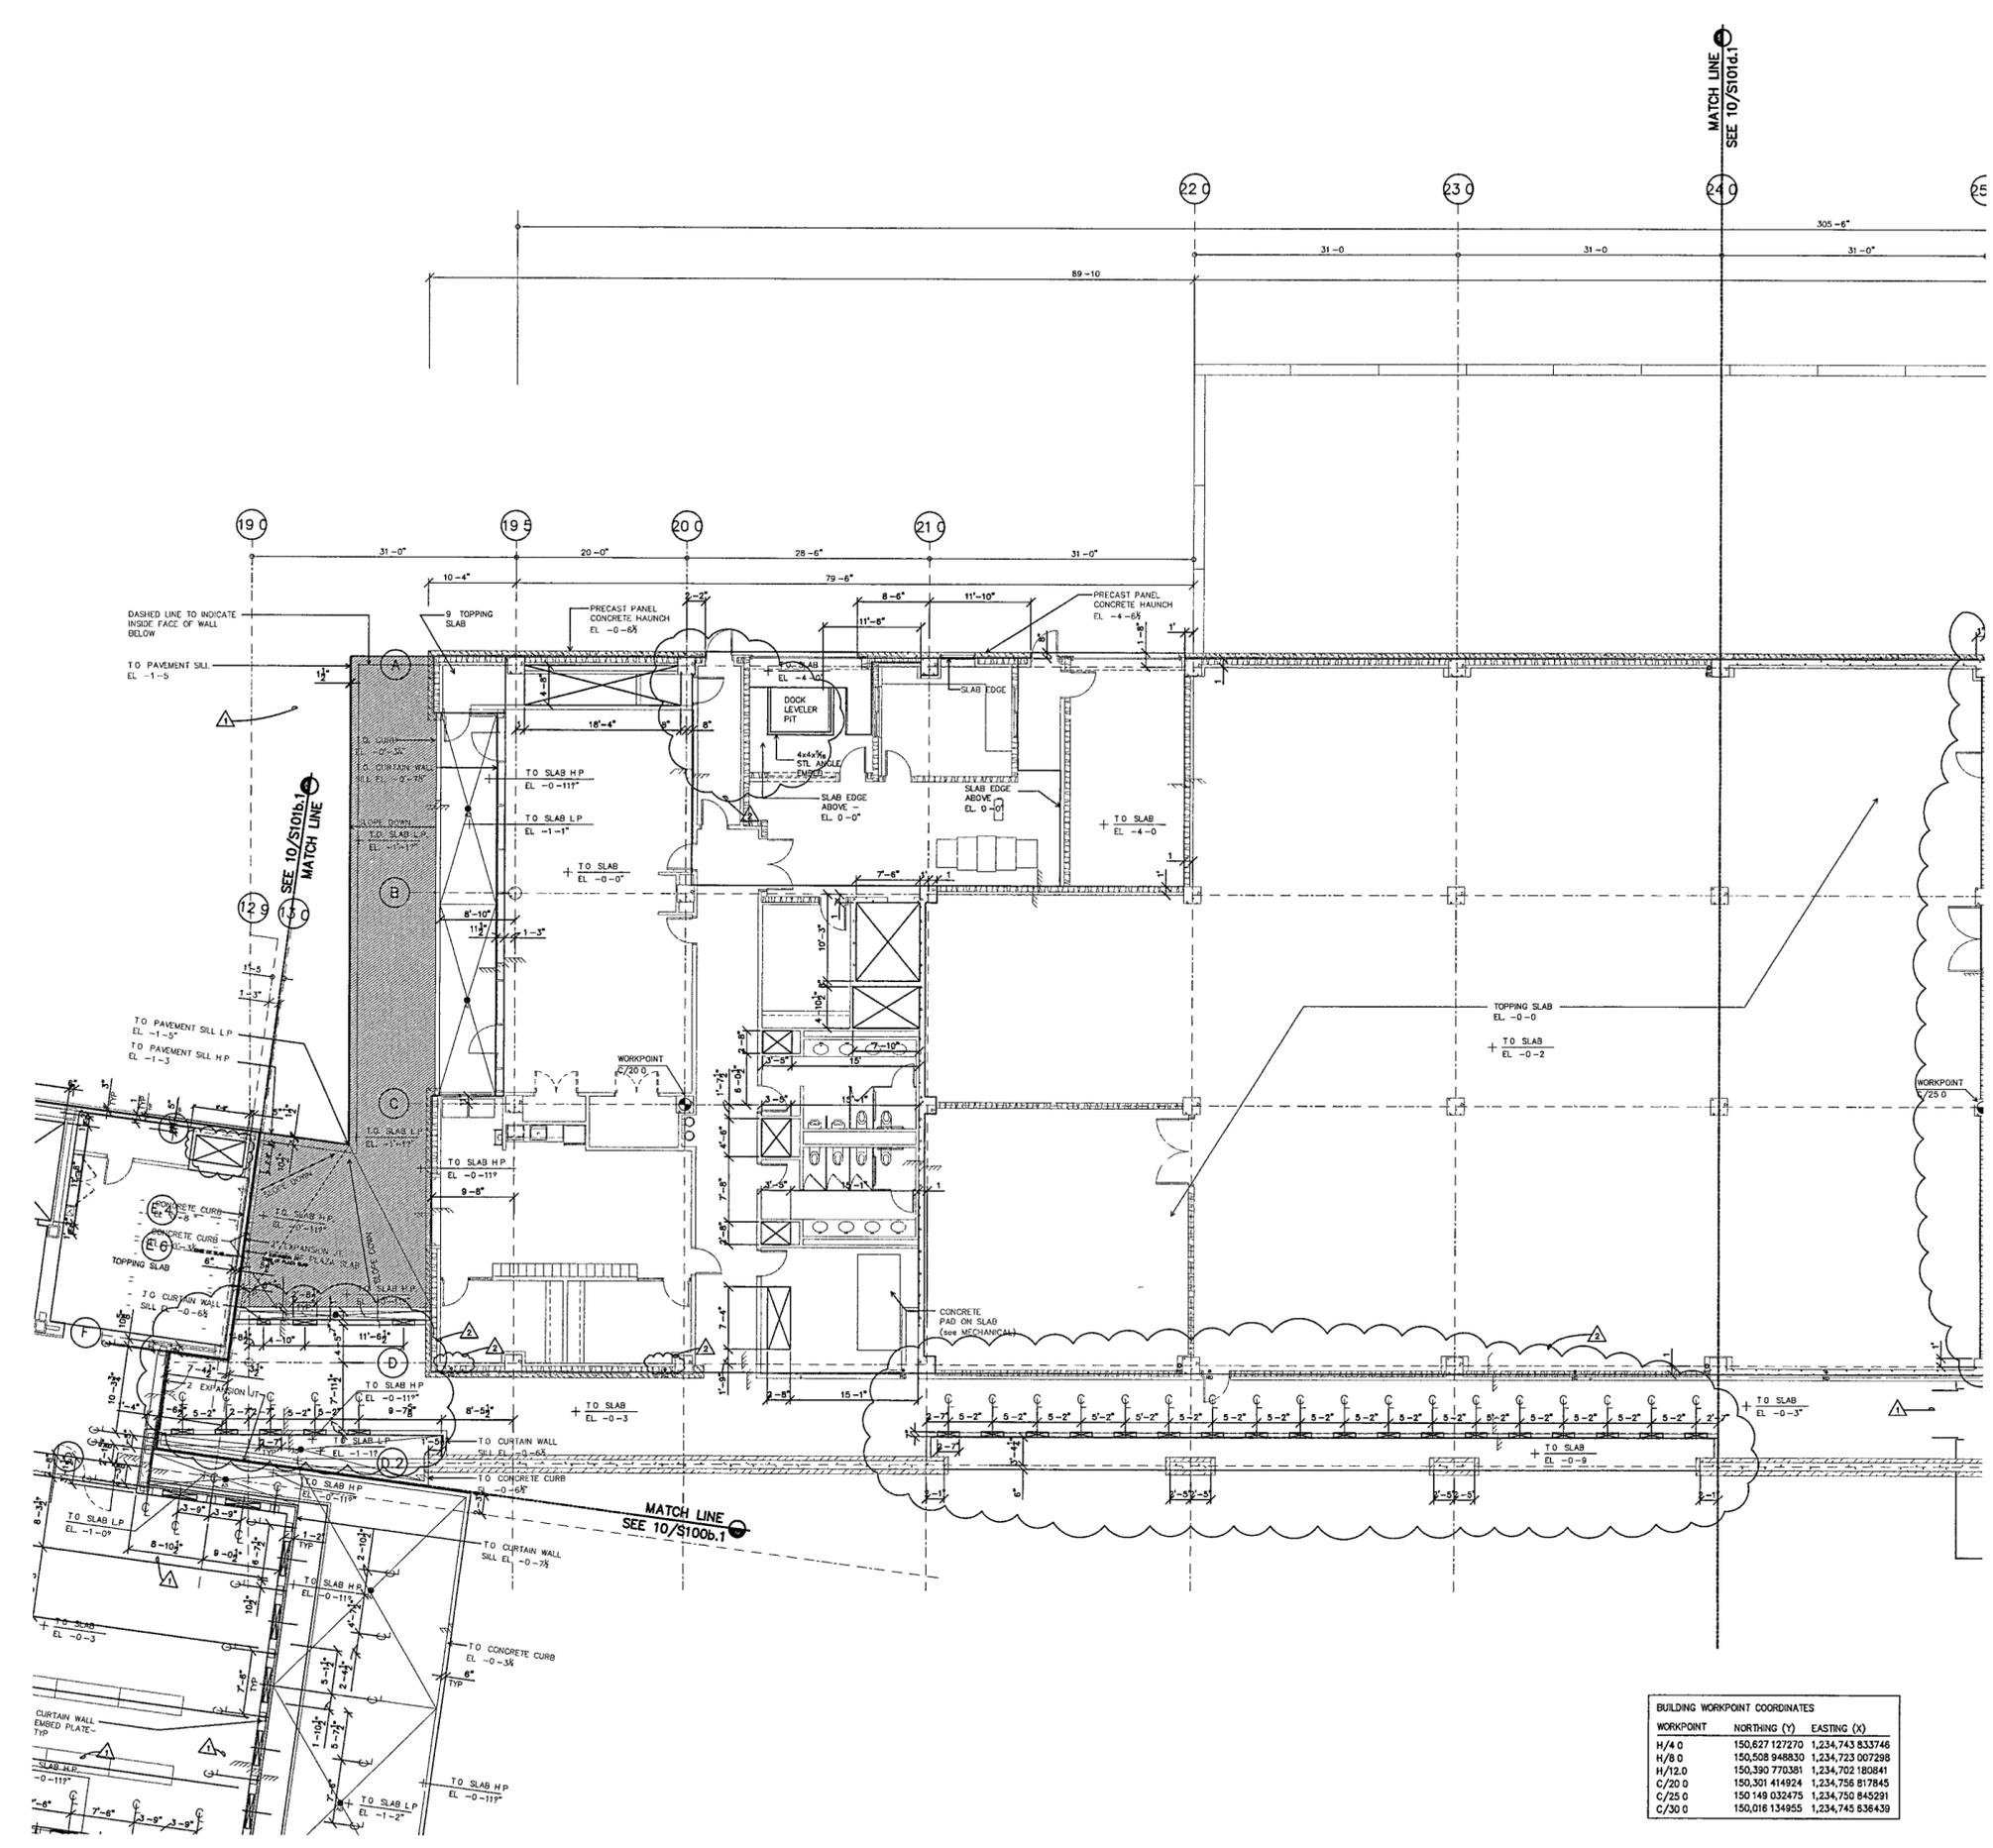

GROUND LEVEL SLAB PLAN C
SCALE 1/8" = 1'-0"

BUILDING WORKPOINT COORDINATES		
WORKPOINT	NORTHING (Y)	EASTING (X)
H/4.0	150,627 127270	1,234,743 833746
H/8.0	150,508 848830	1,234,723 007298
H/12.0	150,390 770381	1,234,702 180845
C/25.0	150 149 032475	1,234,750 845291
C/30.0	150,016 134955	1,234,745 636439

2.28