

**WILLIAM J CLINTON  
PRESIDENTIAL  
CENTER**

LITTLE ROCK, ARKANSAS

Architect  
POLSHEK PARTNERSHIP LLP  
320 West 13th Street  
New York, New York 10014  
212 807 7171

Coordinating Architects  
POLK STANLEY YEARY ARCHITECTS LTD  
700 South Schiller Street  
Little Rock, Arkansas 72201  
501 378 0878

WITSELL EVANS RASCO  
901 West Third Street  
Little Rock, Arkansas 72201  
501 374 5300

WOODS CARADINE ARCHITECTS  
2200 South Main Street  
Little Rock, Arkansas 72206  
501 374 4660

Landscape Architects  
HARGREAVES ASSOCIATES  
118 Magazine Street  
Cambridge, Massachusetts 02139  
617 661 0070

LANDSCAPE ARCHITECTURE Inc  
2300 Cottondale Lane Suite 202  
Little Rock, Arkansas 72202  
501 374 5610

Structural Engineer  
LESLIE E ROBERTSON ASSOC, RLLP  
30 Broad Street 4th Floor  
New York, New York 10004  
212 750 9000

MEP Engineers  
FLACK + KURTZ Inc  
475 Fifth Avenue  
New York, New York 10017  
212 532 9600


CROMWELL ARCHITECTS ENGINEERS  
101 South Spring Street  
Little Rock, Arkansas 72201  
501 372 2900

Curtainwall Consultant  
R. A. HEINTGES ARCHITECTS  
126 Fifth Avenue 9th Floor  
New York, New York 10011  
212 652 2966

Seal



100% Construction Documents	09/27/02
90% Progress Printing	08/30/02
100% Struct./CD Progress	07/01/02
100% Steel & Concrete CD	05/15/02
& Architectural CD Progress	
100% Design Development	03/01/02
Issue	Date

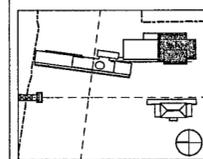

Job No 9908

Scale 1/8" = 1'-0"

Date September 27, 2002

Title


**GROUND LEVEL  
PARTIAL SLAB PLAN**

Sheet No

**S101d.1**

10

FOR OFFICIAL USE ONLY

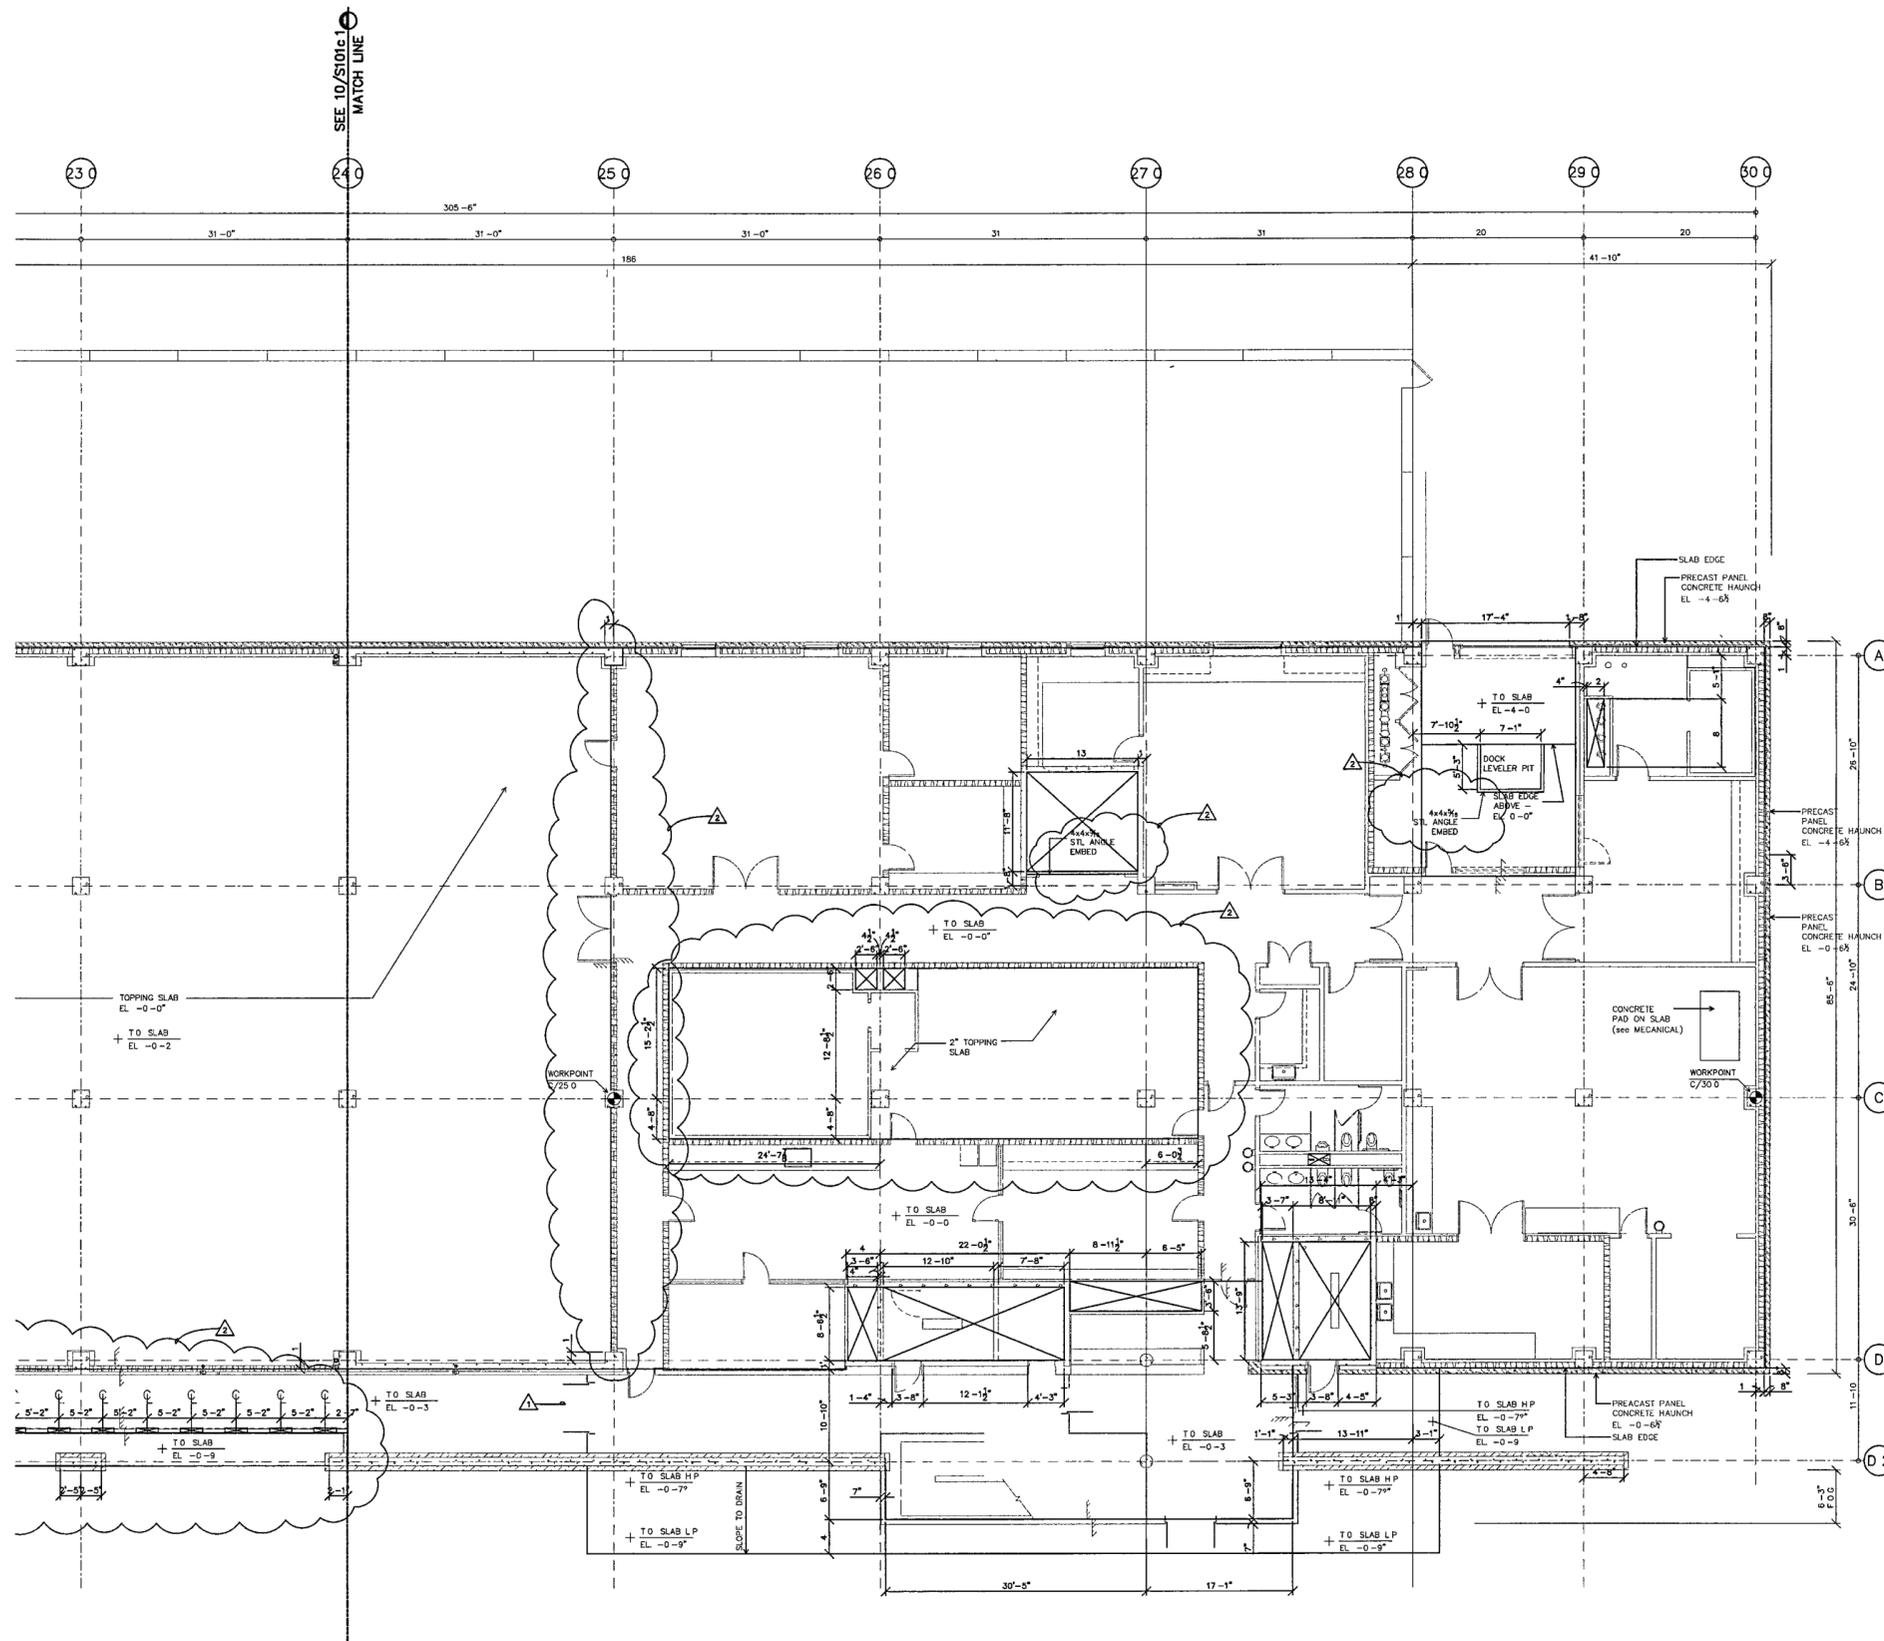

WORKPOINT	NORTHING (Y)	EASTING (X)
H/4 0	150,627 127270	1 234,743 833746
H/8 0	150,508 948830	1,234,723 007298
H/12 0	150,390 770381	1,234,702 180841
C/20 0	150,301 414924	1,234,756 817845
C/25 0	150,149 032475	1,234,750 845291
C/30 0	150,016 134955	1,234,745 636439

GROUND LEVEL SLAB PLAN D

SCALE 1/8" = 1'-0"