

**WILLIAM J CLINTON
PRESIDENTIAL
CENTER**

LITTLE ROCK, ARKANSAS

Architect

POLSHEK PARTNERSHIP LLP
320 West 13th Street
New York, New York 10014
212 807 7171

Coordinating Architects

POLK STANLEY YEARY ARCHITECTS Ltd
700 South Schiller Street
Little Rock, Arkansas 72201
501 378 0878

WITSELL EVANS RASCO
901 West Third Street
Little Rock, Arkansas 72201
501 374 5300

WOODS CARADINE ARCHITECTS
2200 South Main Street
Little Rock, Arkansas 72206
501 374 4060

Landscape Architects

HARGREAVES ASSOCIATES
118 Magazine Street
Cambridge, Massachusetts 02139
617 661 0070

LANDSCAPE ARCHITECTURE, Inc.
2300 Cottondale Lane Suite 202
Little Rock, Arkansas 72202
501 374 5610

Structural Engineer

LESLIE E ROBERTSON ASSOC. RLLP
30 Broad Street, 47th Floor
New York, New York 10004
212 750 9000

MEP Engineers

FLACK + KURTZ Inc.
475 Fifth Avenue
New York, New York 10017
212 532 9600

CROMMELL ARCHITECTS ENGINEERS
101 South Spring Street
Little Rock, Arkansas 72201
501 372 2900


Curtainwall Consultant

R. A. HEINTGES ARCHITECTS
126 Fifth Avenue 8th Floor
New York, New York 10011
212 652-2968

Seal



100% Construction Documents	09/27/02
90% Progress Printing	08/30/02
100% Struct / CD Progress	07/01/02
100% Steel & Concrete CD	05/15/02
& Architectural CD Progress	
Issue	Date
*Issued originally as A702a	

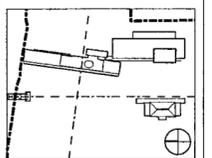

Job No. 9908

Scale 1/8" = 1'-0"


Date September 27 2002

Title

**SECOND LEVEL
PARTIAL SLAB PLAN**

Sheet No.

S102a.1

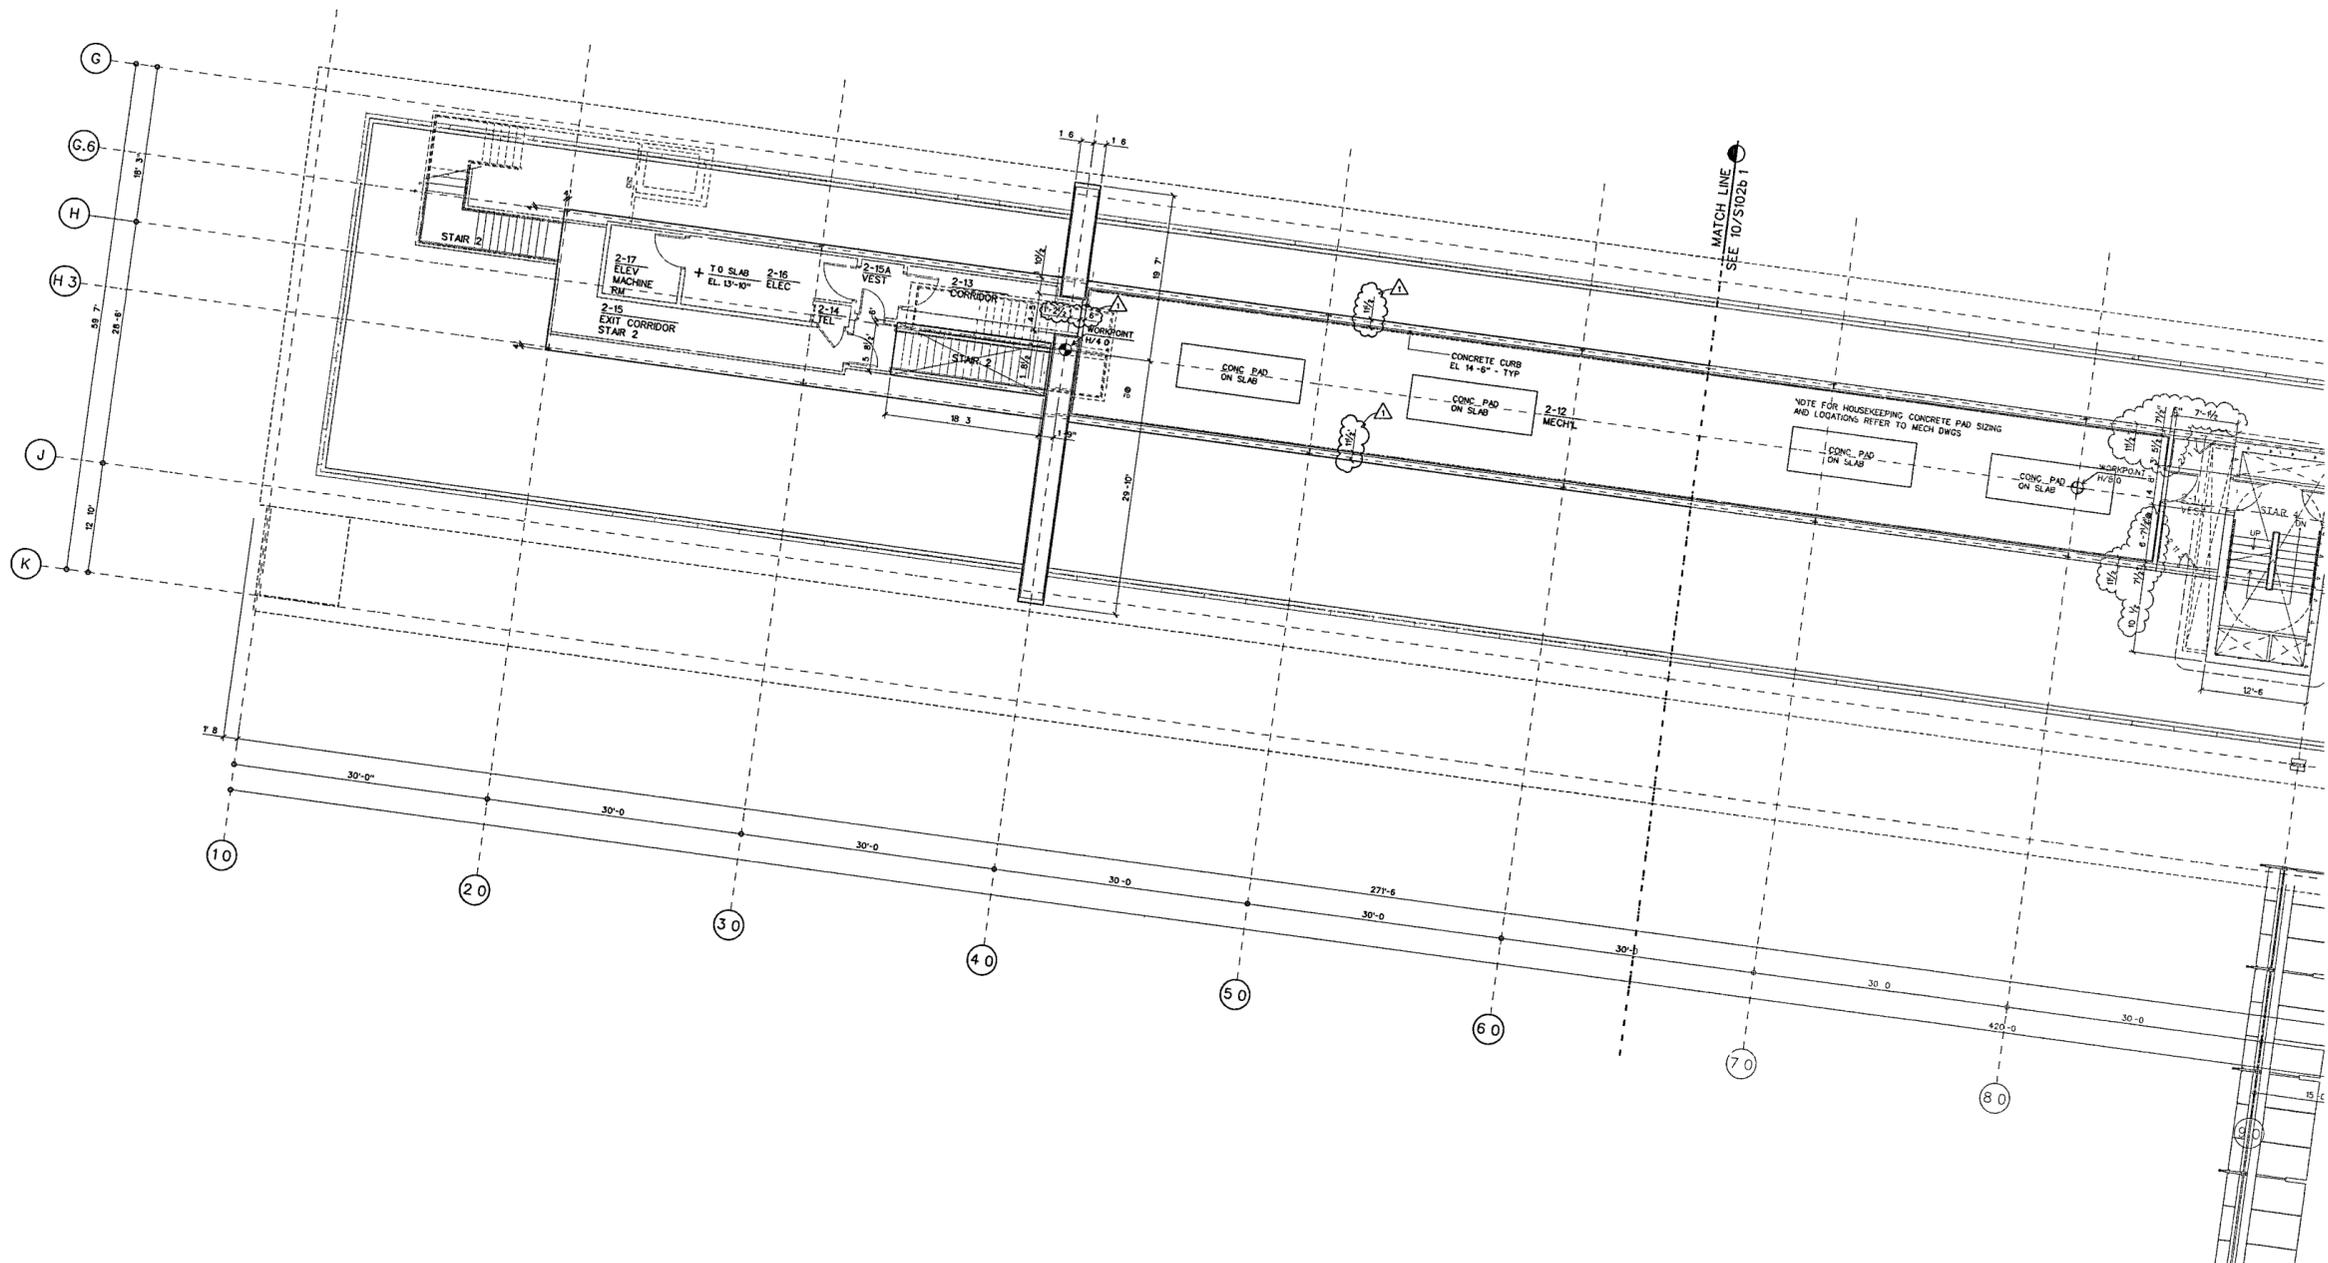

BUILDING WORKPOINT COORDINATES

WORKPOINT	NORTHING (Y)	EASTING (X)
H/4 0	150,627 127270	1,234 743 833746
H/6 0	150,508 944830	1,234 723,007298
H/20 0	150,390 770381	1,234 702 805841
C/20 0	150,301 414924	1,234 756 817845
C/25 0	150 149 032475	1,234 750 845291
C/30 0	150,016,134905	1,234 745 636439

SECOND LEVEL SLAB PLAN A
SCALE 1/8" = 1'-0"

SLAB-02 DGN 10

FOR OFFICIAL USE ONLY