

**WILLIAM J CLINTON  
PRESIDENTIAL  
CENTER**

LITTLE ROCK ARKANSAS

Architect  
POLSHK PARTNERSHIP LLP  
320 West 13th Street  
New York, New York 10014  
212 607 7171

Coordinating Architects  
POLK STANLEY YEARY ARCHITECTS Ltd  
700 South Schaller Street  
Little Rock, Arkansas 72201  
501 378 0878

WITSELL EVANS RASCO  
901 West Third Street  
Little Rock, Arkansas 72201  
501 374 6300

WOODS CARADINE ARCHITECTS  
2200 South Main Street  
Little Rock, Arkansas 72206  
501 374 4050

Landscape Architects  
HARGREAVES ASSOCIATES  
118 Magazine Street  
Cambridge, Massachusetts 02139  
617 681 0070

LANDSCAPE ARCHITECTURE, Inc.  
2300 Cotontdale Lane Suite 202  
Little Rock, Arkansas 72202  
501 374 6810

Structural Engineer  
LESLIE E. ROBERTSON ASSOC. RLLP  
30 Broad Street, 47th Floor  
New York, New York 10004  
212 750 9000


MEP Engineers  
FLACK + KURTZ Inc.  
475 Fifth Avenue  
New York, New York 10017  
212 532 9500

CROMWELL ARCHITECTS ENGINEERS  
101 South Spring Street  
Little Rock, Arkansas 72201  
501 372 2900

Curtainwall Consultant  
R. A. HEINTGES ARCHITECTS  
125 Fifth Avenue 9th Floor  
New York, New York 10011  
212 652 2968



100% Construction Documents	06/27/02
90% Progress Printing	06/30/02
100% Struct./ CD Progress	07/01/02
100% Steel & Concrete CD	05/15/02
& Architectural CD Progress	
Issue	Date
*Issued originally as A702b	

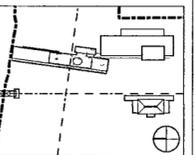


Job No. 9908  
Scale 1/8" = 1'-0"  
Date September 27, 2002

**SECOND LEVEL  
PARTIAL SLAB PLAN**

Sheet No. **S102b.1**

WORKPOINT	NORTHING (Y)	EASTING (X)
H/4 0	150 627 127270	1,234 743 833746
H/12 0	150,390 770381	1,234 702 190841
C/20 0	150 301,414,924	1,234 756 817845
C/25 0	150 149 032475	1,234 750 845291
C/30 0	150,016 134955	1,234 745 636439

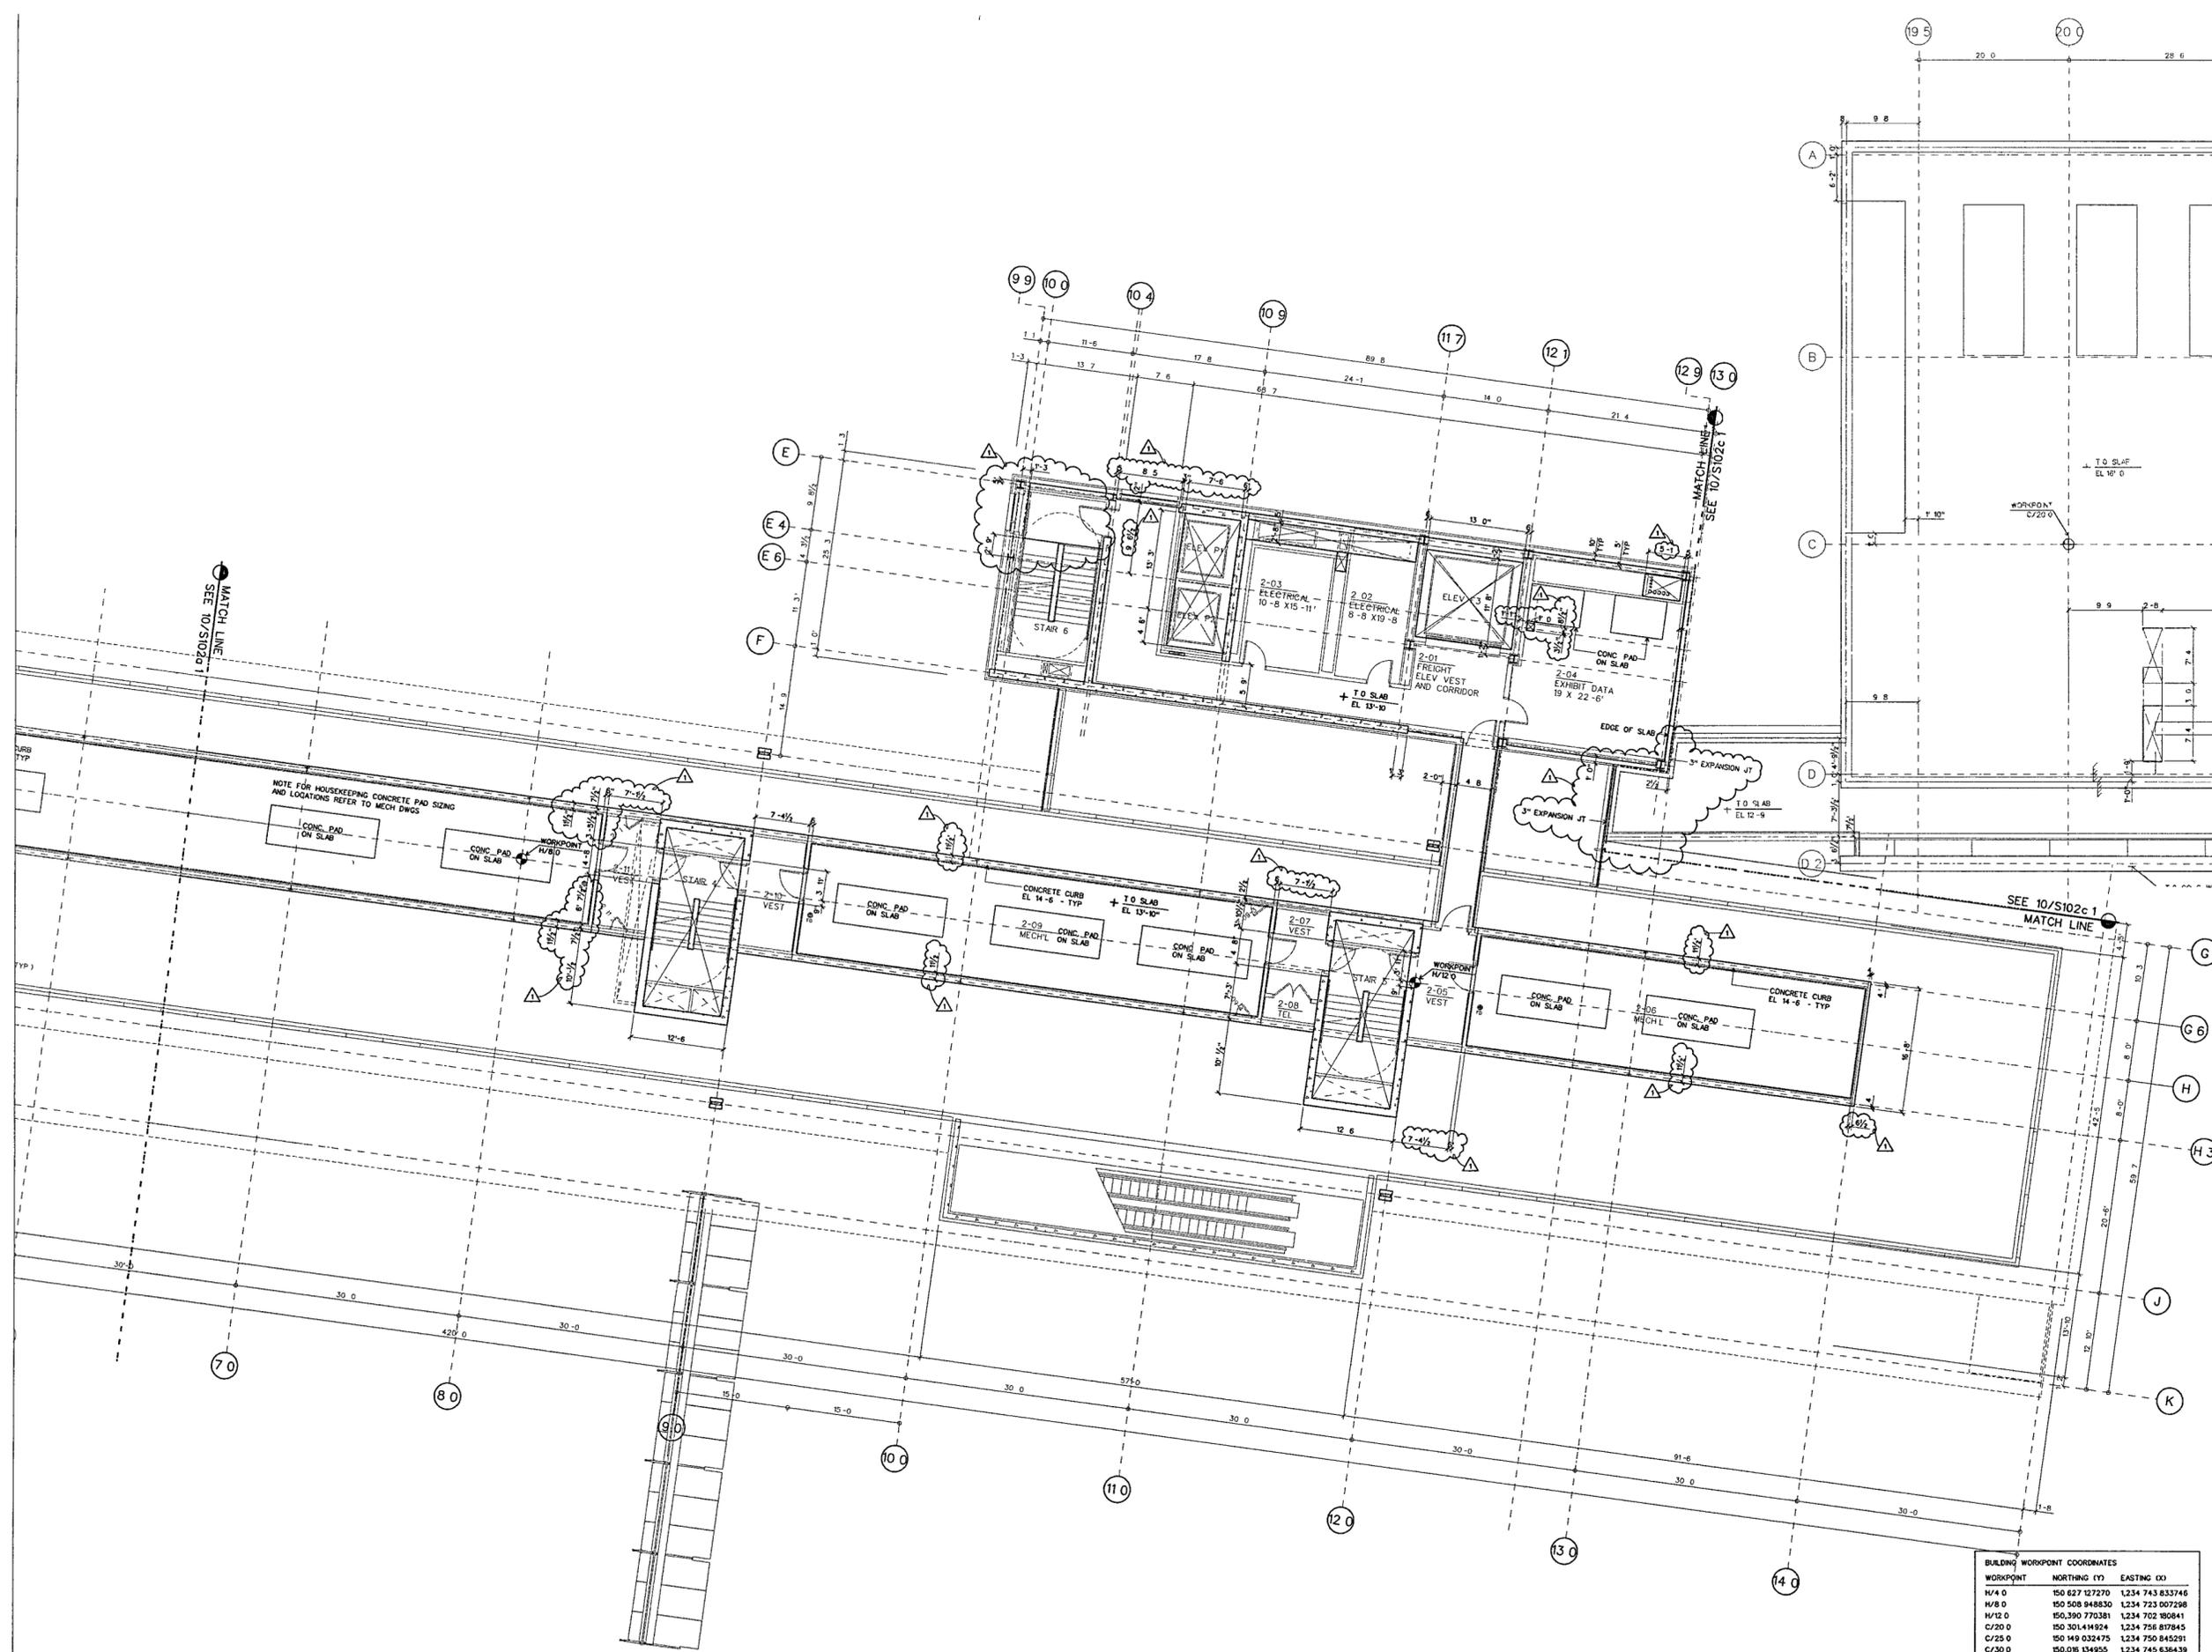

SECOND LEVEL SLAB PLAN B  
SCALE 1/8" = 1'-0"

SLAB-02 DGN 10

FOR OFFICIAL USE ONLY