

**WILLIAM J CLINTON  
PRESIDENTIAL  
CENTER**

LITTLE ROCK, ARKANSAS

Architect

POLSHEK PARTNERSHIP LLP  
320 West 13th Street  
New York, New York 10014  
212 607 7171

Coordinating Architects

POLK STANLEY YEARY ARCHITECTS LTD  
700 South Schiller Street  
Little Rock, Arkansas 72201  
501 378 0878

WITSELL EVANS RASCO  
901 West Third Street  
Little Rock, Arkansas 72201  
501 374 5300

WOODS CARADINE ARCHITECTS  
2200 South Main Street  
Little Rock, Arkansas 72206  
501 374 4060

Landscape Architects

HARGREAVES ASSOCIATES  
118 Magazine Street  
Cambridge, Massachusetts 02139  
617 861 0070

LANDSCAPE ARCHITECTURE, Inc.  
2300 Cottondale Lane Suite 202  
Little Rock, Arkansas 72202  
501 374 5610

Structural Engineer

LESLIE E ROBERTSON ASSOC., RLLP  
30 Broad Street, 47th Floor  
New York, New York 10004  
212.750.9000

MEP Engineers

FLACK + KURTZ Inc.  
475 Fifth Avenue  
New York, New York 10017  
212.532.9600

CROMWELL ARCHITECTS ENGINEERS  
101 South Spring Street  
Little Rock, Arkansas 72201  
501 372.2800


Curtainwall Consultant

R. A. HEINTGES ARCHITECTS  
125 Fifth Avenue 8th Floor  
New York, New York 10011  
212 652-2968

Seal



100% Construction Documents	06/27/02
90% Progress Printing	08/30/02
100% Struct/ CD Progress	07/01/02
100% Steel & Concrete CD	05/15/02
& Architectural CD Progress	
Issue	Date
*Issued originally as A703a	

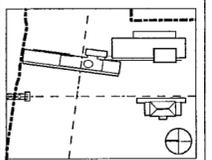

Job No 9908


Scale 1/8" = 1'-0"

Date September 27, 2002

Title MUSEUM LOWER LEVEL PARTIAL SLAB PLAN

Sheet No

**S103a.1**

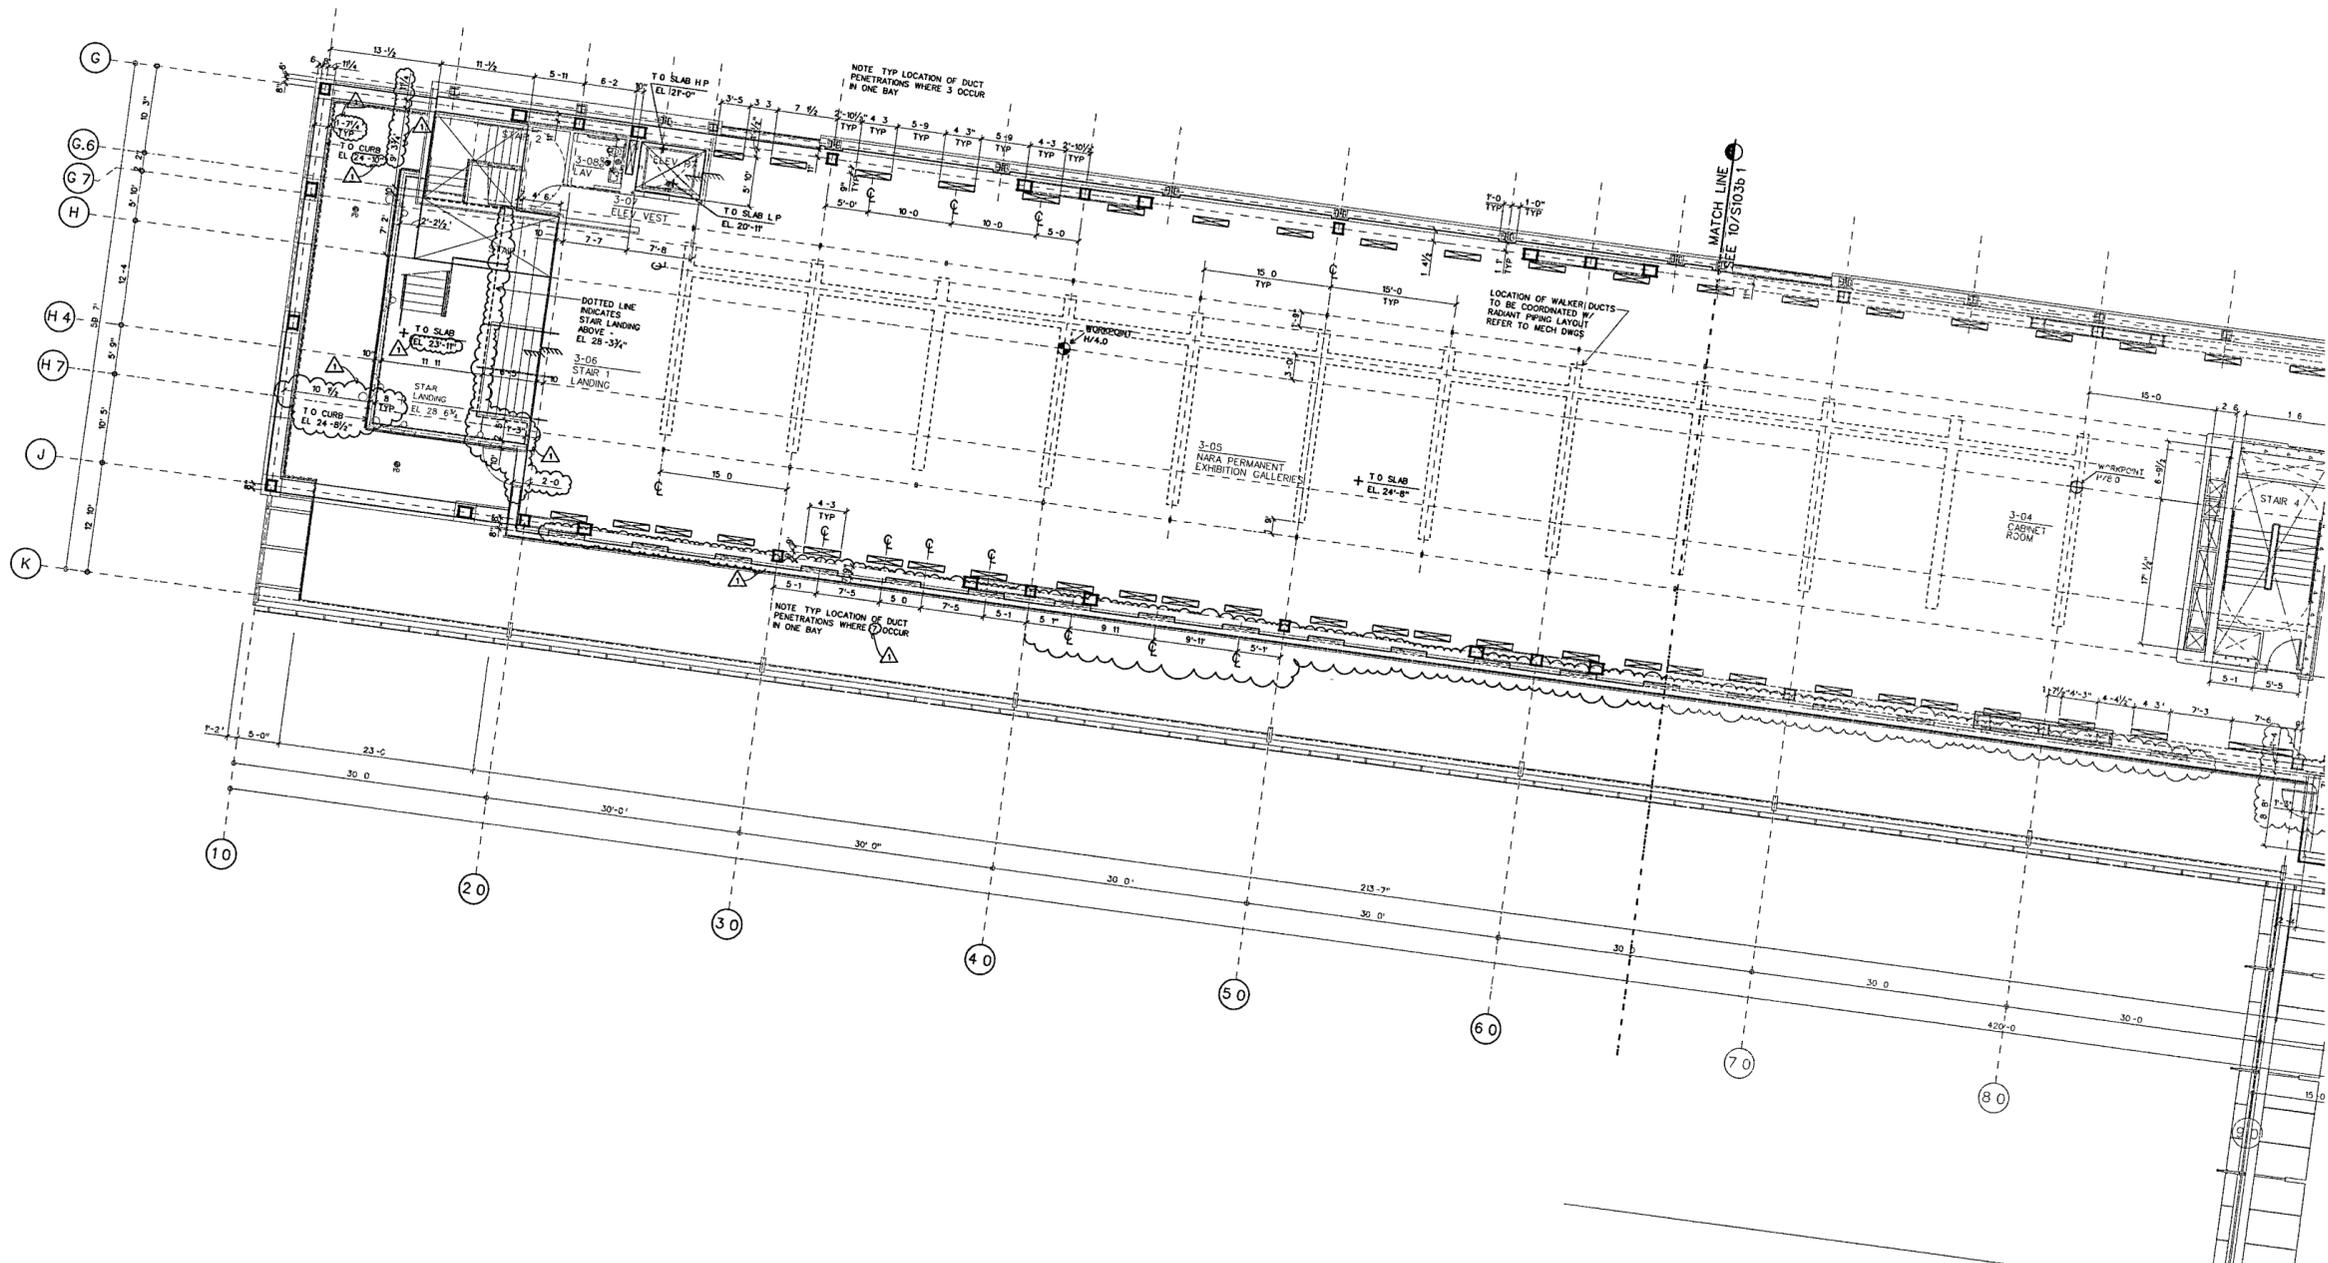

WORKPOINT	NORTHING (Y)	EASTING (X)
H/4.0	150 627 127270	1234 743 833746
H/6.0	150,568 948830	1234 723 007296
H/12.0	150,390 770381	1234 702 808841
C/20.0	150 30141924	1234 756 817845
C/25.0	150 149 032475	1234 750 845291
C/30.0	150 016 134955	1234 745 636439

MUSEUM LOWER LEVEL SLAB PLAN A  
SCALE 1/8" = 1'-0"

SLAB-03 DGN 10

FOR OFFICIAL USE ONLY