

**WILLIAM J CLINTON
PRESIDENTIAL
CENTER**

LITTLE ROCK, ARKANSAS

Architect
POLSHEK PARTNERSHIP LLP
320 West 13th Street
New York, New York 10014
212.807.7171

Coordinating Architects
POLK STANLEY YEARY ARCHITECTS Ltd
700 South Schuler Street
Little Rock, Arkansas 72201
501.378.0878

WITSELL EVANS RASCO
901 West Third Street
Little Rock, Arkansas 72201
501.374.5300

WOODS CARADINE ARCHITECTS
2200 South Main Street
Little Rock, Arkansas 72206
501.374.4055

Landscape Architects
HARGREAVES ASSOCIATES
118 Magalloway Street
Cambridge, Massachusetts 02139
617.661.0070

LANDSCAPE ARCHITECTURE, Inc.
2300 Cotuit Lane Suite 202
Little Rock, Arkansas 72202
501.374.5810

Structural Engineer
LESLIE E ROBERTSON ASSOC RLLP
30 Broad Street, 4th Floor
New York, New York 10004
212.750.9000

MEP Engineers
FLACK + KURTZ Inc
475 Fifth Avenue
New York, New York 10017
212.532.9600


CROMWELL ARCHITECTS ENGINEERS
101 South Spring Street
Little Rock, Arkansas 72201
501.372.2900

Curtainwall Consultant
R. A. HEINTGES ARCHITECTS
1228 Fifth Avenue, 9th Floor
New York, New York 10011
212.652.2666

Seal



100% Construction Documents	08/27/02
90% Progress Printing	08/30/02
100% Struct./CD Progress	07/01/02
100% Steel & Concrete CD	05/15/02
& Architectural CD Progress	
Issue	Date
*Issued originally as A703b	

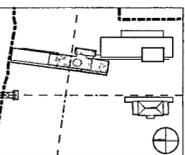

Job No 9908

Scale 1/8" = 1'-0"


Date September 27, 2002

Title
**MUSEUM
LOWER LEVEL
PARTIAL SLAB PLAN**

Sheet No

S103b.1

WORKPOINT	NORTHING (Y)	EASTING (X)
H/4 0	150,827.127270	1,234,743.833746
H/8 0	150,508.948830	1,234,723.007298
H/12 0	150,380.770381	1,234,702.808841
C/20 0	150,301.414924	1,234,726.817845
C/25 0	150,149.032475	1,234,750.845291
C/30 0	150,016.134955	1,234,745.836439

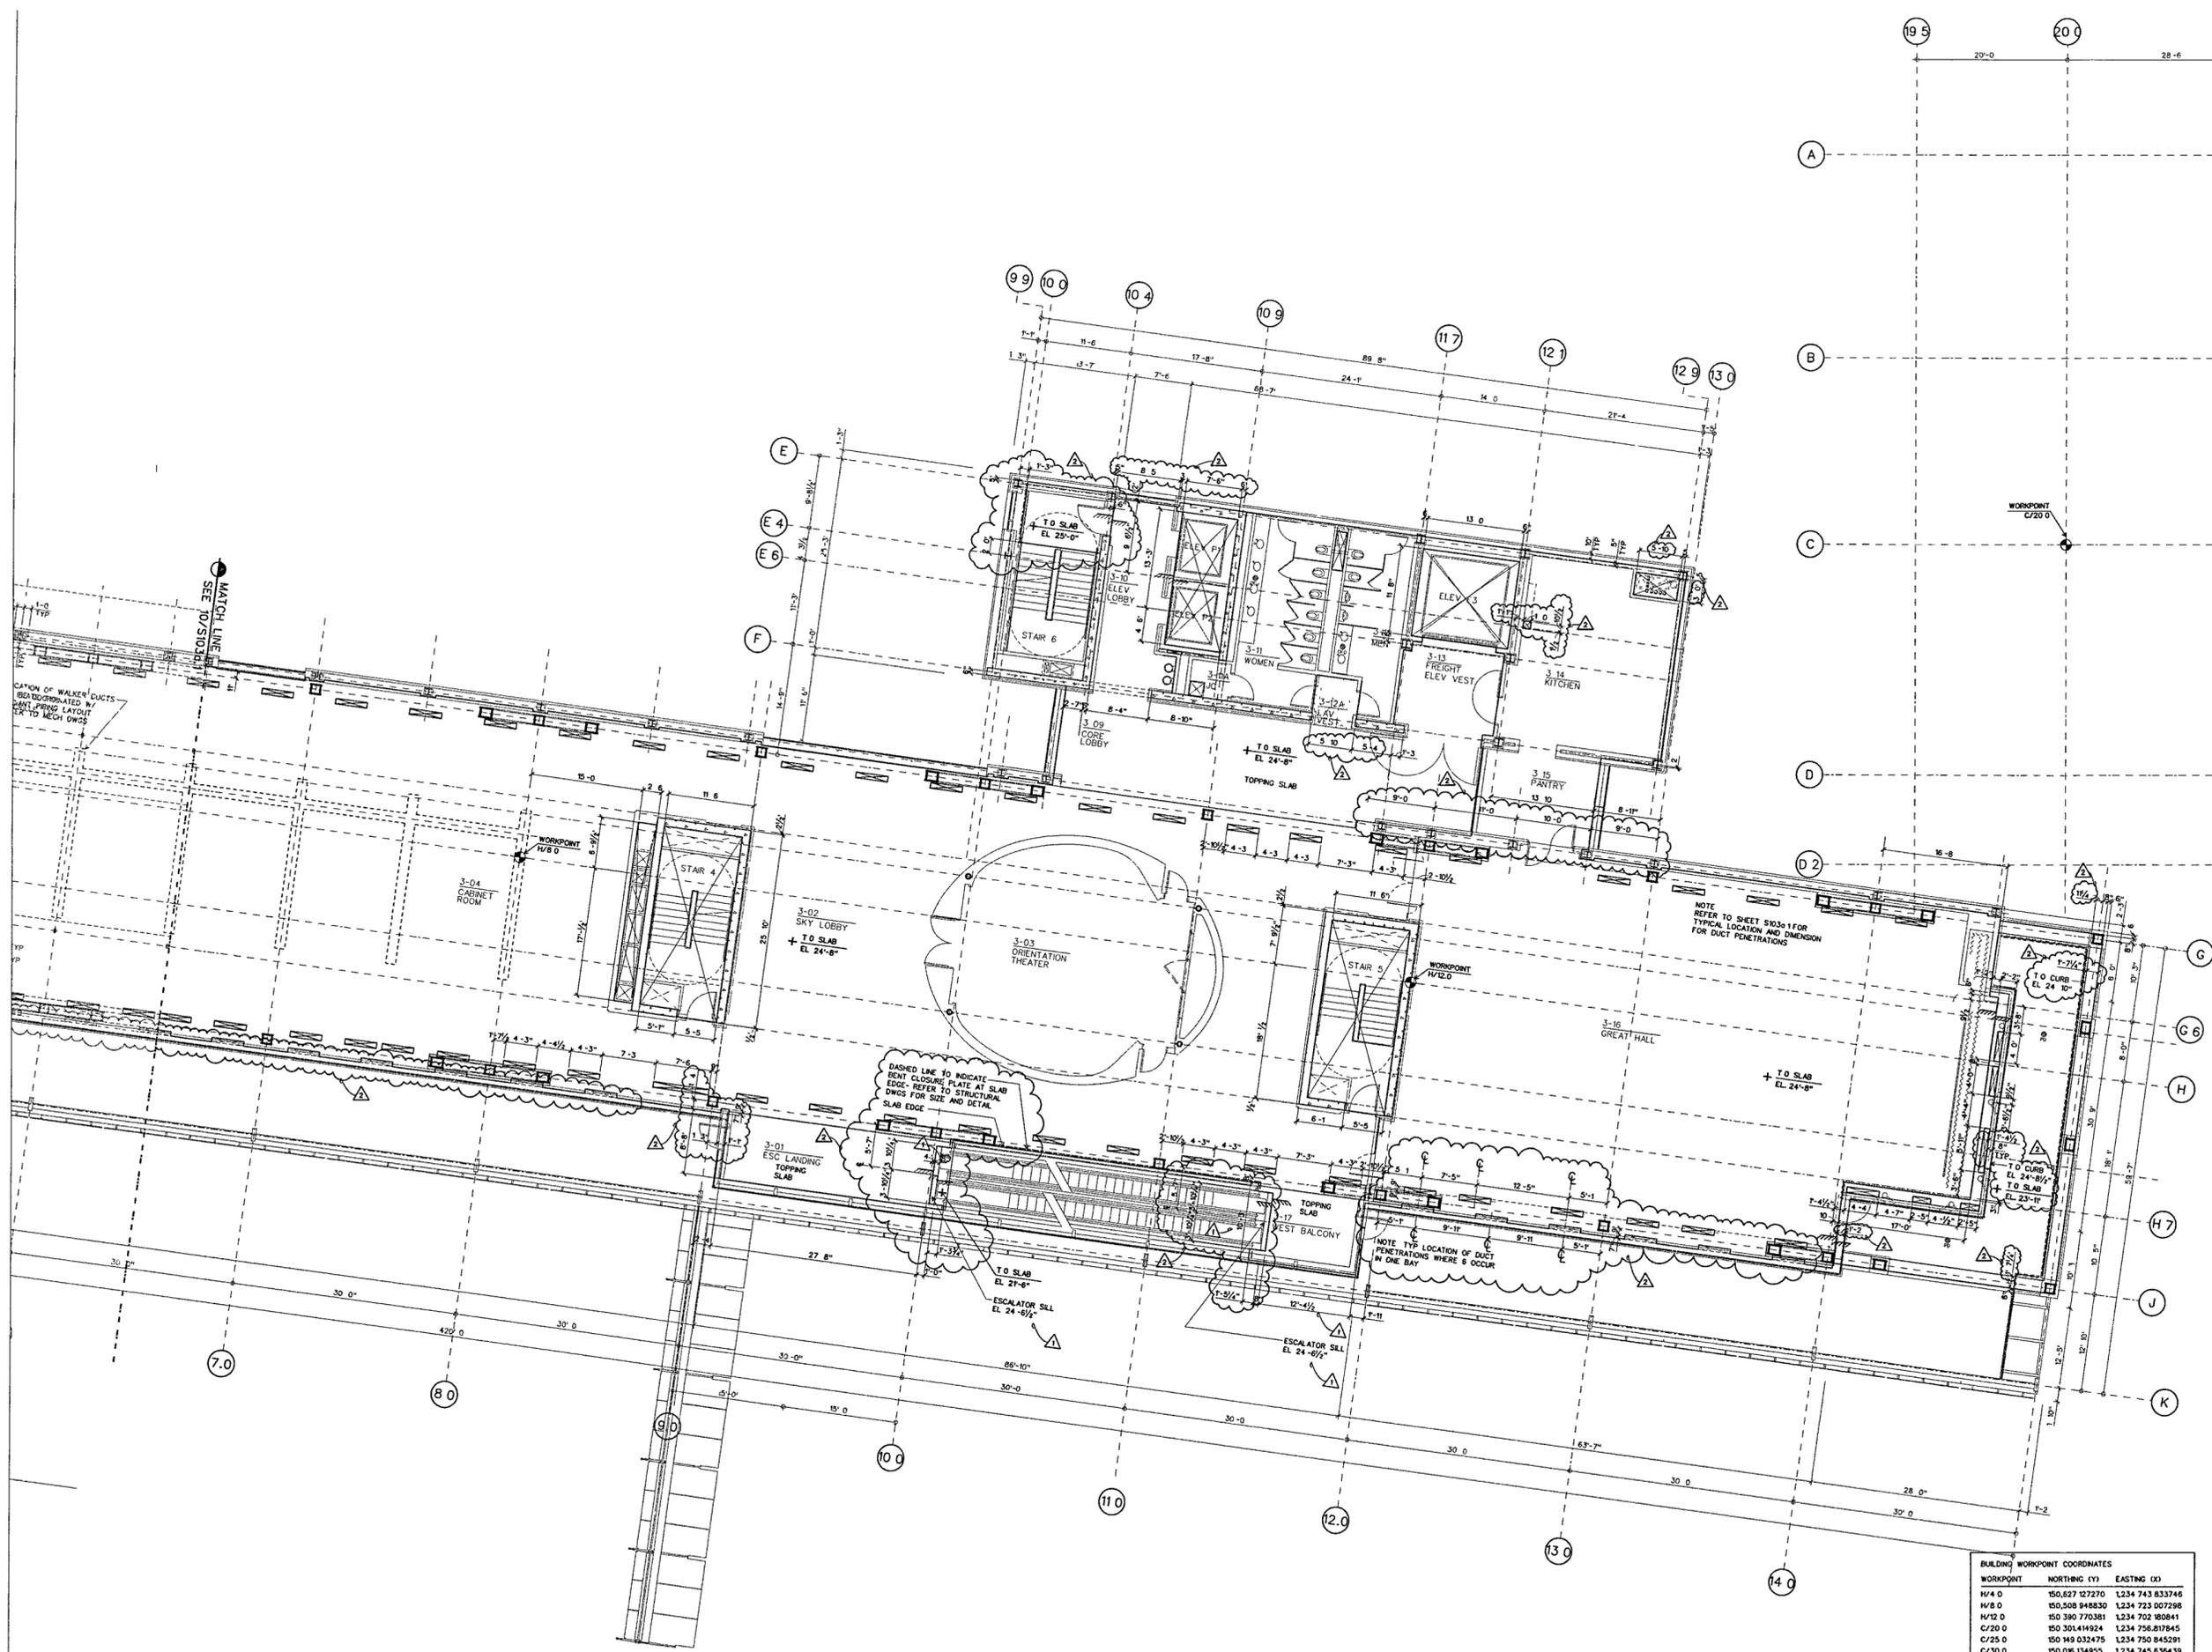

MUSEUM LOWER LEVEL SLAB PLAN B

SCALE 1/8" = 1'-0"

SLAB-03 DGN

10

FOR OFFICIAL USE ONLY