

**WILLIAM J CLINTON
PRESIDENTIAL
CENTER**

LITTLE ROCK, ARKANSAS

Architect
POLSHEK PARTNERSHIP LLP
 320 West 13th Street
 New York, New York 10014
 212 807 7171

Coordinating Architects
POLK STANLEY YEARY ARCHITECTS LTD
 700 South Schiller Street
 Little Rock, Arkansas 72201
 501 578.0875

WITSELL EVANS RASCO
 901 West Third Street
 Little Rock, Arkansas 72201
 501 374 5300

WOODS CARADINE ARCHITECTS
 2200 South Main Street
 Little Rock, Arkansas 72206
 501 374 4060

Landscape Architects
HARGREAVES ASSOCIATES
 118 Magazine Street
 Cambridge, Massachusetts 02139
 617 861 0070


Landscape Architecture Inc.
 2300 Cottondale Lane Suite 202
 Little Rock, Arkansas 72202
 501.374.5910

Structural Engineer
LESLIE E. ROBERTSON ASSOC. RLLP
 30 Broad Street, 47th Floor
 New York, New York 10004
 212 750 9000


MEP Engineers
FLACK + KURTZ Inc.
 475 Fifth Avenue
 New York, New York 10017
 212 532 9900

CROMWELL ARCHITECTS ENGINEERS
 101 South Spring Street
 Little Rock, Arkansas 72201
 501 372.2900

Curtainwall Consultant
R. A. HEINTGES ARCHITECTS
 128 Fifth Avenue 9th Floor
 New York, New York 10011
 212 652-2966

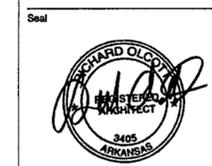

100% Construction Documents	09/27/02
90% Progress Printing	08/30/02
100% Struct./CD Progress	07/01/02
100% Steel & Concrete CD	05/15/02
& Architectural CD Progress	
Issue	Date
*Issued originally as A7D4b	

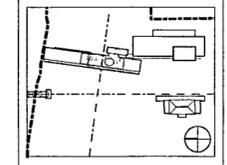

Job No. 9908


Scale 1/8" = 1'-0"

Date September 27, 2002

Title
**MUSEUM
 UPPER LEVEL
 PARTIAL SLAB PLAN**

Sheet No.
S104b.1

WORKPOINT	NORTHING (Y)	EASTING (X)
H/4 0	150,627 127270	1234 743 833746
H/8 0	150 506 948830	1234 723 007298
H/12 0	150 390 7703381	1234 702 808841
C/20 0	150,301 414924	1234 756 817845
C/25 0	150 149 032475	1234 750 845291
C/30 0	150 076 134955	1234 745 636439

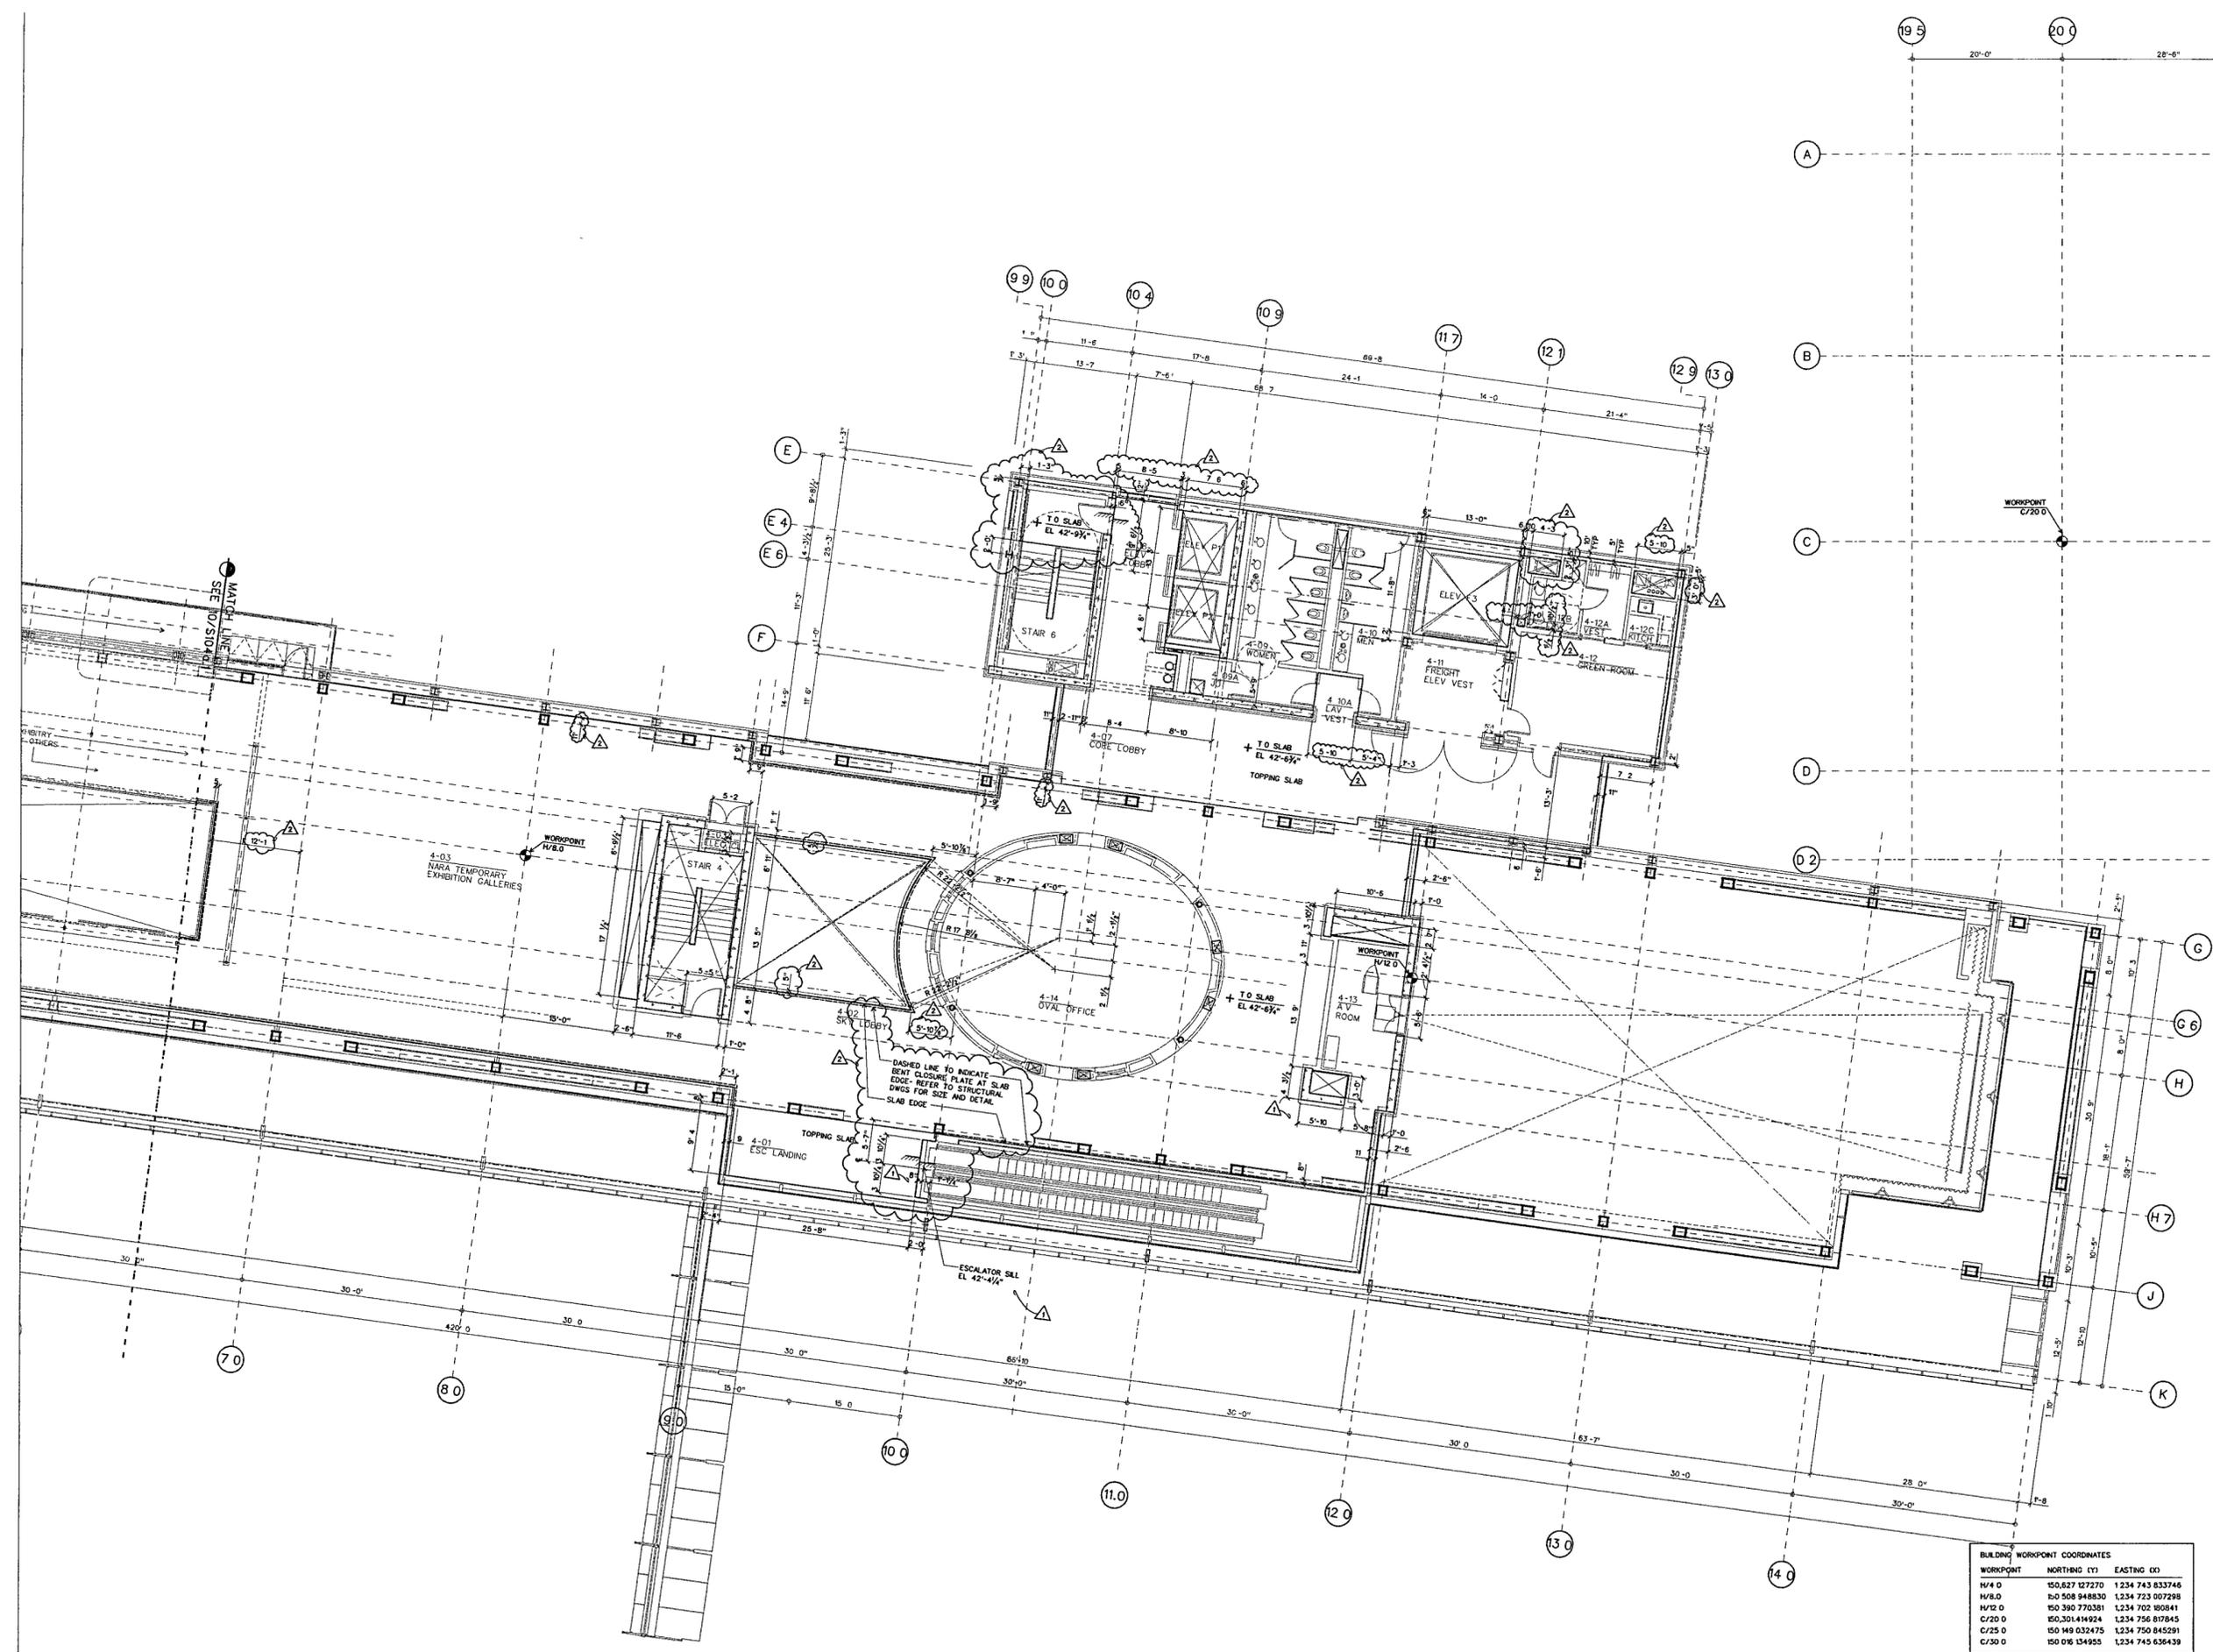

MUSEUM UPPER LEVEL SLAB PLAN B
 SCALE 1/8" = 1'-0"

SLAB-04 DGN 10

FOR OFFICIAL USE ONLY