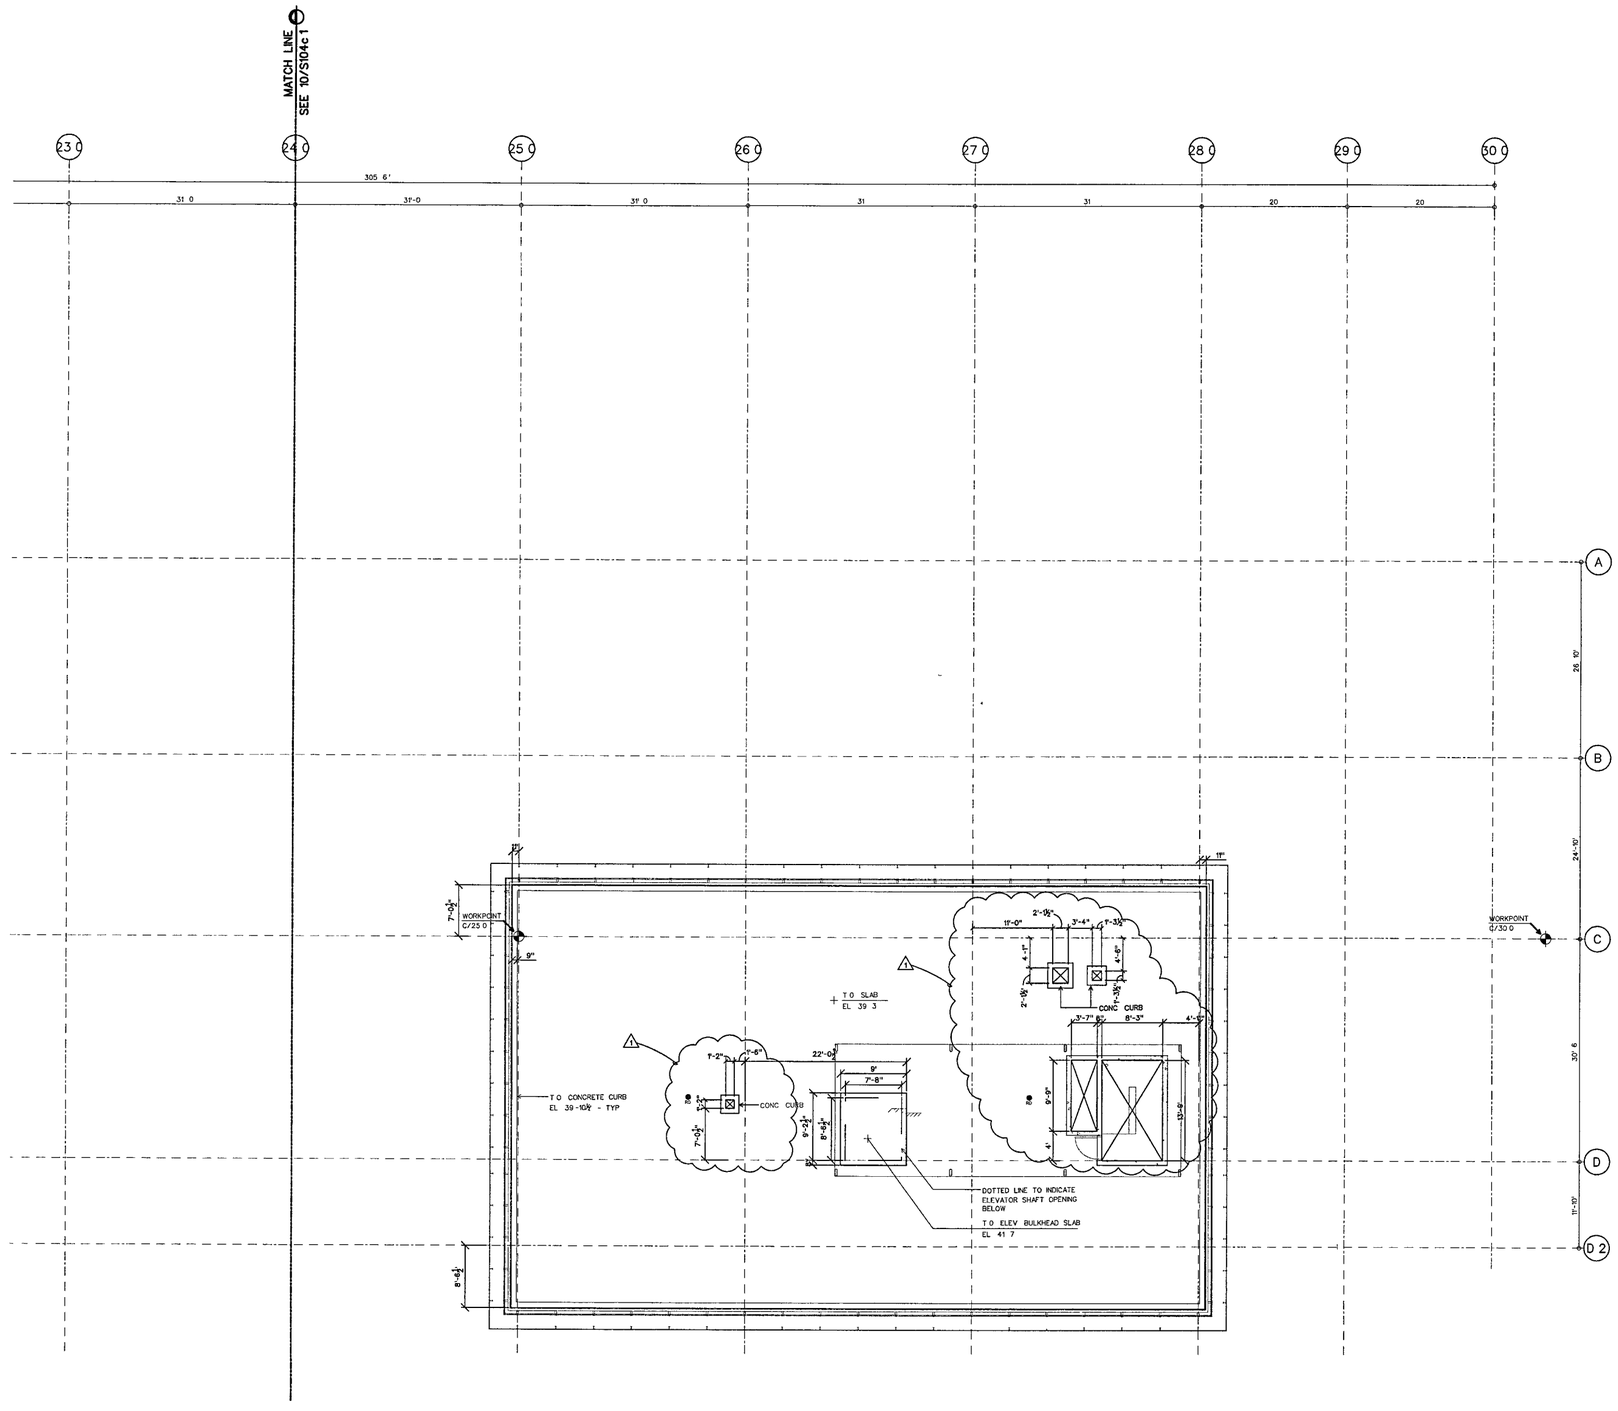

BUILDING WORKPOINT COORDINATES		
WORKPOINT	NORTHING (Y)	EASTING (X)
H/4 0	150,627 127270	1,234,743 833746
H/8 0	150,508 948830	1,234,723 007298
H/12 0	150,390 770381	1,234,702 180841
C/20 0	150,301 414924	1,234,756 817845
C/25 0	150,149 032475	1,234,750 845291
C/30 0	150,016 134955	1,234,745 636439

FOURTH LEVEL SLAB PLAN D

SCALE 1/8" = 1'-0"

10

WILLIAM J. CLINTON PRESIDENTIAL CENTER

LITTLE ROCK, ARKANSAS

Architect

POLSHEK PARTNERSHIP LLP
320 West 13th Street
New York New York 10014
212 807 7171

Coordinating Architects

POLK STANLEY YEARY ARCHITECTS Ltd
700 South Schiller Street
Little Rock Arkansas 72201
501 378 0878

WITSELL EVANS RASCO
901 West Third Street
Little Rock Arkansas 72201
501 374 5300

WOODS CARADINE ARCHITECTS
2200 South Main Street
Little Rock Arkansas 72206
501 374 4060

Landscape Architects

HARGREAVES ASSOCIATES
118 Magazine Street
Cambridge, Massachusettes 02139
617 661 0070

LANDSCAPE ARCHITECTURE Inc.
2300 Cottondale Lane Suite 202
Little Rock Arkansas 72202
501 374 5610

Structural Engineer

LESLIE E ROBERTSON ASSOC , RLLP
30 Broad Street, 47th Floor
New York, New York 10004
212 750 9000

MEP Engineers

FLACK + KURTZ Inc
475 Fifth Avenue
New York New York 10017
212 532 9600

CROMWELL ARCHITECTS ENGINEERS
101 South Spring Street
Little Rock Arkansas 72201
501 372.2900

Curtainwall Consultant

R A. HEINTGES ARCHITECTS
126 Fifth Avenue, 9th Floor
New York, New York 10011
212 652-2966

Seal

WITSELL EVANS & RASCO P.A.
REGISTERED ARCHITECTS
NO C44
ARKANSAS

Issue		Date
1	100% Construction Documents	09/27/02
	90% Progress Printing	08/30/02
	100% Struct./CD Progress	07/01/02
	100% Steel & Concrete CD & Architectural CD Progress	05/15/02
	100% Design Development	03/01/02

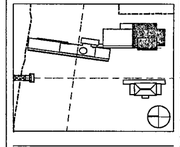

Job No
9908

Scale
1/8" = 1'-0"

Date
September 27 2002

Title

FOURTH LEVEL
PARTIAL SLAB PLAN

Sheet No

S104d.1

FOR OFFICIAL USE ONLY