

**WILLIAM J CLINTON
PRESIDENTIAL
CENTER**

LITTLE ROCK, ARKANSAS

Architect
POLSHEK PARTNERSHIP LLP
320 West 13th Street
New York New York 10014
212 607 7171

Coordinating Architects
POLK STANLEY YEARY ARCHITECTS Ltd
700 South Schiller Street
Little Rock, Arkansas 72201
501 378 0878

WITSELL EVANS RASCO
901 West Thed Street
Little Rock, Arkansas 72201
501 374 5300

WOODS CARADINE ARCHITECTS
2200 South Main Street
Little Rock, Arkansas 72206
501 374 4060

Landscape Architects
HARGREAVES ASSOCIATES
118 Magazine Street
Cambridge, Massachusetts 02139
617 661 0070

LANDSCAPE ARCHITECTURE Inc.
2300 Cottage Lane Suite 202
Little Rock, Arkansas 72202
501 374 5810

Structural Engineer
LESLIE E. ROBERTSON ASSOC., RLLP
30 Broad Street, 47th Floor
New York, New York 10004
212.750.9000


MEP Engineers
FLACK + KURTZ Inc.
475 Fifth Avenue
New York, New York 10017
212.532.9500

CROMWELL ARCHITECTS ENGINEERS
101 South Spring Street
Little Rock, Arkansas 72201
501 372.2900

Curtainwall Consultant
R. A. HEINTGES ARCHITECTS
128 Fifth Avenue, 6th Floor
New York, New York 10011
212.652.2966




100% Construction Documents	06/27/02
90% Progress Printing	08/30/02
100% Struct./CD Progress	07/01/02
100% Steel & Concrete CD	05/15/02
& Architectural CD Progress	
Issue	Date
Issued originally as A705b	

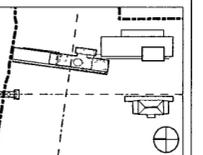

Job No 8908
Scale 1/8" = 1'-0"
Date September 27, 2002
Title

**EXECUTIVE LEVEL
PARTIAL SLAB PLAN**

Sheet No
S105b.1

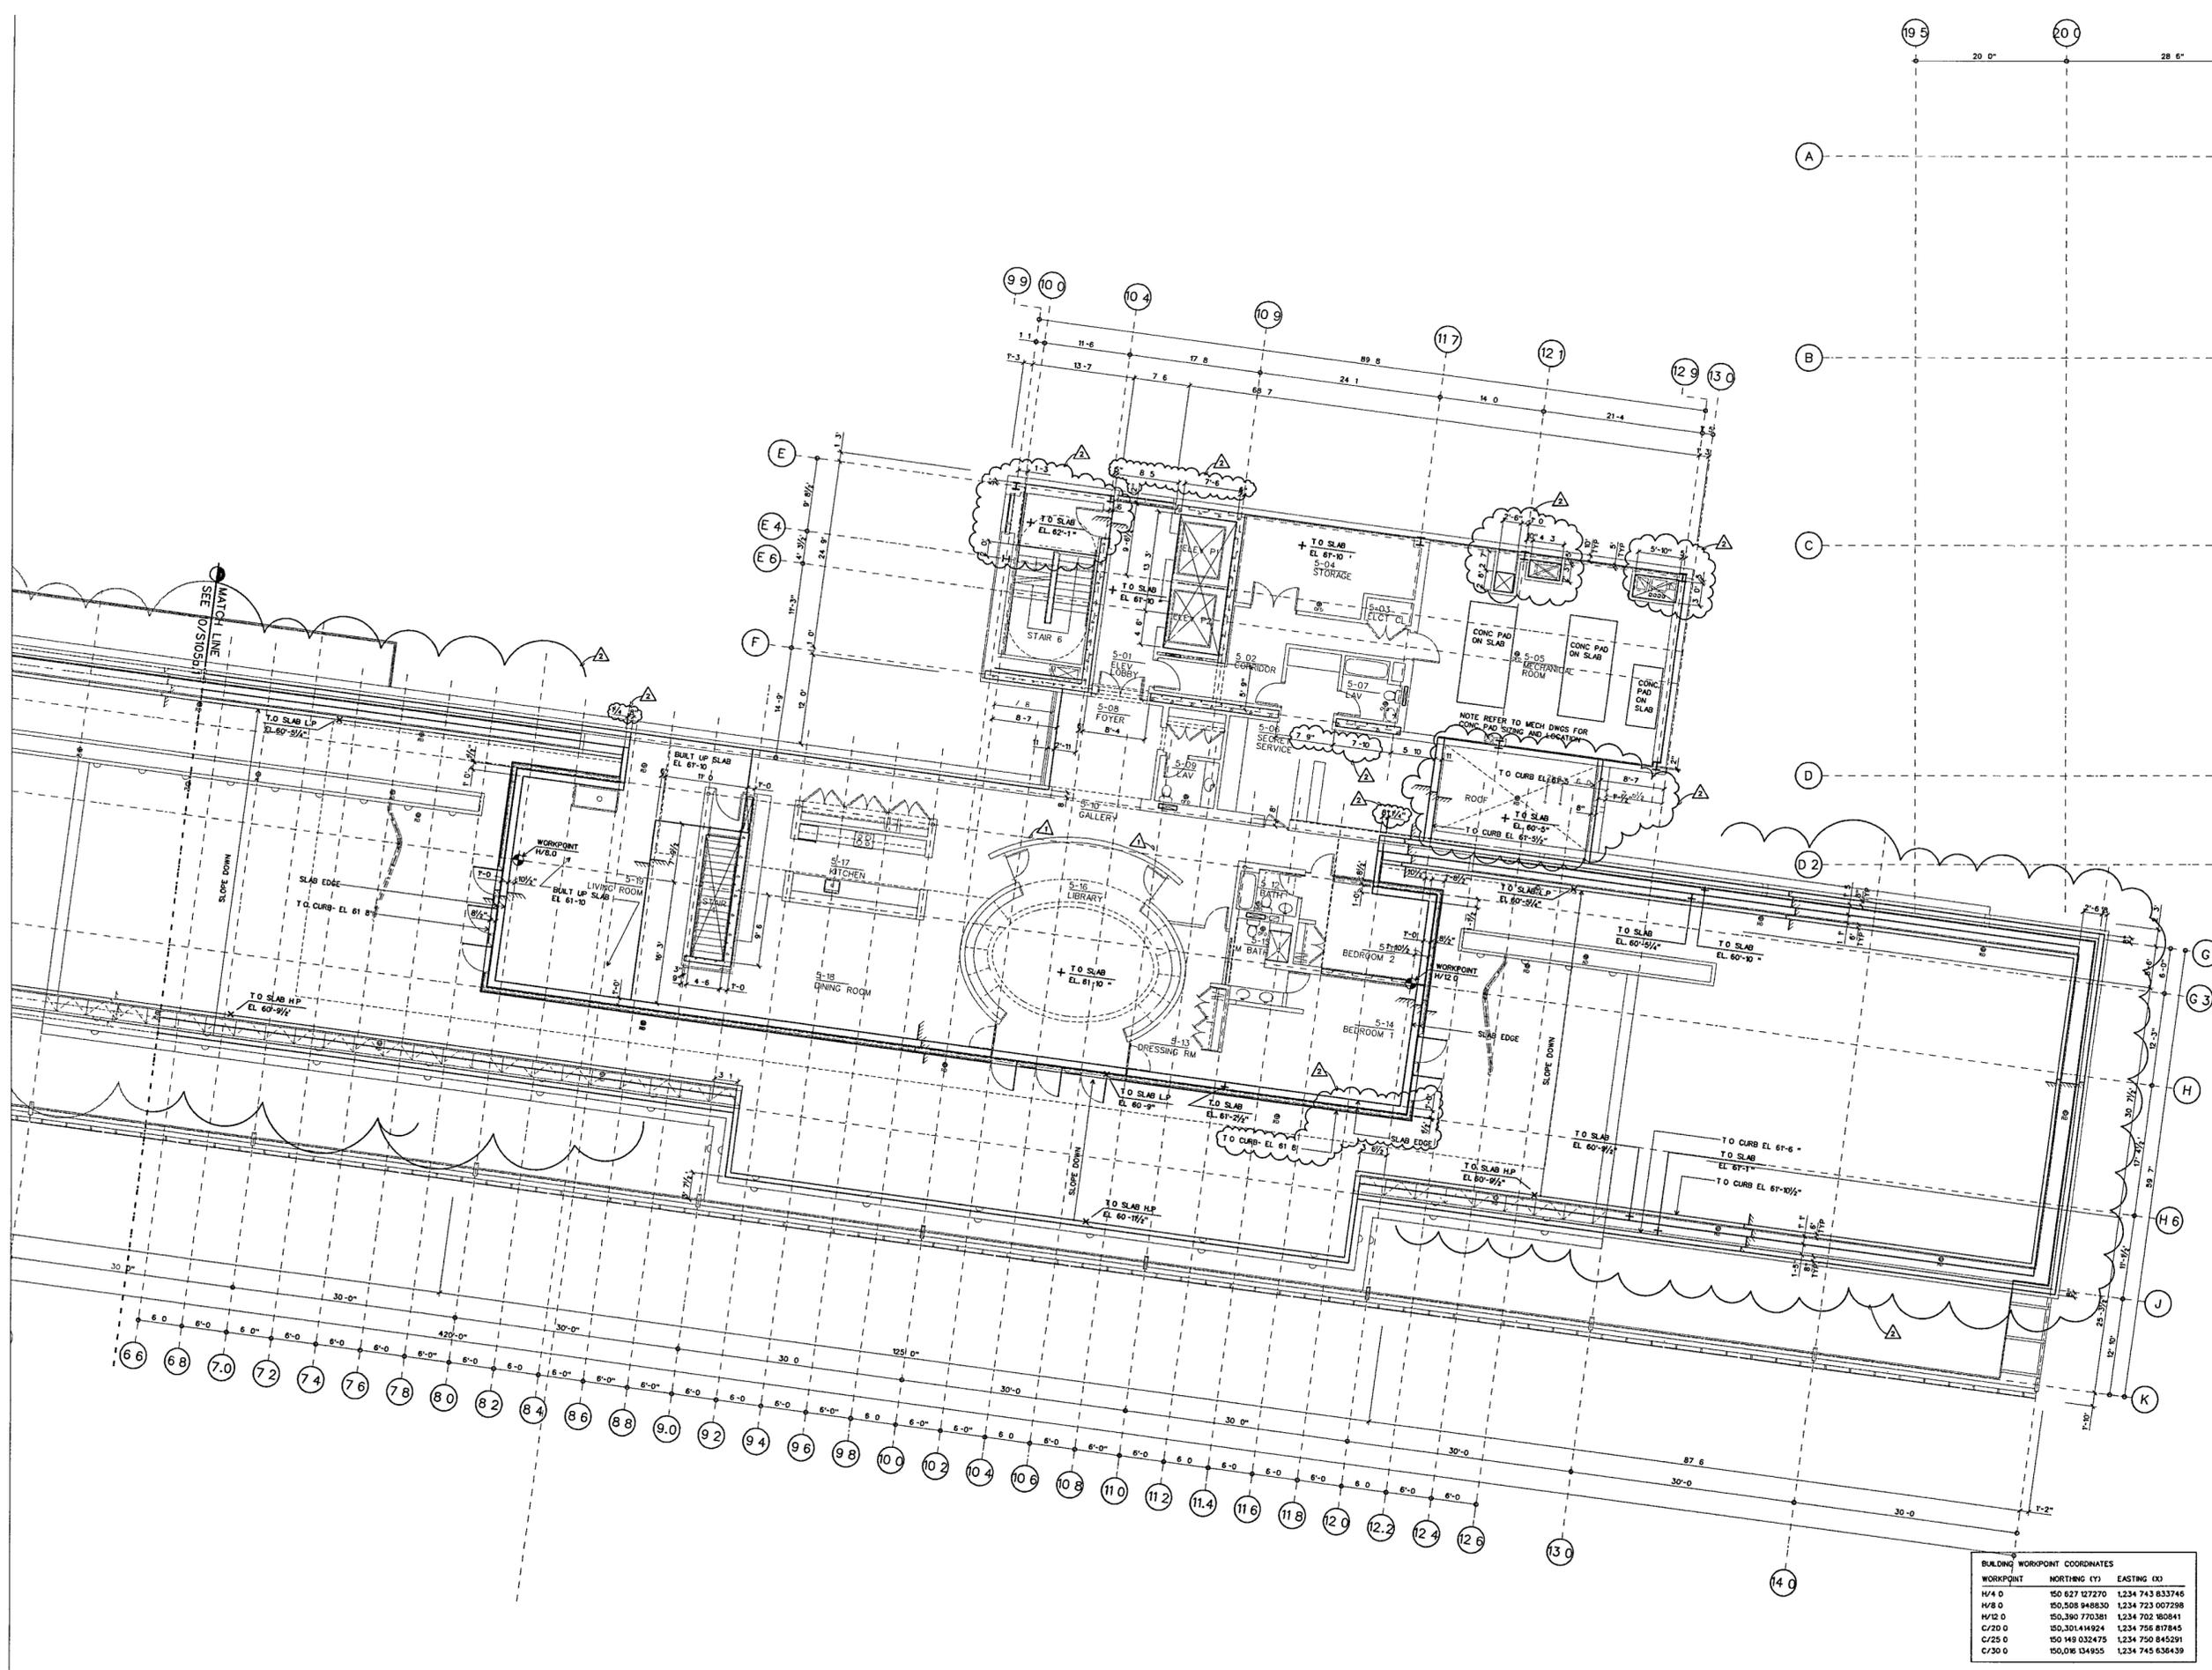

BUILDING WORKPOINT COORDINATES

WORKPOINT	NORTHING (Y)	EASTING (X)
H/4 0	150,627,127270	1,234,743,833746
H/8 0	150,508,948630	1,234,723,007298
H/12 0	150,390,770381	1,234,702,80841
C/20 0	150,301,414924	1,234,756,817845
C/25 0	150,149,032475	1,234,750,845291
C/30 0	150,016,134955	1,234,745,636439

EXECUTIVE LEVEL SLAB PLAN B
SCALE 1/8" = 1'-0"

SLAB-05 DGN 10

FOR OFFICIAL USE ONLY