

**WILLIAM J CLINTON
PRESIDENTIAL
CENTER**

LITTLE ROCK, ARKANSAS

Architect

POLSHEK PARTNERSHIP LLP
320 West 13th Street
New York, New York 10014
212.807.7171

Coordinating Architects

POLK STANLEY YEARY ARCHITECTS Ltd
700 South Schiller Street
Little Rock, Arkansas 72201
501.378.0878

WITSELL EVANS RASCO
901 West Third Street
Little Rock, Arkansas 72201
501.374.5300

WOODS CARADINE ARCHITECTS
2200 South Main Street
Little Rock, Arkansas 72206
501.374.4080

Landscape Architects

HARGREAVES ASSOCIATES
118 Magazine Street
Cambridge, Massachusetts 02139
617.861.0070

LANDSCAPE ARCHITECTURE, Inc.
2300 Cottondale Lane Suite 202
Little Rock, Arkansas 72202
501.374.5610

Structural Engineer

LESLIE E. ROBERTSON ASSOC., RLLP
30 Broad Street, 47th Floor
New York, New York 10004
212.750.9000

MEP Engineers

FLACK + KURTZ Inc.
475 Fifth Avenue
New York, New York 10017
212.532.9600

CROMWELL ARCHITECTS ENGINEERS

101 South Spring Street
Little Rock, Arkansas 72201
501.372.2900


Curtainwall Consultant

R. A. HEINTGES ARCHITECTS
126 Fifth Avenue, 9th Floor
New York, New York 10011
212.852.2965

Seal



1 100% CONSTRUCTION DOCS 09/27/02
0 90% PROGRESS PRINTING 08/30/02
Issue Date

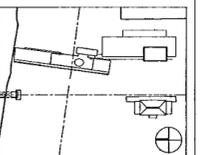


Job No 9908
Scale 1/16"=1'-0"
Date AUG 30, 2002
Title

**EAST WALL
ELEVATION**



Sheet No

S205

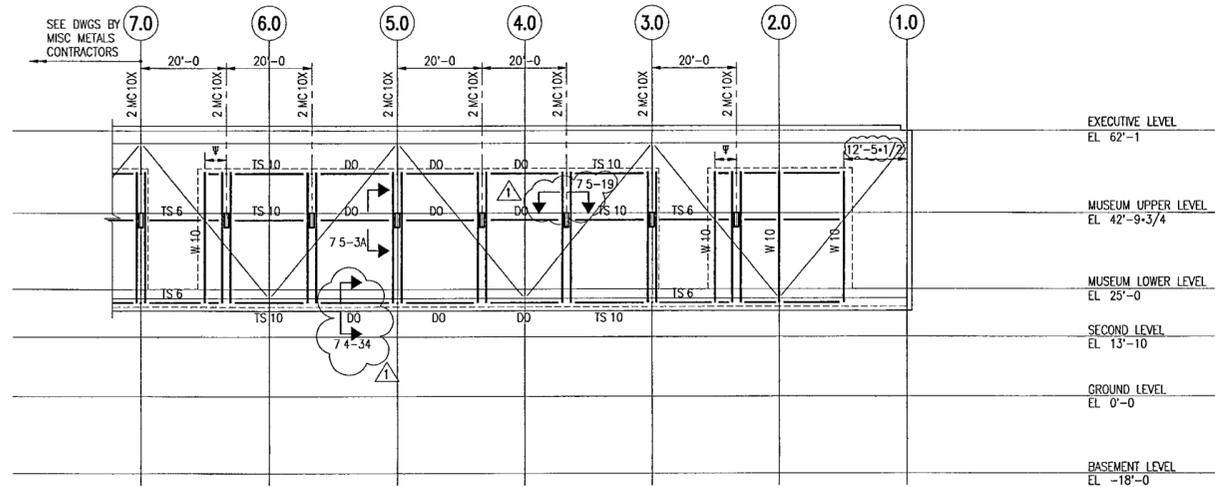

A EAST WALL ELEVATION

LOOKING WEST, ALL STEEL IN
THIS ELEVATION IS PAINTED W/
ZINC RICH PRIMER

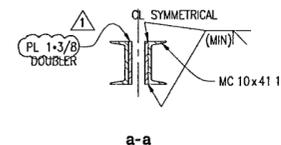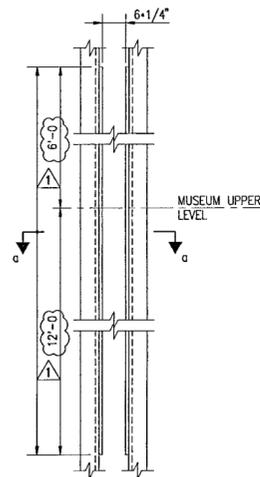

B TYPICAL 2 MC10

SCALE 3/4" = 1'-0"

© Copyright LESLIE E. ROBERTSON ASSOCIATES, R.L.L.P.
WARNING IT IS A VIOLATION OF LAW FOR
ANY PERSON, UNLESS ACTING UNDER THE DIRECTION
OF A PROFESSIONAL, LICENSED IN THE STATE OF THIS
PROJECT, TO ALTER IN ANY WAY THESE DRAWINGS
WHERE ANY ITEM IS ALTERED THE SUPERVISING
PROFESSIONAL SHALL AFFIX TO THE ITEM HIS SEAL
AND THE INSCRIPTION "ALTERED BY" FOLLOWED BY
HIS SIGNATURE, THE DATE, AND A SPECIFIC
DESCRIPTION OF THE ALTERATION.