

**WILLIAM J. CLINTON
PRESIDENTIAL
CENTER**

LITTLE ROCK, ARKANSAS

Architect

POLSHEK PARTNERSHIP LLP
320 West 13th Street
New York, New York 10014
212.807.7171

Coordinating Architects

POLK STANLEY YEARY ARCHITECTS LTD
700 South Schiller Street
Little Rock, Arkansas 72201
501.378.0878

WITSELL EVANS RASCO
901 West Third Street
Little Rock, Arkansas 72201
501.374.5300

WOODS CARADINE ARCHITECTS
2200 South Main Street
Little Rock, Arkansas 72206
501.374.4060

Landscape Architects

HARGREAVES ASSOCIATES
118 Magazine Street
Cambridge, Massachusetts 02139
617.661.0070

LANDSCAPE ARCHITECTURE Inc.
2300 Cottondale Lane Suite 202
Little Rock, Arkansas 72202
501.374.5510

Structural Engineer

LESLIE E. ROBERTSON ASSOC. RLLP
30 Broad Street, 47th Floor
New York, New York 10004
212.750.9000

MEP Engineers

FLACK + KURTZ Inc.
475 Fifth Avenue
New York, New York 10017
212.532.9600

CROMWELL ARCHITECTS ENGINEERS


101 South Spring Street
Little Rock, Arkansas 72201
501.372.2900

Curtainwall Consultant

R.A. HEINTGES ARCHITECTS
128 Fifth Avenue, 9th Floor
New York, New York 10011
212.652-2966

Seal

7	100% CONSTRUCTION DOCS	09/27/02
6	90% PROGRESS PRINTING	08/30/02
5	SFS-12	08/20/02
4	SFS-5 (REF #10)	08/02/02
3	100% STRUCTURAL CD	07/01/02
2	100% CD MUSEUM BLDG	06/14/02
SUBSTRUCTURE PACKAGE		
1	100% STL & CONC CD	05/15/02
Issue	Date	

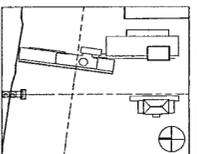


Job No. 9908

Scale 1/8"=1'-0"

Date MAY 15, 2002

Title **WALL ELEVATIONS
MUSEUM BUILDING**

Sheet No. **S221**

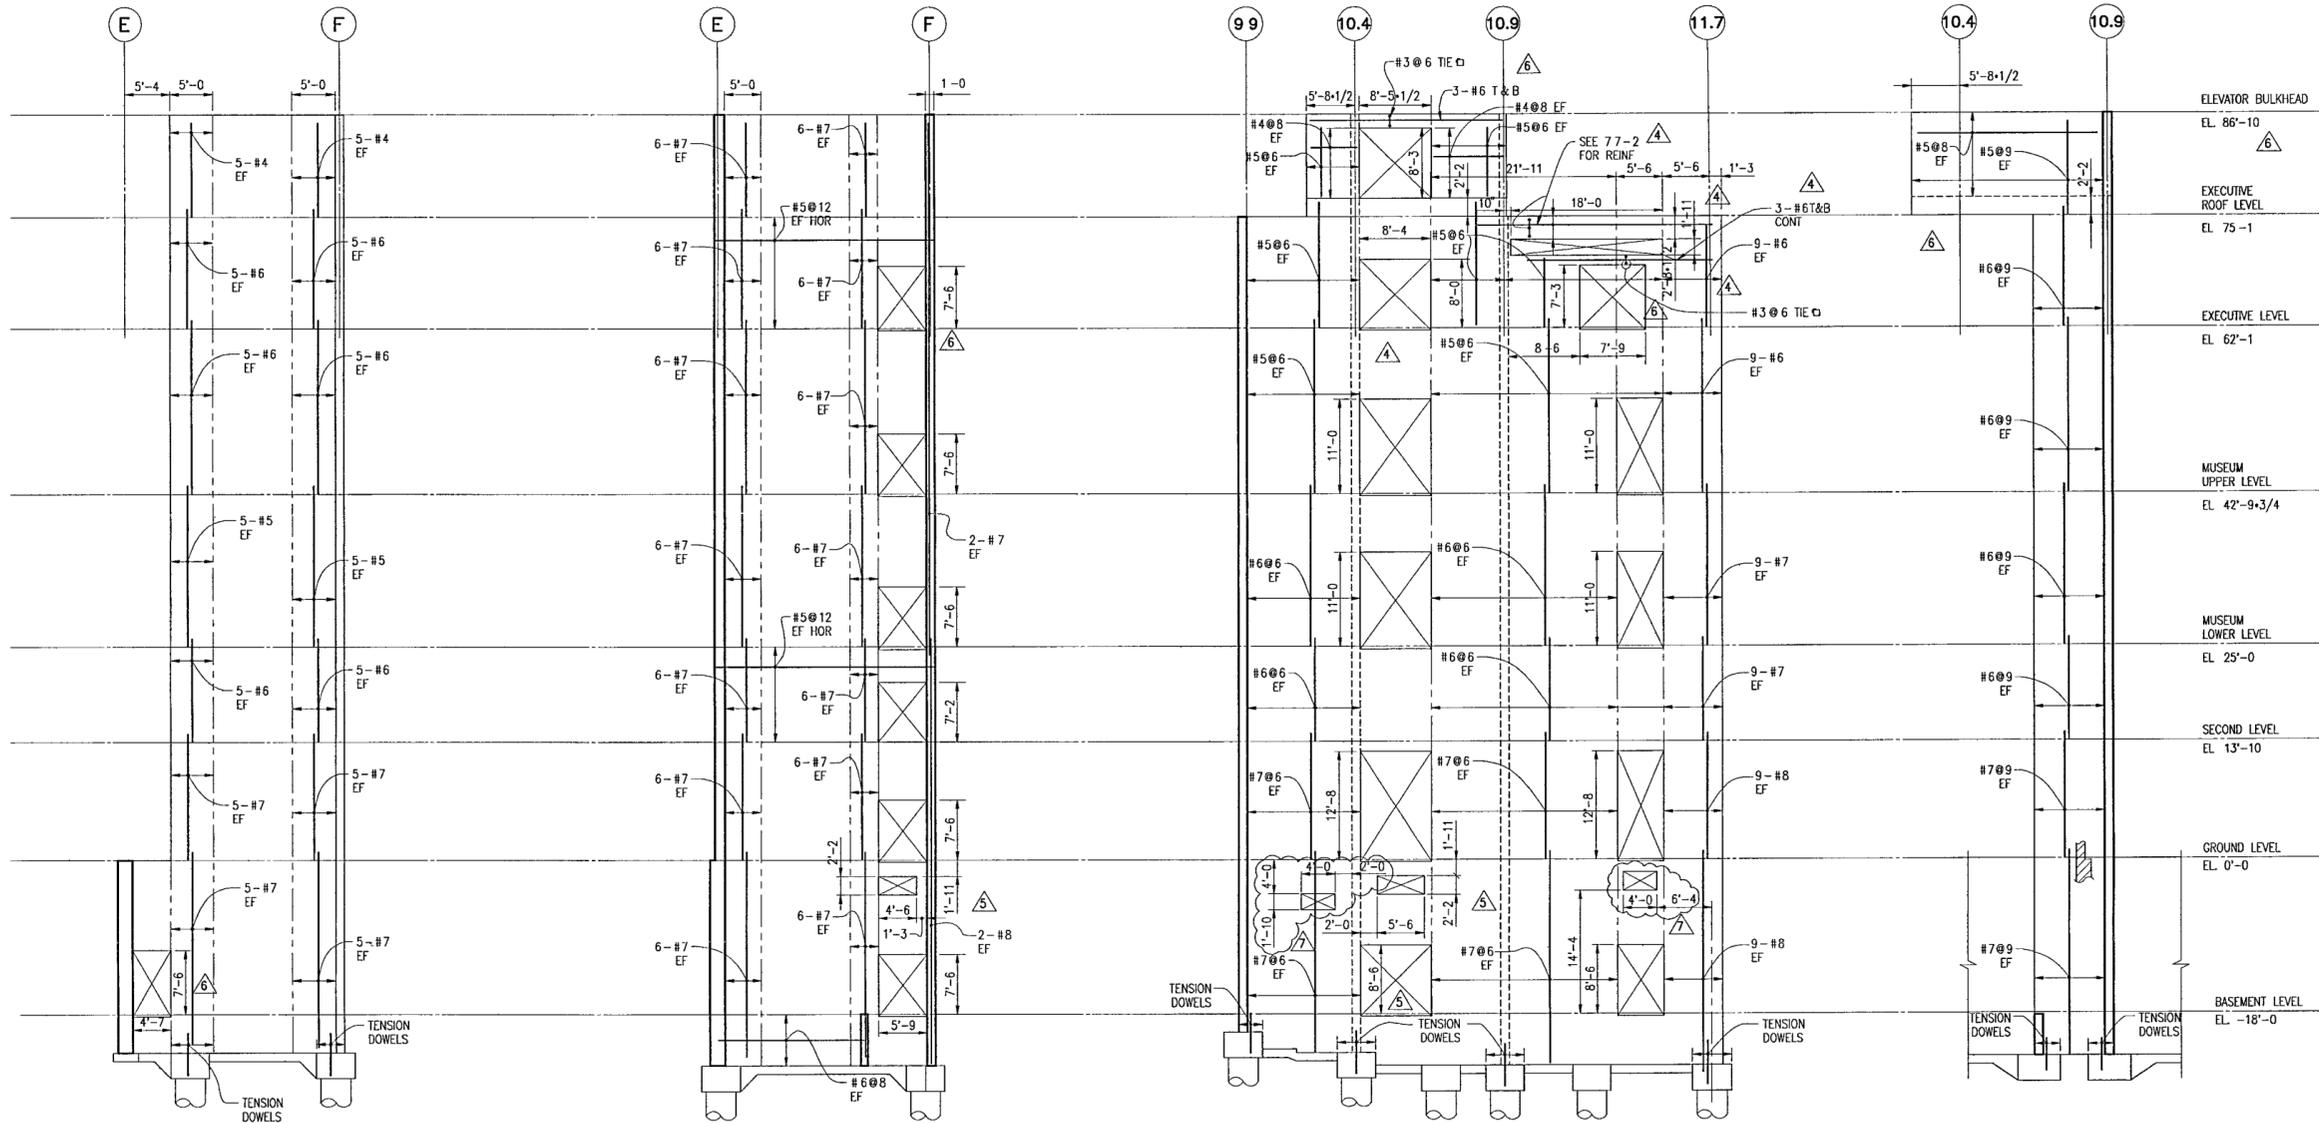

A WALL @ GRID 10.4

B WALL @ GRID 10.9

C WALL @ GRID F

D WALL @ GRID E

NOTES

- REFER TO THE STRUCTURAL DRAWING BOOK FOR GENERAL NOTES, TYPICAL DETAILS, SCHEDULES AND ALL REFERENCED DETAILS AND SECTIONS
- PROVIDE MIN VERTICAL AND HORIZONTAL REINFORCEMENTS UNLESS OTHERWISE NOTED SHOWN
- PROVIDE MIN WALL DOWELS AT WALL FOOTINGS UON
- AT COLUMN FOOTINGS AND CAISSON CAPS PROVIDE DOWELS TO MATCH WALL VERTICALS WHERE TENSION DOWELS ARE NOTED PROVIDE LD EMBEDMENT IN FOOTING OR CAP AND 1.3 LD LAP SPICE IN WALL. HOOK DOWELS IN FOOTING AS REQUIRED
- SEE SECTIONS AND DETAILS FOR REINFORCEMENT IN ELEVATOR PIT WALLS

© Copyright LESLIE E. ROBERTSON ASSOCIATES R.L.L.P.
WARNING IT IS A VIOLATION OF LAW FOR ANY PERSON UNLESS ACTING UNDER THE DIRECTION OF A PROFESSIONAL LICENSED IN THE STATE OF THIS PROJECT TO ALTER IN ANY WAY THESE DRAWINGS WHERE ANY ITEM IS ALTERED, THE SUPERVISING PROFESSIONAL SHALL AFFIX TO THE ITEM HIS SEAL AND THE INSCRIPTION "ALTERED BY" FOLLOWED BY HIS SIGNATURE, THE DATE, AND A SPECIFIC DESCRIPTION OF THE ALTERATION