



Seal


Issue	Date
4	100% CONSTRUCTION DOCS 09/27/02
3	90% PROGRESS PRINTING 08/30/02
2	100% STRUCTURAL CD 07/01/02
1	100% STL & CONC CD 05/15/02

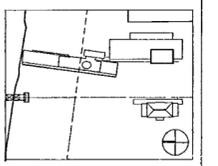

Job No.	9908
Scale	1/8"=1'-0"
Date	DEC 11, 2001
Title	WALL ELEVATIONS ARCHIVE BUILDING
Sheet No.	S222

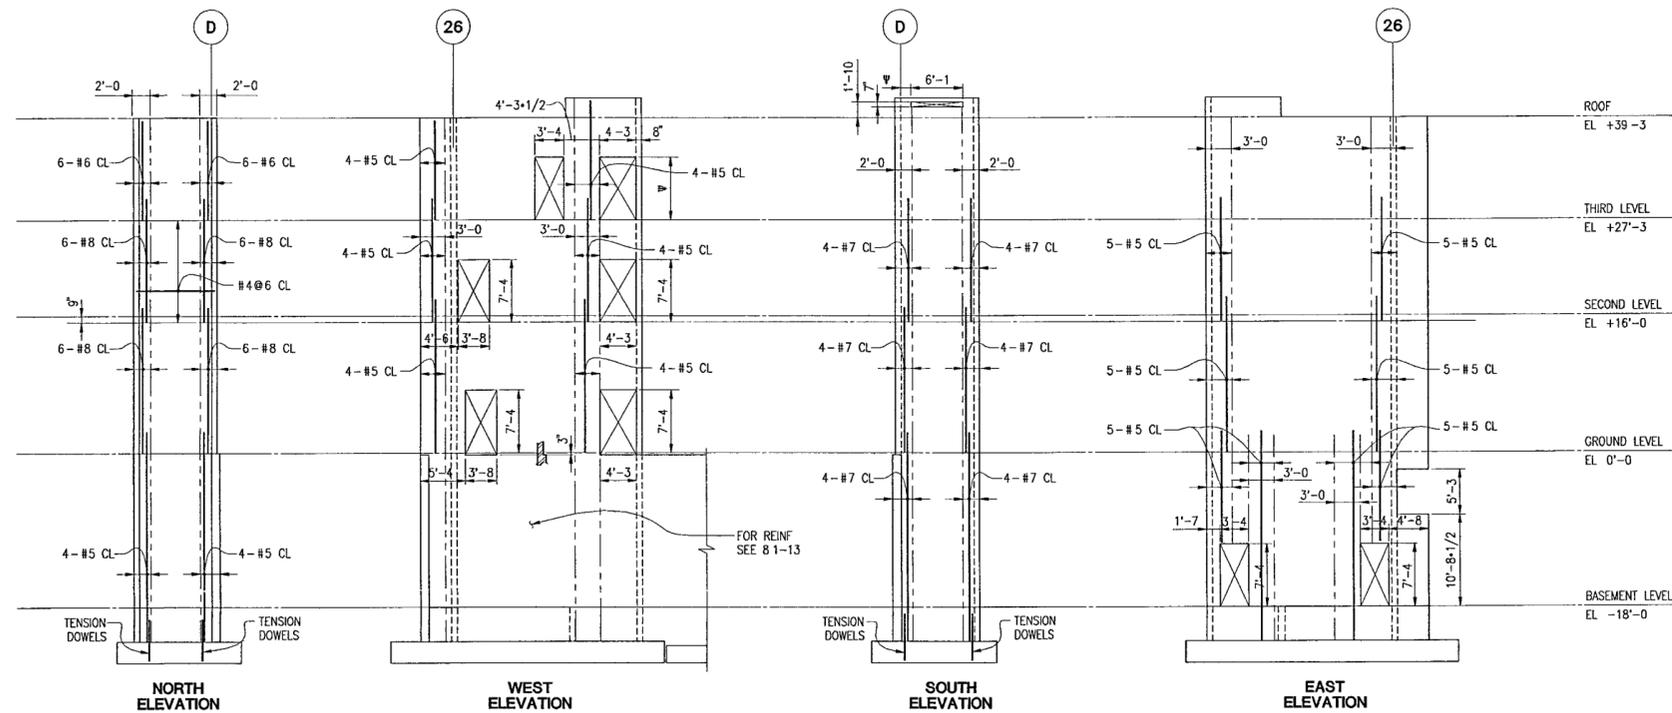

A WALL @ STAIR 10

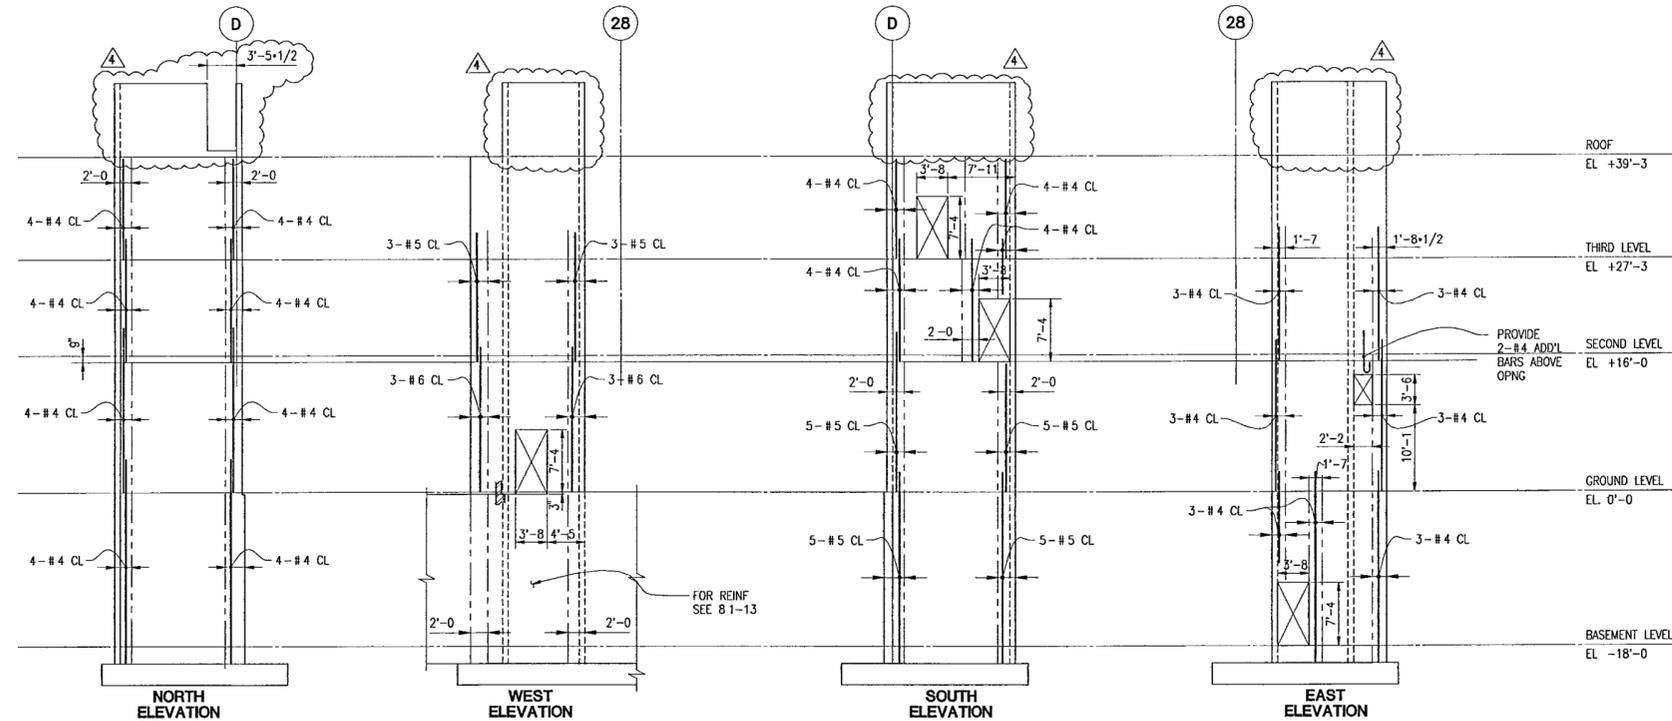

B WALL @ STAIR 11

NOTES.

- REFER TO THE STRUCTURAL DRAWING BOOK FOR GENERAL NOTES, TYPICAL DETAILS, SCHEDULES AND ALL REFERENCED DETAILS AND SECTIONS
- PROVIDE MIN VERTICAL AND HORIZONTAL REINFORCEMENTS UNLESS OTHERWISE SHOWN
- PROVIDE MIN WALL DOWELS AT WALL FOOTINGS UNON
- AT COLUMN FOOTINGS AND CAISSON CAPS PROVIDE DOWELS TO MATCH WALL VERTICALS WHERE TENSION DOWELS ARE NOTED PROVIDE LD EMBEDMENT IN FOOTING OR CAP AND 1.3 LD LAP SPLICE IN WALL HOOK DOWELS IN FOOTING AS REQUIRED
- SEE SECTIONS AND DETAILS FOR REINFORCEMENT IN ELEVATOR PIT WALLS

© Copyright LESLIE E. ROBERTSON ASSOCIATES, RLLP
WARNING IT IS A VIOLATION OF LAW FOR ANY PERSON UNLESS ACTING UNDER THE DIRECTION OF A PROFESSIONAL LICENSED IN THE STATE OF THIS PROJECT, TO ALTER IN ANY WAY THESE DRAWINGS WHERE ANY ITEM IS ALTERED. THE SUPERVISING PROFESSIONAL SHALL AFFIX TO THE ITEM HIS SEAL AND THE INSCRIPTION ALTERED BY FOLLOWED BY HIS SIGNATURE, THE DATE, AND A SPECIFIC DESCRIPTION OF THE ALTERATION.