

MATCH LINE - WEST END  
MATCH LINE - EAST END

MATCH LINE - WEST END  
MATCH LINE - EAST END

1 FIRST FLOOR SYSTEMS PLAN - EAST END  
NOT TO SCALE




Advanced Cabling Systems Services  
NOTE: THESE DRAWINGS ARE BASED ON THE PROJECT ARCHITECT/ENGINEER'S (A/E) PLANS AND SPECIFICATIONS. ADVANCED CABLING SYSTEMS (ACS) IS NOT RESPONSIBLE FOR THE TYPE, SIZE, LOCATION, AND OTHER DETAILS SHOWN ON THE A/E PLANS. ACS IS RESPONSIBLE FOR THE INFORMATION SHOWN ON THE A/E PLANS. ACS IS NOT RESPONSIBLE FOR THE INFORMATION SHOWN ON THE A/E PLANS WHICH SHALL BE THE RESPONSIBILITY OF THE A/E OR THE INSTALLERS.

HEIFER INTERNATIONAL  
LITTLE ROCK, AR

1-A

Revisions:	
Drawn By:	Adam Winbury
Date:	1/25/2006
Scale:	NTS
Supervisor:	David Roberts
Date:	1/25/2006
Job No.:	????
Advanced Cabling Systems 6617 Scott Hamilton Dr. Little Rock, AR 72209 Phone: 501-588-6650 Fax: 501-588-6622 Email: droberts@advancedcablingsystems.com	

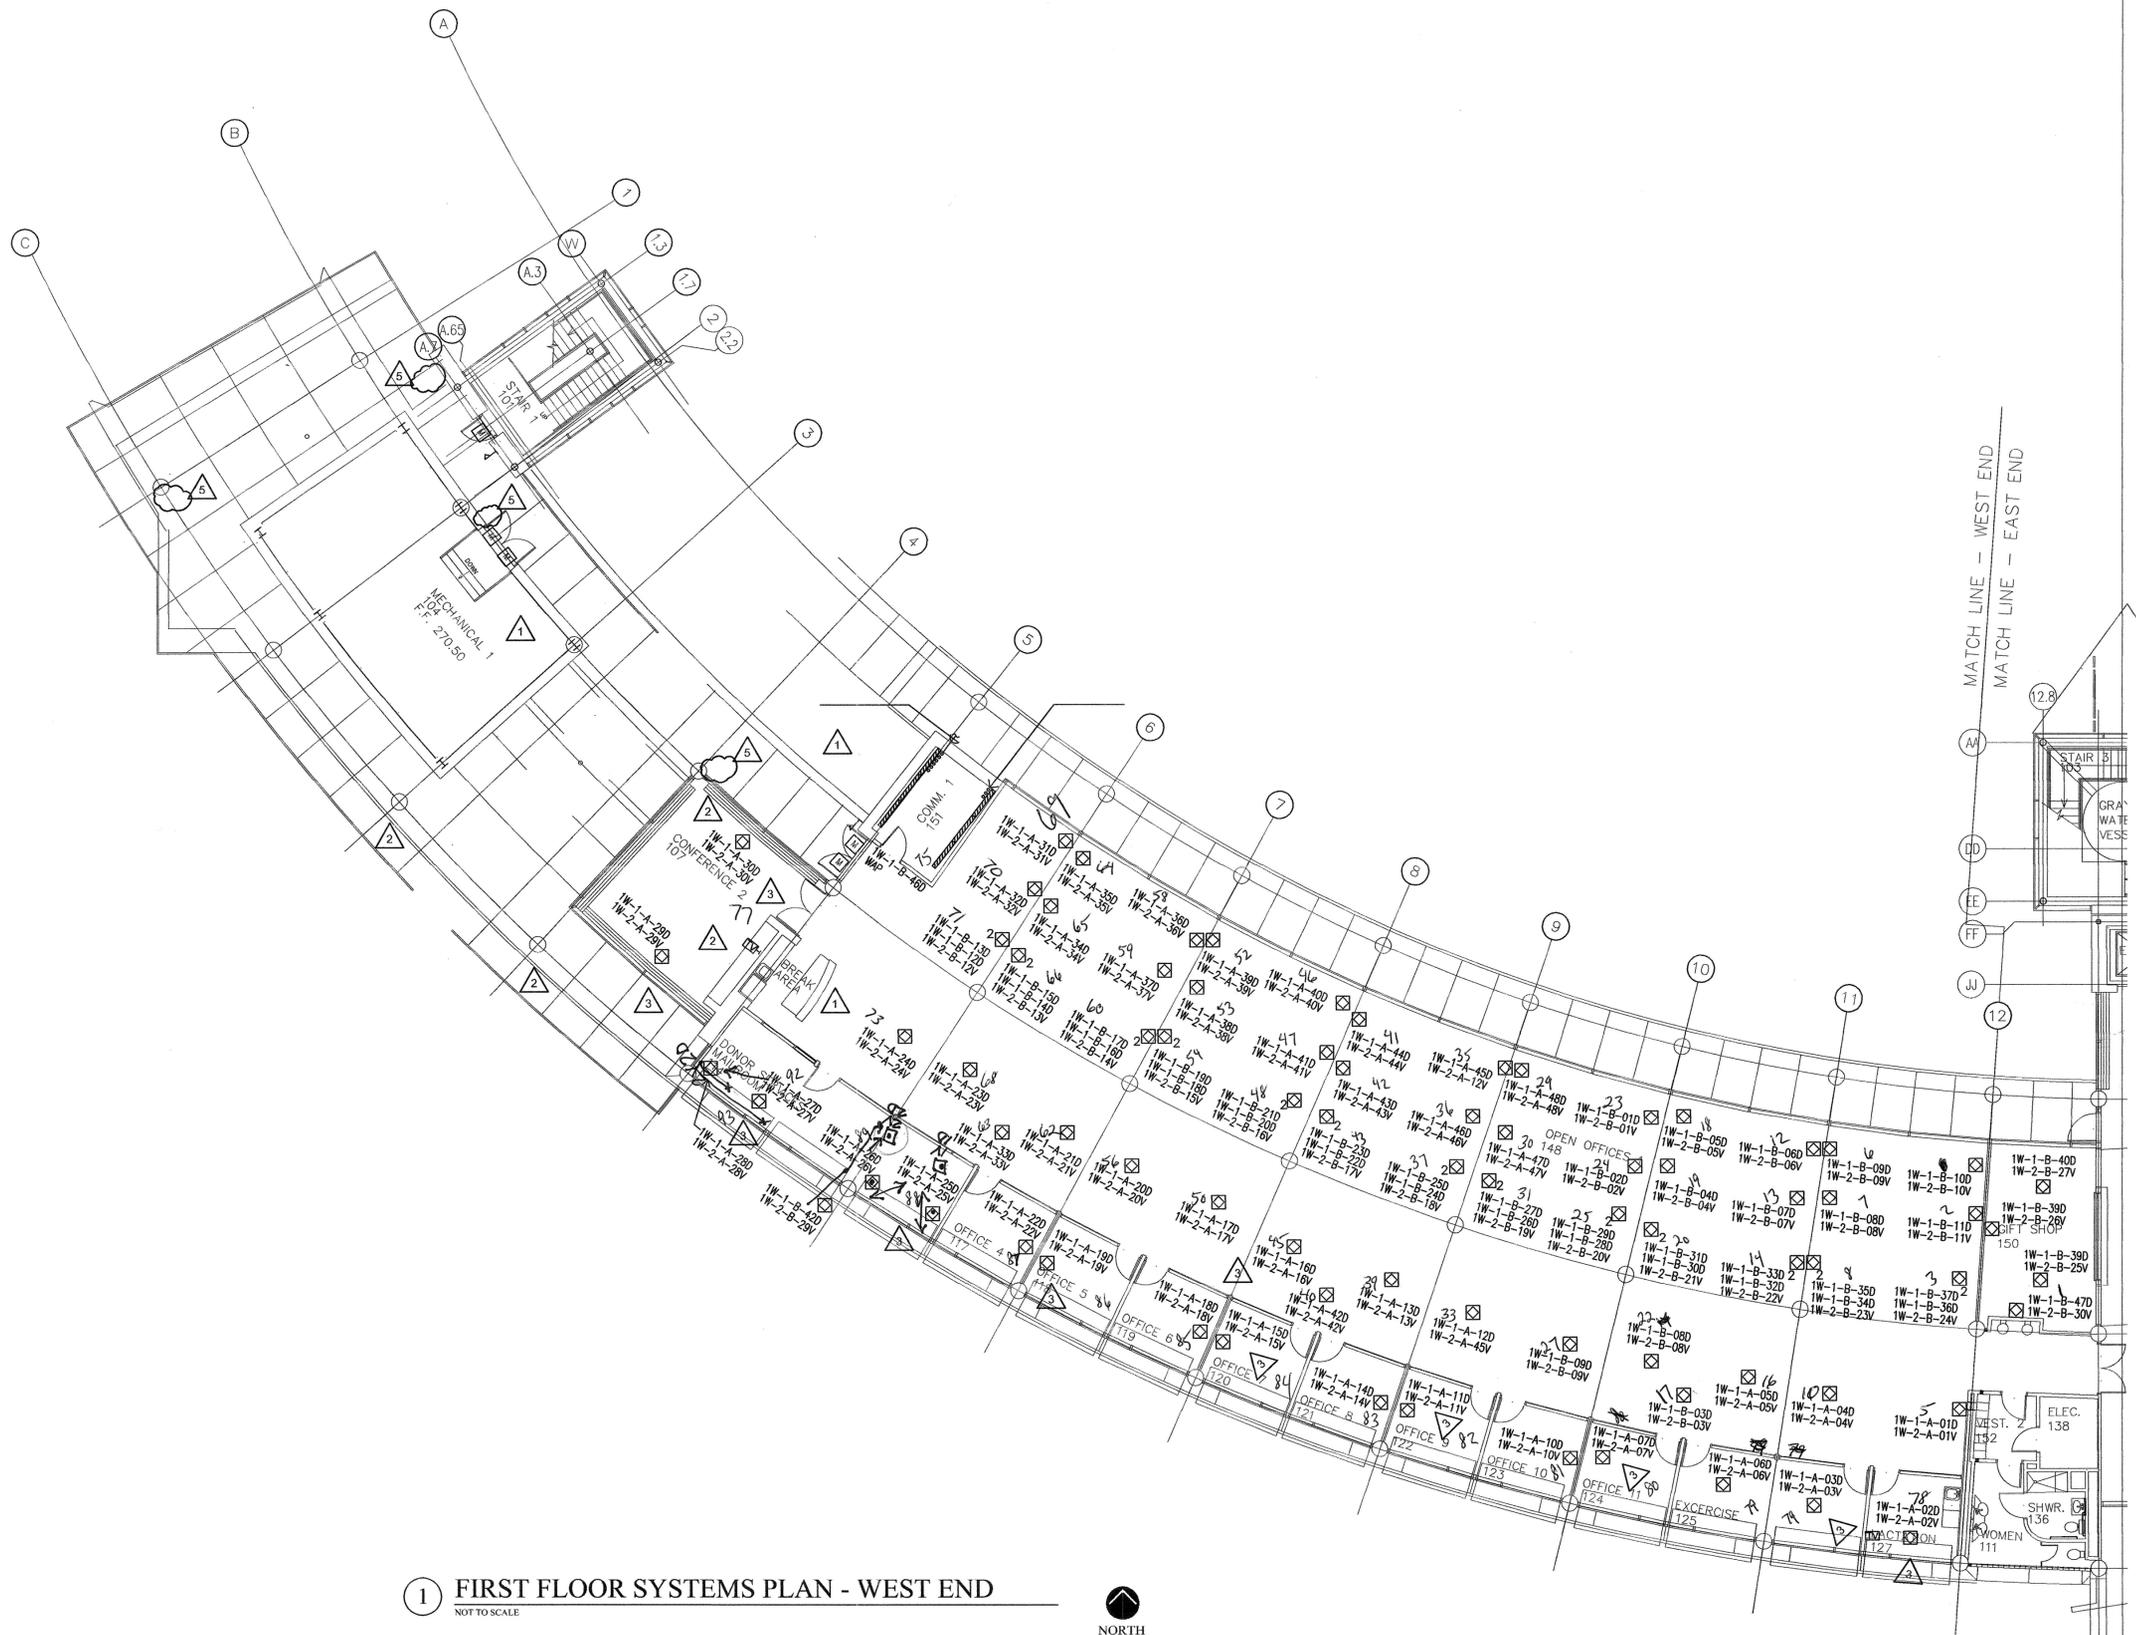

1 FIRST FLOOR SYSTEMS PLAN - WEST END  
NOT TO SCALE



Advanced Cabling Systems Services

NOTE: \*ACS DRAWINGS ARE BASED ON THE PROJECT INFORMATION PROVIDED BY THE ARCHITECT. THE ARCHITECT IS RESPONSIBLE FOR THE TYPE, SIZE, LOCATION, AND OTHER DEVICES SHOWN ON THE PLANS. ACS IS NOT RESPONSIBLE FOR THE INFORMATION SHOWN ON THE AE OR NATIONAL CODES WHICH SHALL BE THE RESPONSIBILITY OF THE AE OR THE INSTALLERS.

HEIFER INTERNATIONAL  
LITTLE ROCK, AR

Sheet Name:

1-B

Revisions:

Drawn By:	Adam Winbury
Date:	1/25/2006
Scale:	NTS
Supervisor:	David Roberts
Date:	1/25/2006
Job No.:	????

Advanced Cabling Systems  
6817 Scott Hamilton Dr.  
Little Rock, AR 72209  
Phone: 501-568-9599  
Fax: 501-568-6422  
Email: droberts@advancedcabling.com



1 THIRD FLOOR SYSTEMS PLAN - WEST END  
NOT TO SCALE



**Advanced Cabling Systems Services**


NOTE:  
\*ACS DRAWINGS ARE BASED ON THE PROJECT ARCHITECTURE AND PLANS AND SPECIFICATIONS. ADVANCED CABLING SYSTEMS IS NOT RESPONSIBLE FOR THE TYPE, SIZE, LOCATION, AND OTHER DEVICES SHOWN ON THE ARCHITECT'S DRAWINGS. DRAWINGS ARE TO SHOW ONLY THE WIRING DIAGRAMS AND NOT THE INFORMATION SHOWN ON THE ARCHITECT'S DRAWINGS. ADVANCED CABLING SYSTEMS SHALL BE RESPONSIBLE FOR THE INFORMATION SHOWN ON THE ARCHITECT'S DRAWINGS WHICH SHALL BE THE RESPONSIBILITY OF THE ARCHITECT OR THE INSTALLERS.

**HEIFER INTERNATIONAL**  
LITTLE ROCK, AR

**3-B**

Drawn By:	Adam Winbury
Date:	1/25/2006
Scale:	NTS
Designer:	David Roberts
Date:	1/25/2006
Job No.:	????

**Advanced Cabling Systems**  
6817 Scott Hamilton Dr.  
Little Rock, AR 72209  
Phone: 501-568-6699  
Fax: 501-568-6422  
Email: droberts@advancedcabling.com

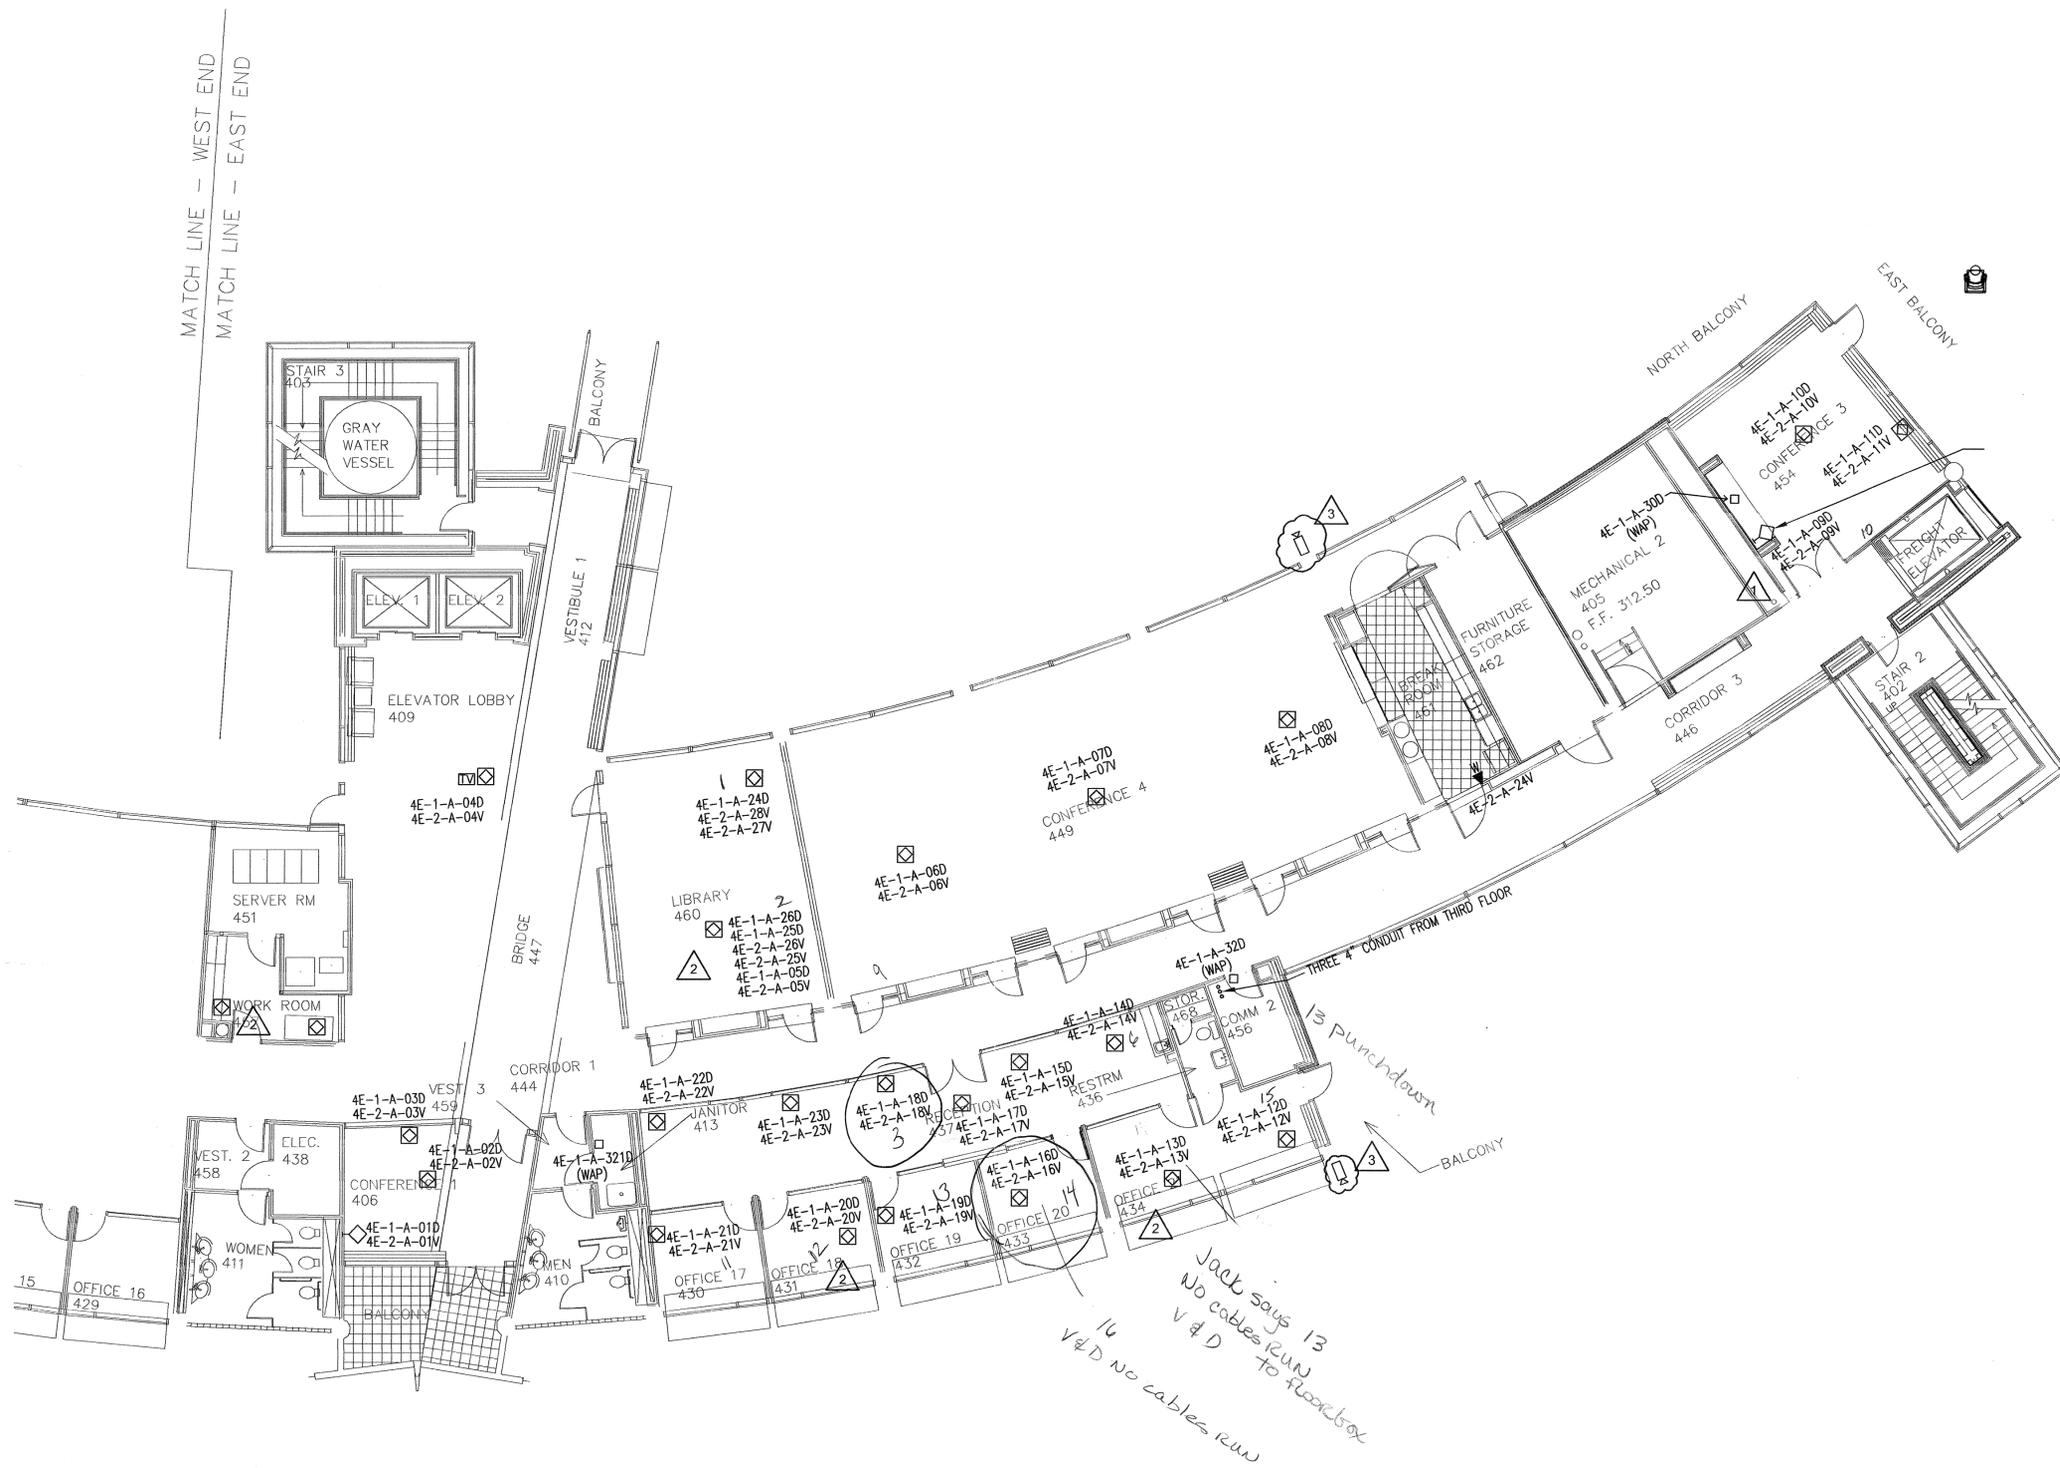

**1** FOURTH FLOOR SYSTEMS PLAN - EAST END  
NOT TO SCALE



**Advanced Cabling Systems Services**

NOTE: DRAWINGS ARE BASED ON THE PROJECT ARCHITECT'S DRAWINGS AND SPECIFICATIONS. ADVANCED CABLING SYSTEMS IS NOT RESPONSIBLE FOR THE TYPE, SIZE, LOCATION AND SUITABILITY OF ALL FIRE ALARMS, CONTROL PANELS AND DEVICES. DRAWINGS ARE TO SHOW ONLY THE WIRING DIAGRAMS. DRAWINGS ARE NOT RESPONSIBLE FOR THE INFORMATION SHOWN ON THE AE PLANS NOR THAT THEY COMPLY WITH LOCAL STATE OR FEDERAL REQUIREMENTS. THE RESPONSIBILITY OF THE AE OR THE INSTALLER.

**HEIFER INTERNATIONAL**

LITTLE ROCK, AR

Revision:

**4-A**

Drawn By:

Adam Winbury

Date:

1/25/2006

Scale:

NTS

Supervisor:


David Roberts

Date:

1/25/2006

Job No.:

Advanced Cabling Systems  
6817 Scott Hamilton Dr.  
Little Rock, AR 72209  
Phone: 501-588-6599  
Fax: 501-588-6422  
Email: droberts@advancedcabling.com

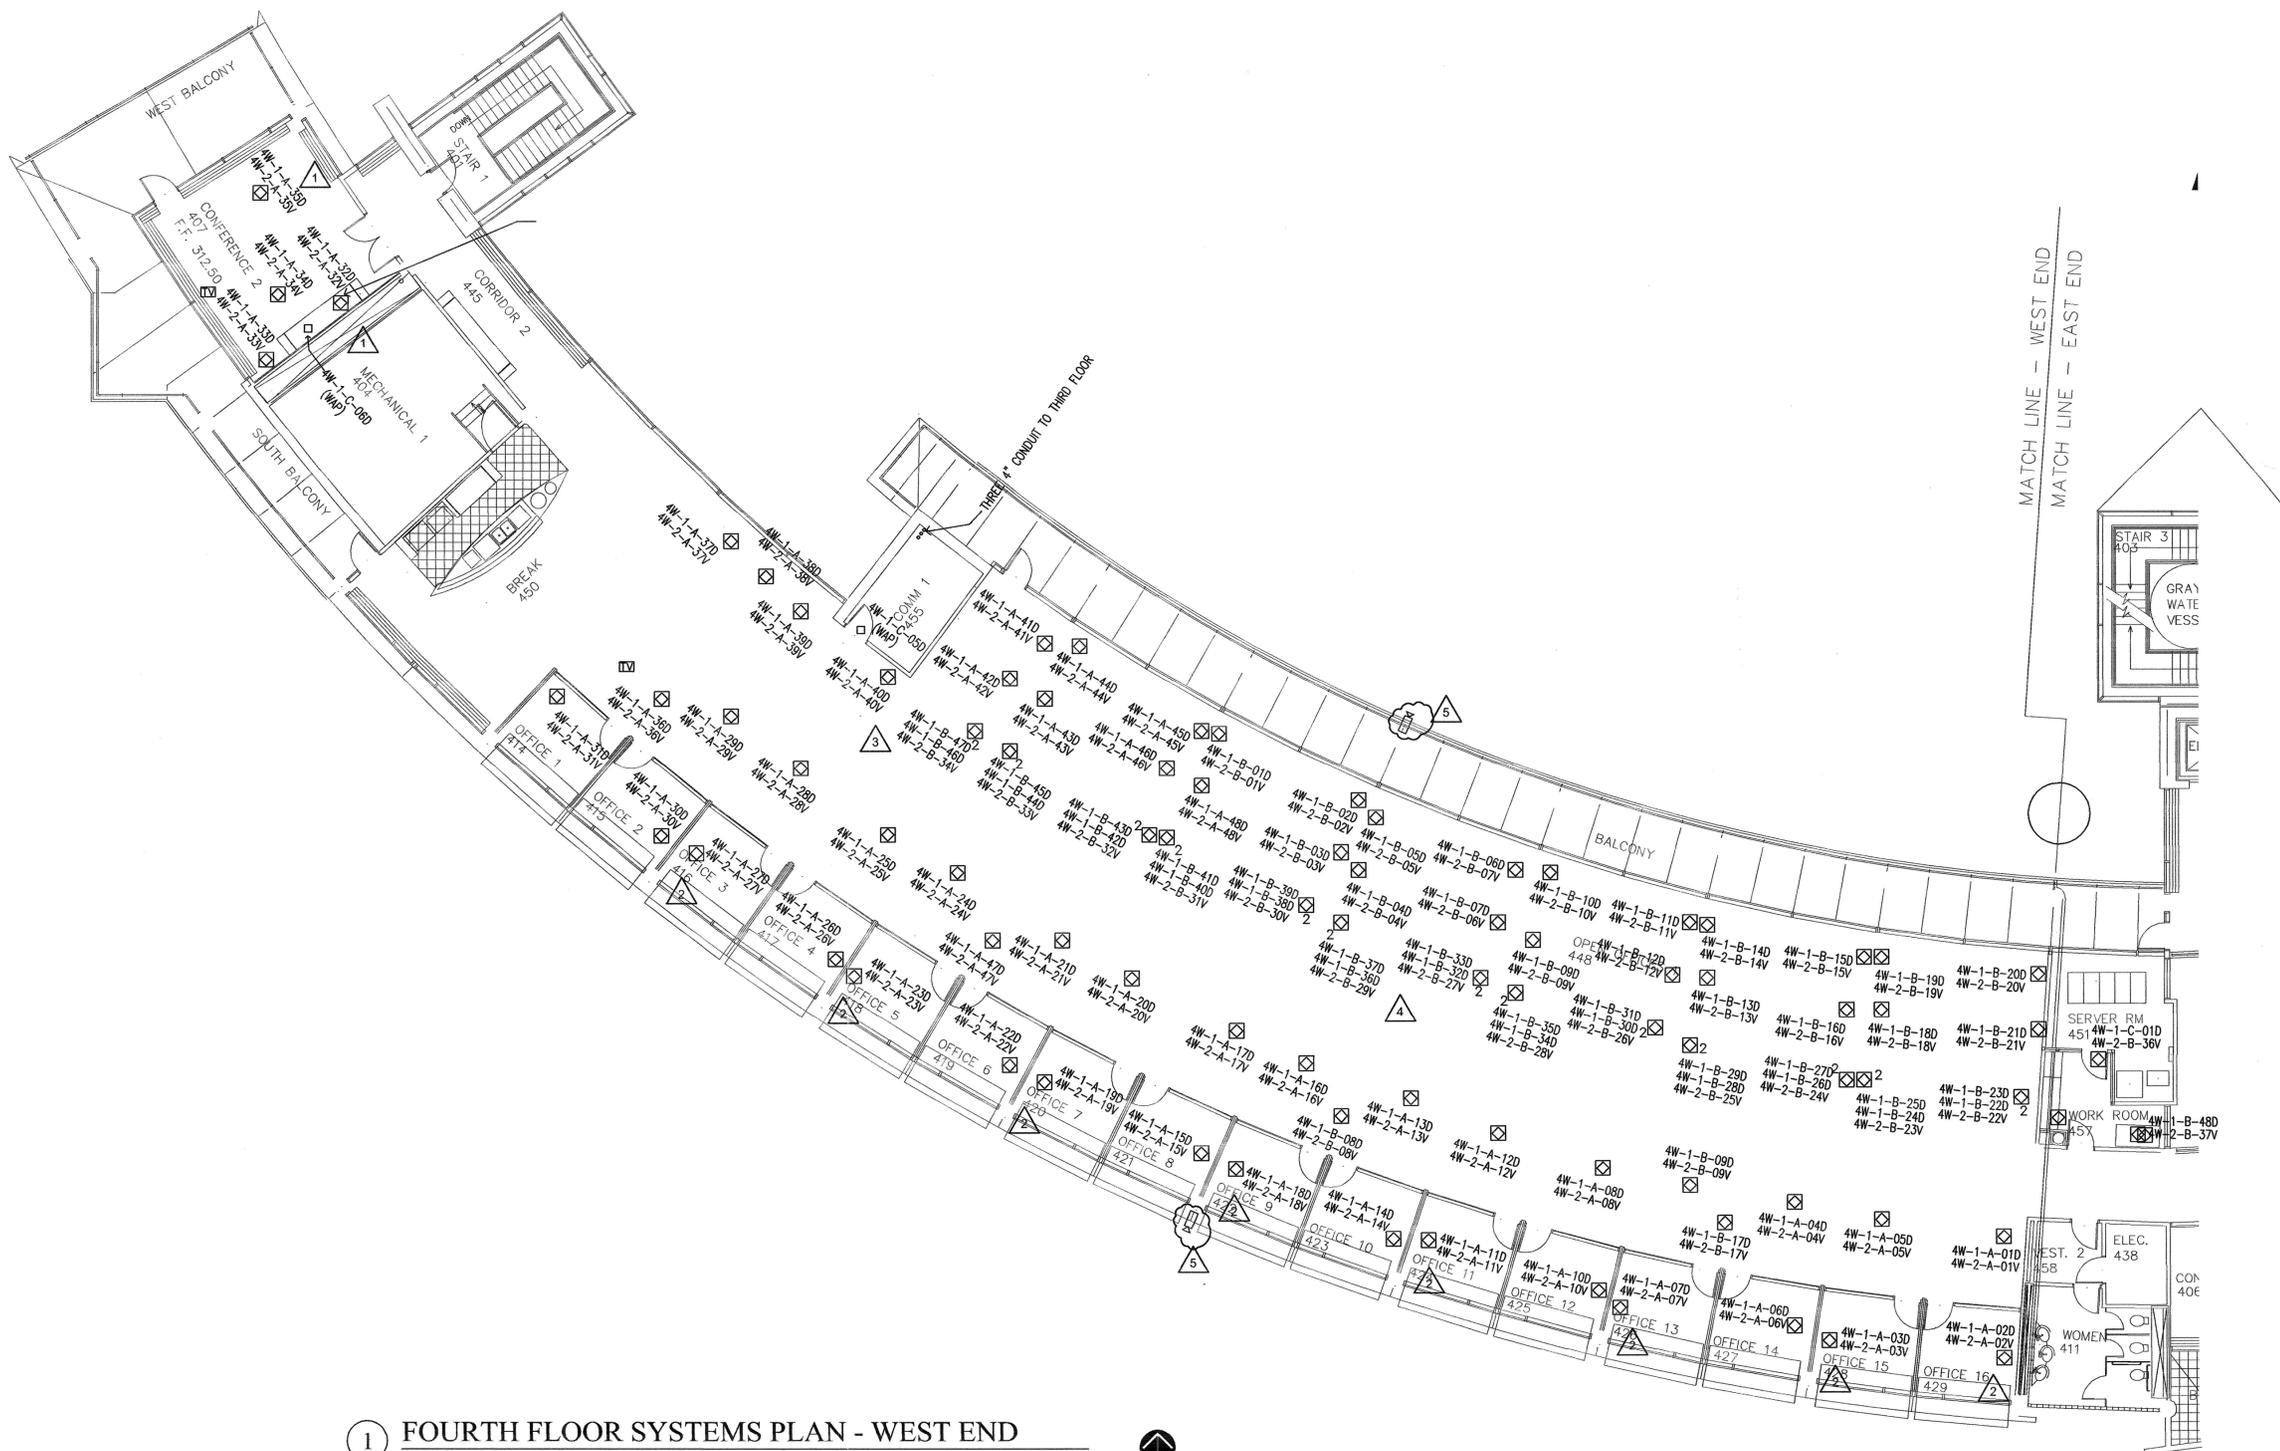

1 FOURTH FLOOR SYSTEMS PLAN - WEST END  
NOT TO SCALE



**Advanced Cabling Systems**  
Little Rock, AR  
501-568-5659  
Springdale, AR  
478-972-8840  
Toll Free  
877-514-8621

**Advanced Cabling Systems Services**

NOTE: \*ACS DRAWINGS ARE BASED ON THE PROJECT ARCHITECT'S DRAWINGS AND SHALL BE USED IN CONJUNCTION WITH THE PROJECT'S ELECTRICAL AND MECHANICAL DRAWINGS. ACS IS NOT RESPONSIBLE FOR THE TYPE, SIZE, LOCATION, OR OTHER DEVICES SHOWN ON THE ARCHITECT'S DRAWINGS. DRAWINGS ARE TO SHOW ONLY THE WIRING DIAGRAMS AND NOT RESPONSIBLE FOR THE INFORMATION SHOWN ON THE ARCHITECT'S DRAWINGS WHICH SHALL BE THE RESPONSIBILITY OF THE ARCHITECT OR THE INSTALLERS.

**HEIFER INTERNATIONAL**  
LITTLE ROCK, AR

**4-B**

Drawn By: Adam Winbury  
Date: 1/25/2006  
Scale: NTS  
Supervisor: David Roberts  
Date: 1/25/2006  
Job No: 7777

**Advanced Cabling Systems**  
6917 South Hamilton Dr.  
Little Rock, AR 72209  
Phone: 501-568-5659  
Fax: 501-568-6422  
Email: drobert@advancedcabling.com