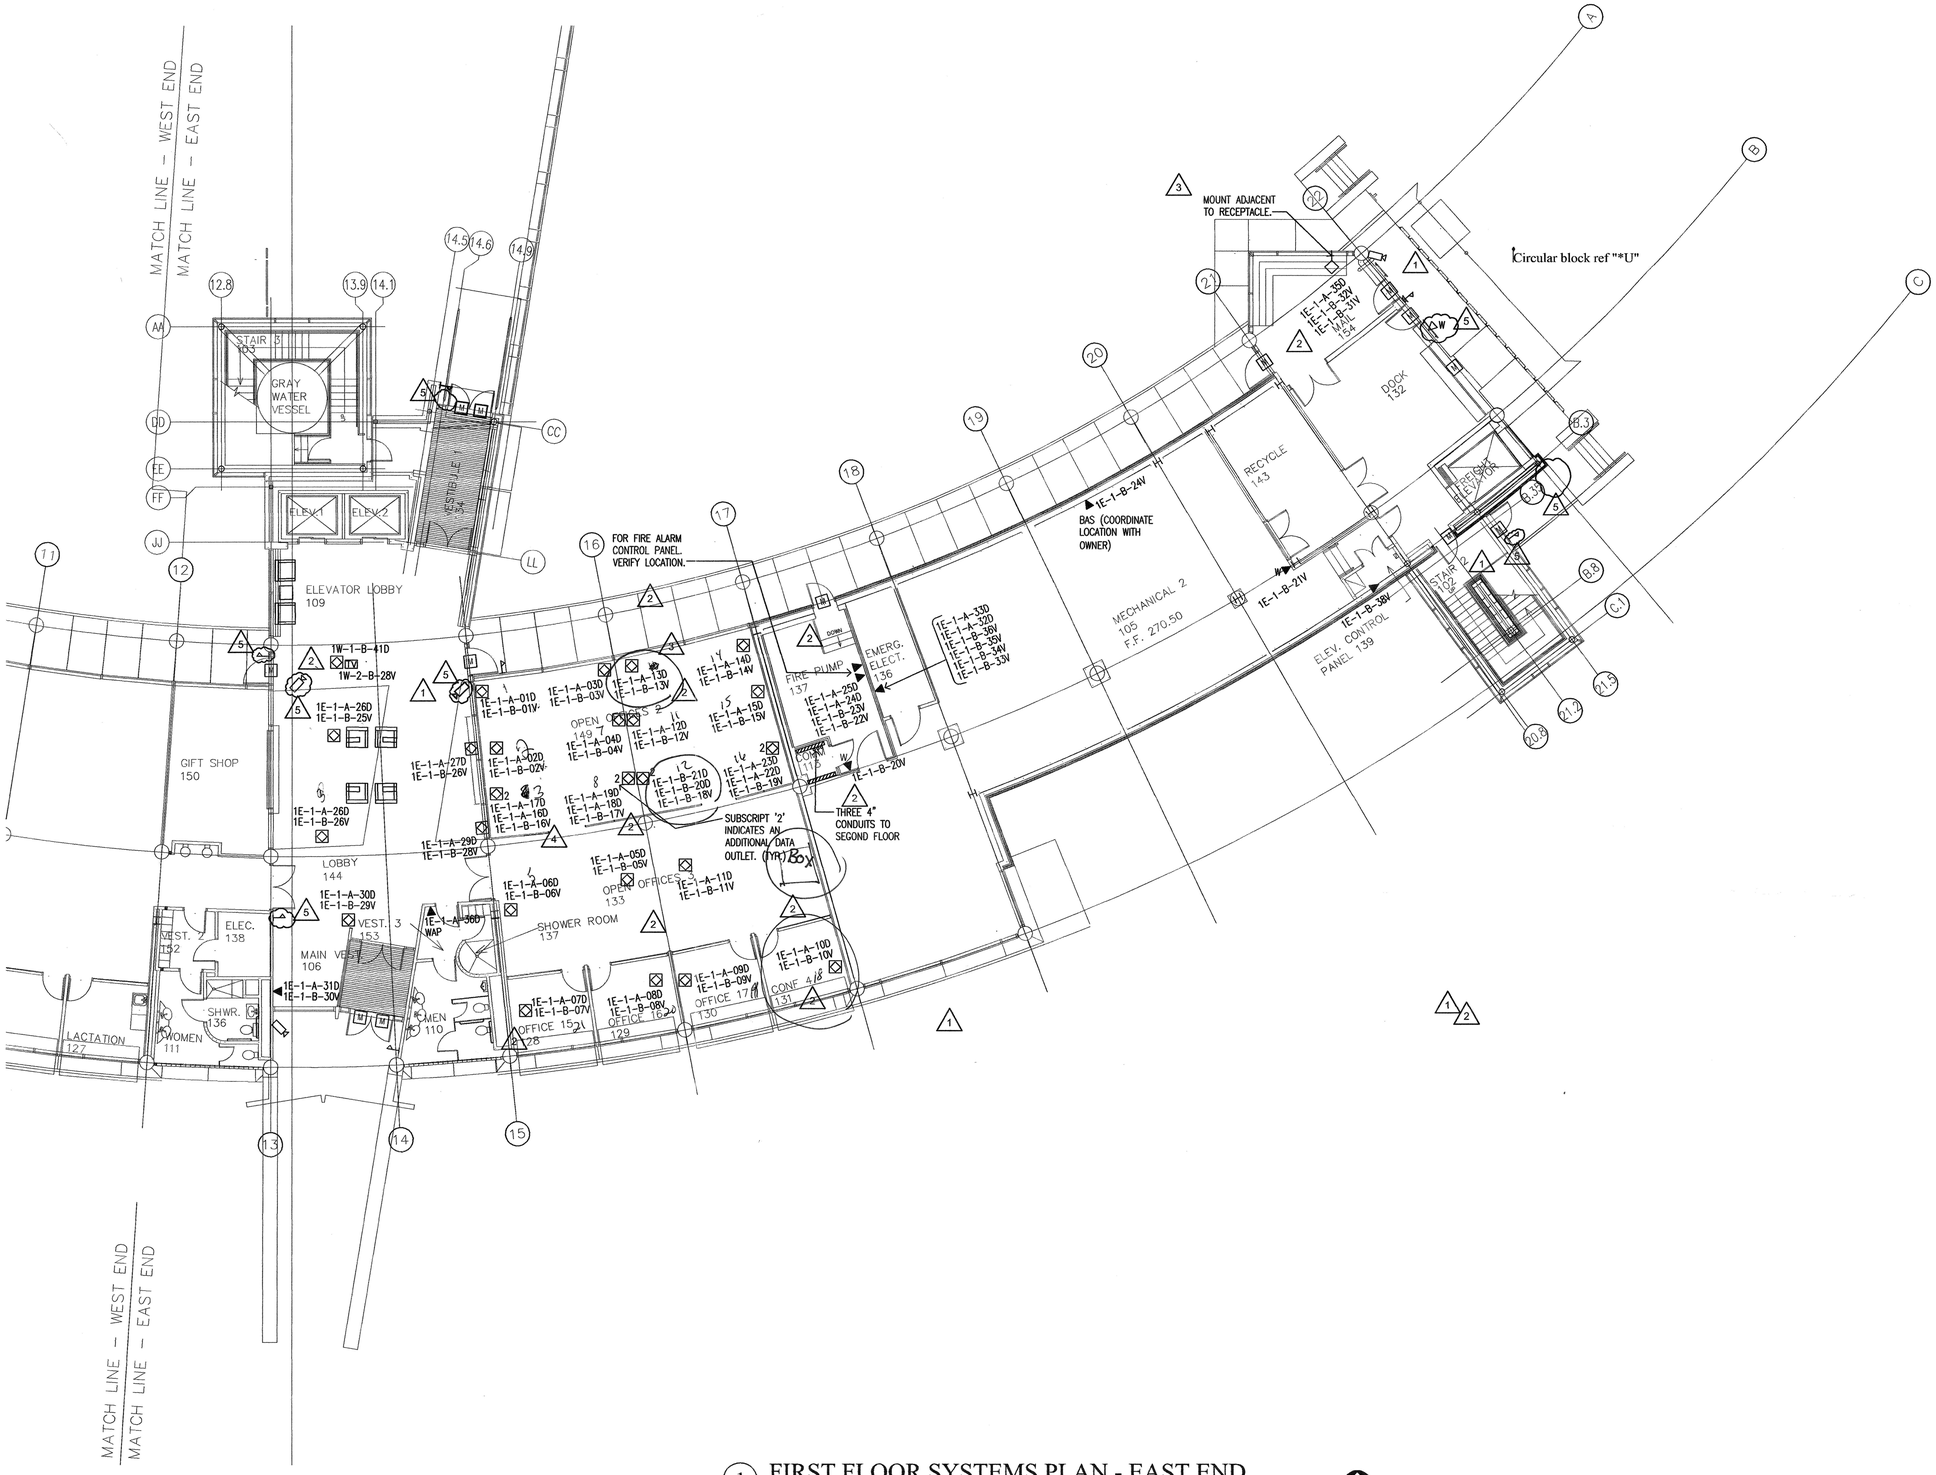

1 FIRST FLOOR SYSTEMS PLAN - EAST END

NOT TO SCALE

NORTH

Advanced Cabling Systems
Advancing Connectivity.
Little Rock, AR.
501-568-6599
Springdale, AR.
479-872-8640
Toll Free
877-814-8621

Advanced Cabling Systems Services

NOTE:
ACS'S DRAWINGS ARE BASED ON THE SPECIFICATIONS PROVIDED BY THE ARCHITECT, ENGINEER (A/E) PLANS AND SPECIFICATIONS (A/E) PLANS FURNISHED TO ACS. A/E IS SOLELY RESPONSIBLE FOR THE ACCURACY, LEVEL, LOCATION, AND SUITABILITY OF ALL FIRE ALARMS CONTROL PANELS AND ALL OTHER EQUIPMENT. ACS'S DRAWINGS ARE BASED ON A/E'S DRAWINGS ARE TO SHOW ONLY THE WIRING DIAGRAMS BETWEEN FIRE ALARMS AND CONTROL PANELS. ACS IS NOT RESPONSIBLE FOR THE ACCURACY OF THE DRAWINGS. THE A/E PLANS NOR THAT IT COMPLIES WITH LOCAL, STATE OR NATIONAL CODES. ACS WILL NOT BE THE RESPONSIBILITY OF THE A/E OR THE INSTALLERS.

Drawing Name:

HEIFER INTERNATIONAL

LITTLE ROCK, AR.

Sheet Name:

1-A

Revisions:

Drawn By:	Adam Winbury
Date:	1/25/2006
Scale:	NTS
Salesperson:	David Roberts
Date:	1/25/2006
Job No.	????

Advanced Cabling Systems
6817 Scott Hamilton Dr.
Little Rock, AR 72209
Phone: 501-568-6599
Fax: 501-568-6422
Email: droberts@advancedcablingsystems.com